23/12/73

16.41 = ½ Breath
29.5 = ½ Girth
17.67 = Depth
63.58 = Number
228.71 = Length
14541.38 = Number

Above 12 and not exceeding 13 depths in length

MIDSHIP SECTION OF AN IRON SCREW STEAMER

DIMENSIONS

LENGTH OVERALL	238' 9"
Do B. P.	230' 0"
BREADTH	32' 10"
DEPTH IN HOLD	16' 2" & 22' 11"
Do MOULDED	17' 0" & 23' 9"

CLASS 90 A.

SPARDECKED.

5 Waterlight Bulkheads
Bulkhead plates - 6/16"
Do angles 3" x 3" x 3/8"
Do fitted between double frames
Rudder at Head — 5½"
" — " Heel — 3
Screw frame — 8⅞" x 4"
Lenght of Fore Ballast Tank 50'
" — " after — " 36' 8"

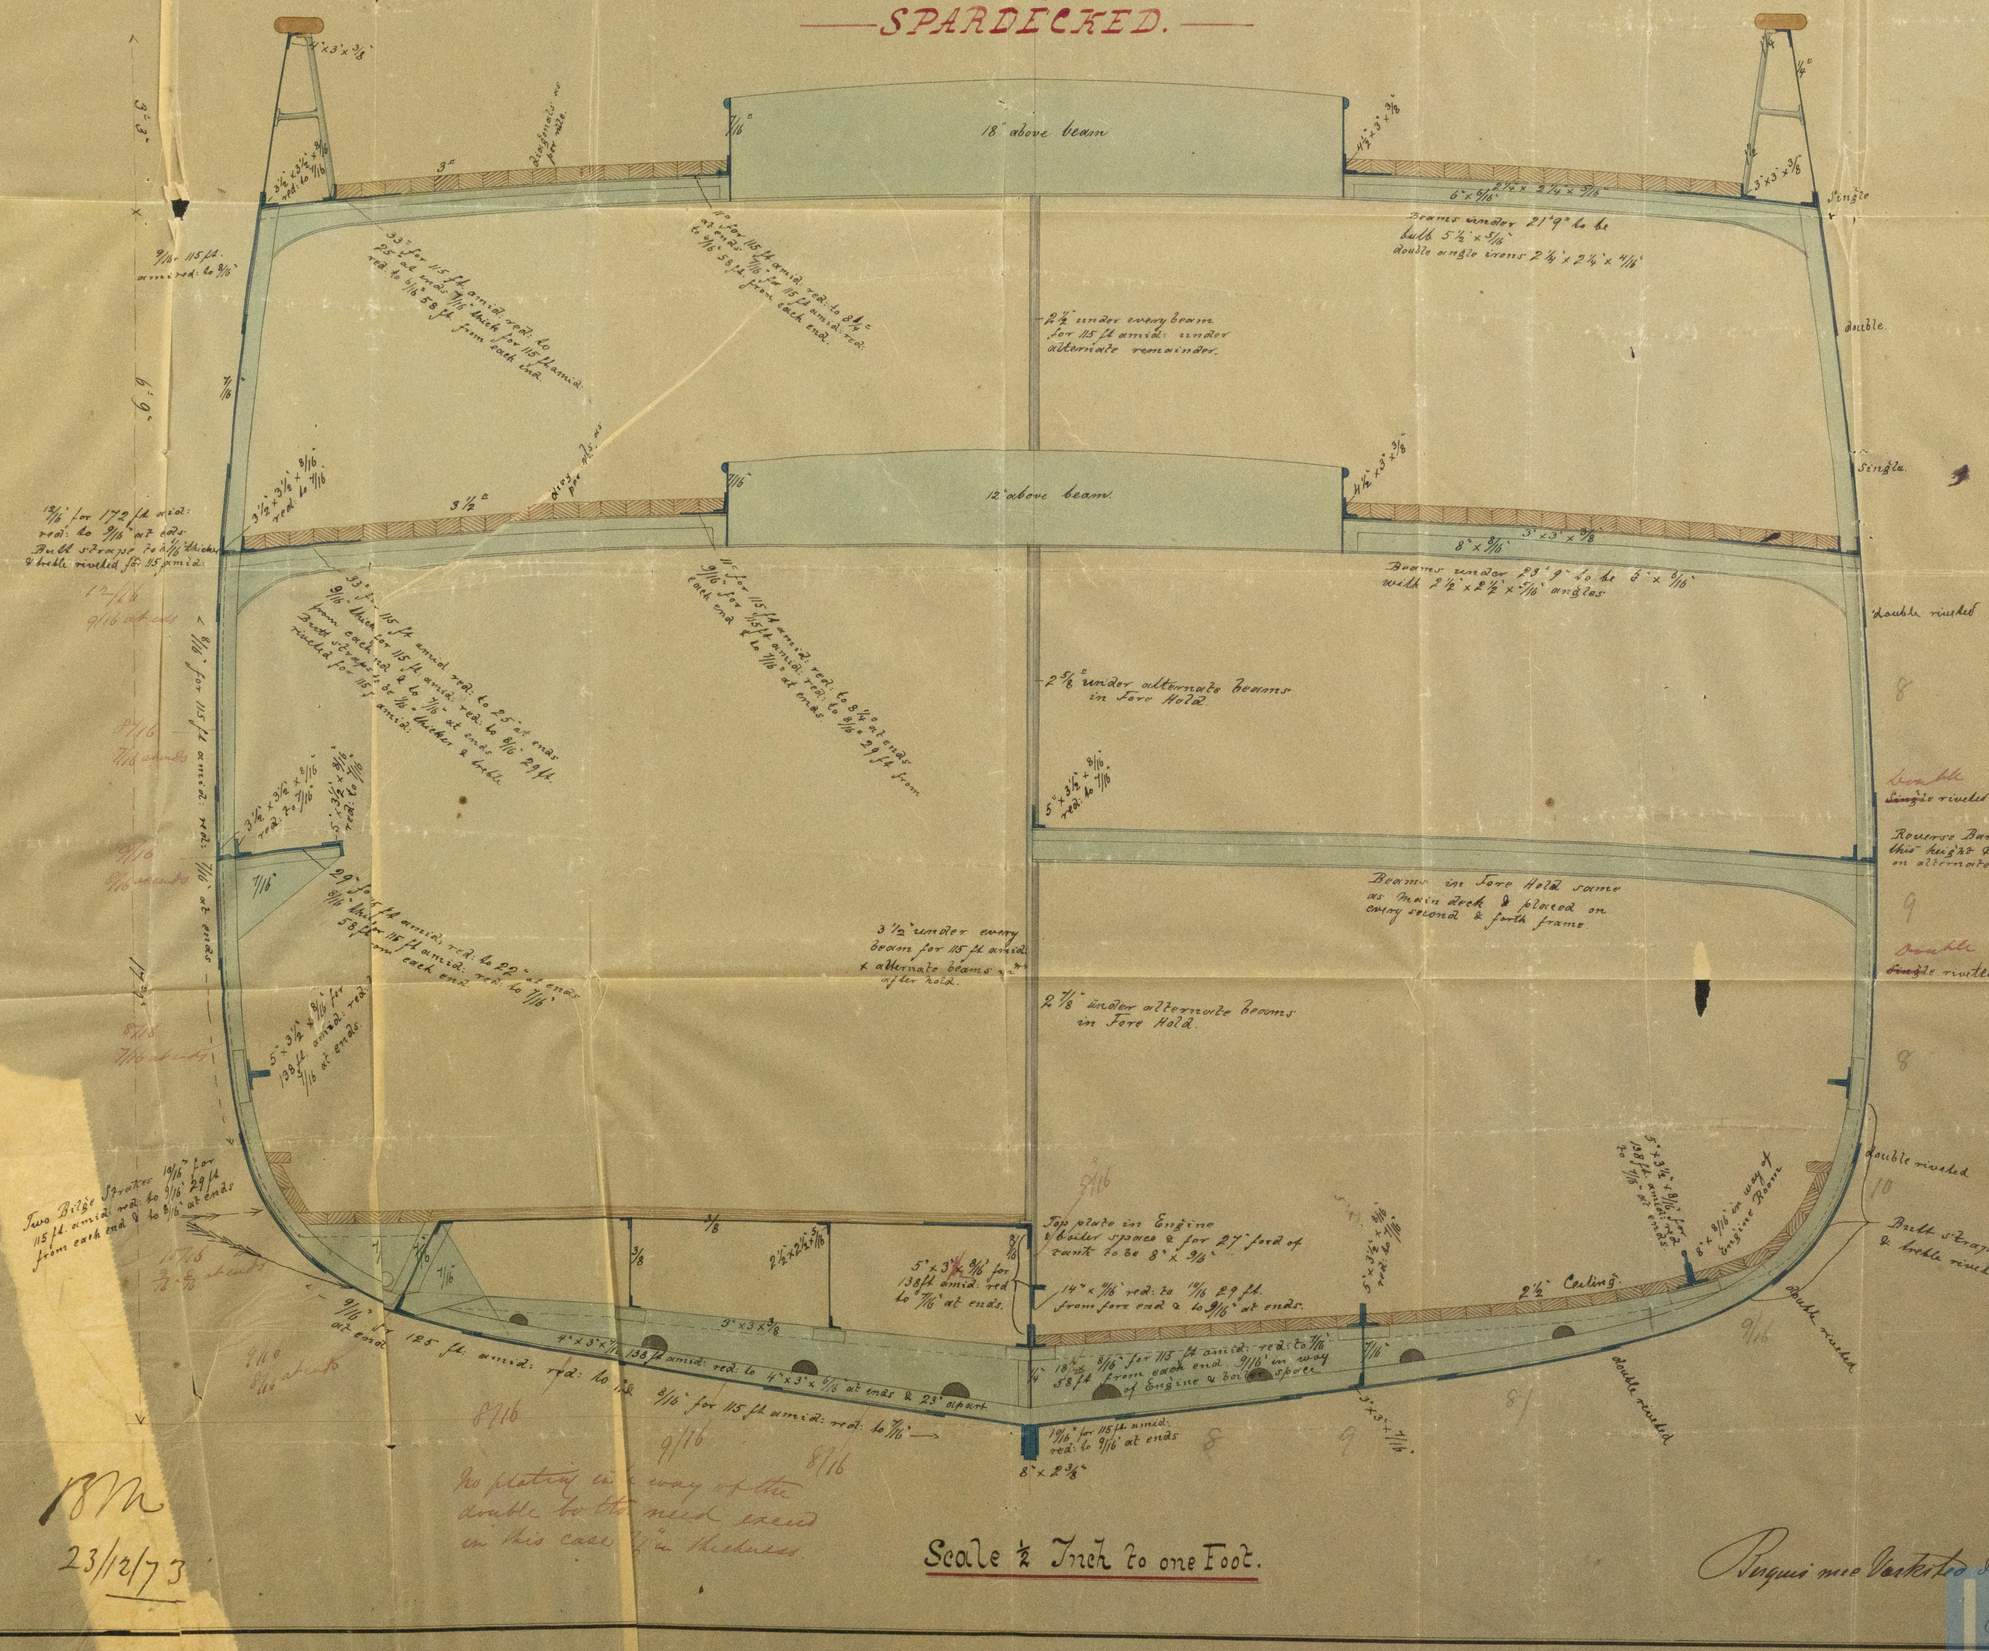

Scale ½ Inch to one Foot.

Perquis mee Vastested den 20de November 73
Bang

18M
23/12/73

No plating in the way of the double bottom need exceed in this case ½" in thickness

© 2021 Lloyd's Register Foundation
IRON 510-197