


MIDSHIP SECTION

Barque N^o 72

Classed 100 A.1. at Lloyds

	Fe ^t ins.
Length	168. 10
Breadth Moulded	29. 0
Half Breadth.	14. 6
Depth of Keel to top of Beam Amids	20. 3½
Half Midship Birth & Stringer	30. 0
1 st Rumeral	64. 9½ = 64. 79
2 nd "	109 38. 9
Equipment "	120 32. 7
Breadth in length	5. 8
Depths	8. 2
Stem $\frac{1}{2} \times 2\frac{1}{4}$ Stern Post $\frac{1}{2} \times 2\frac{1}{4}$ Keel $\frac{1}{2} \times 2\frac{1}{4}$	

Stern $\frac{7}{8} \times 2\frac{1}{4}$ Stern Post $\frac{7}{8} \times 2\frac{1}{4}$ Keel $\frac{7}{8} \times 2\frac{1}{4}$

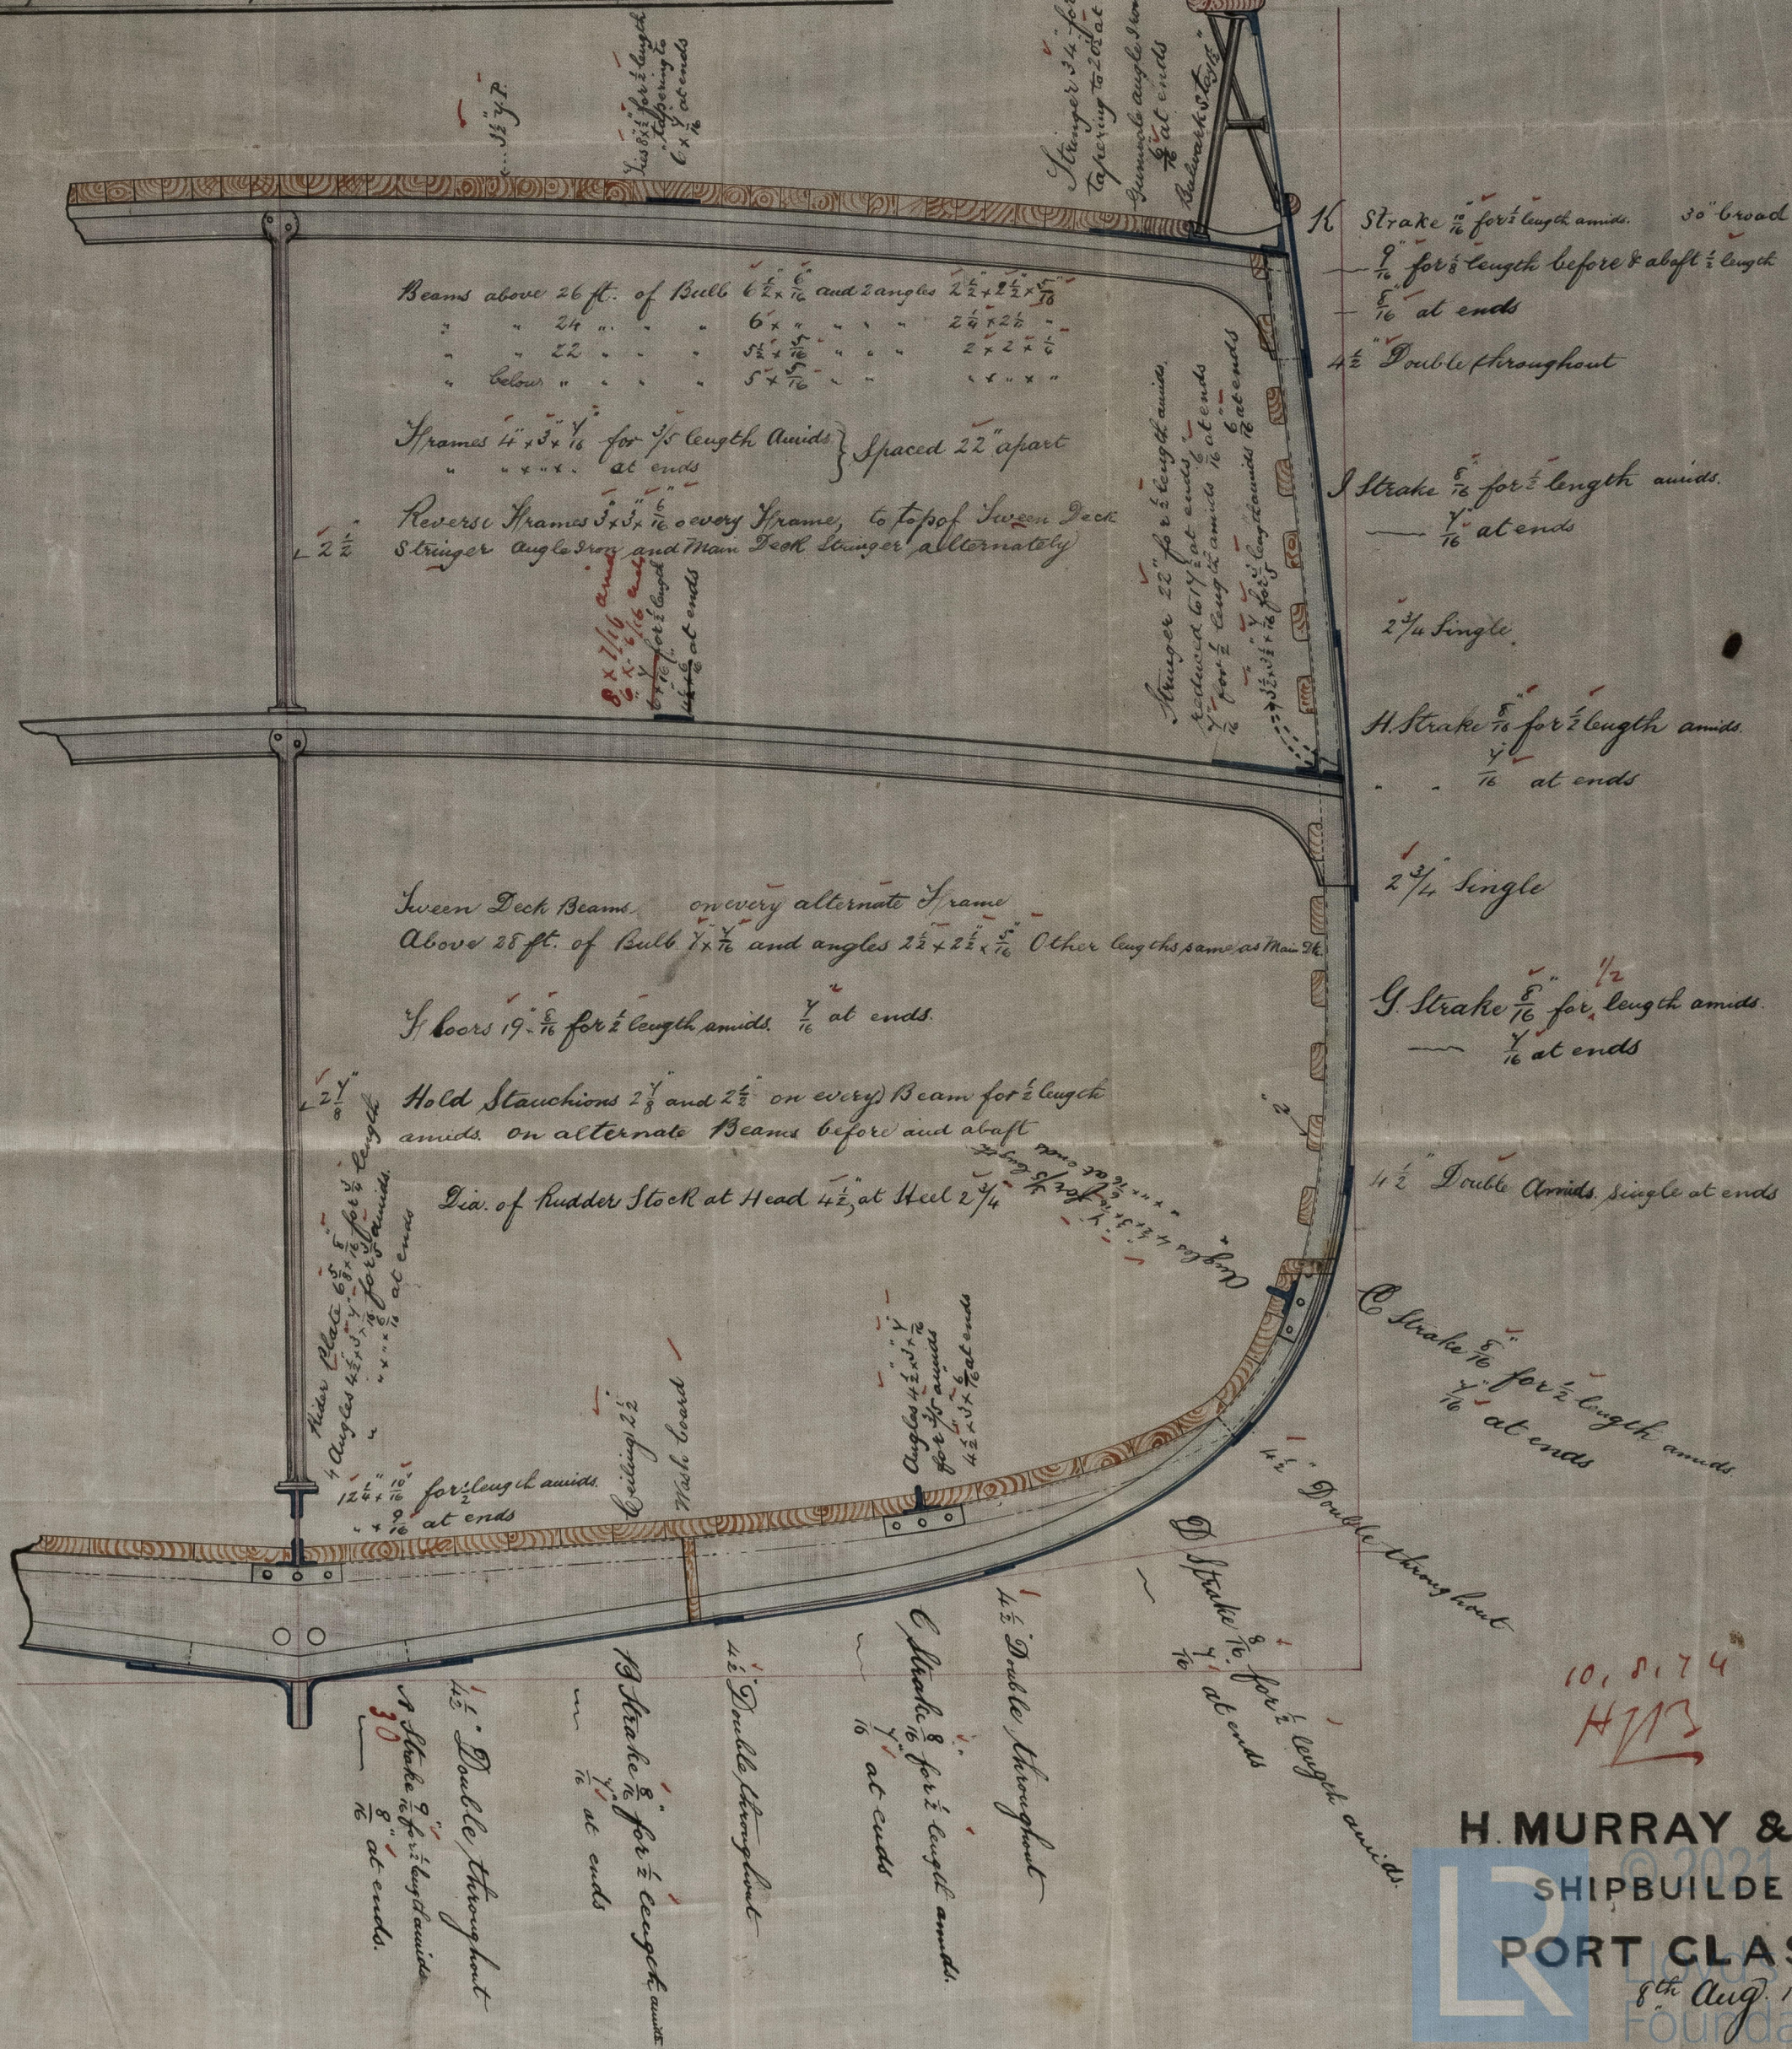

H. MURRAY & CO.
SHIPBUILDERS.

PORT CLASCOW

8th Aug. 1874