


No 49 S.S.
Scale $\frac{1}{2}$ " = 1 foot

Length B. P	220 - 0
Breadth extreme	29 - 0
- " - moulded	28 - 10
Depth - "	16 - 11½
- " in hold to floors	16 - 6
Rise of beam	1 - 0

Class 90A—

Rec 573/74

10.3.74

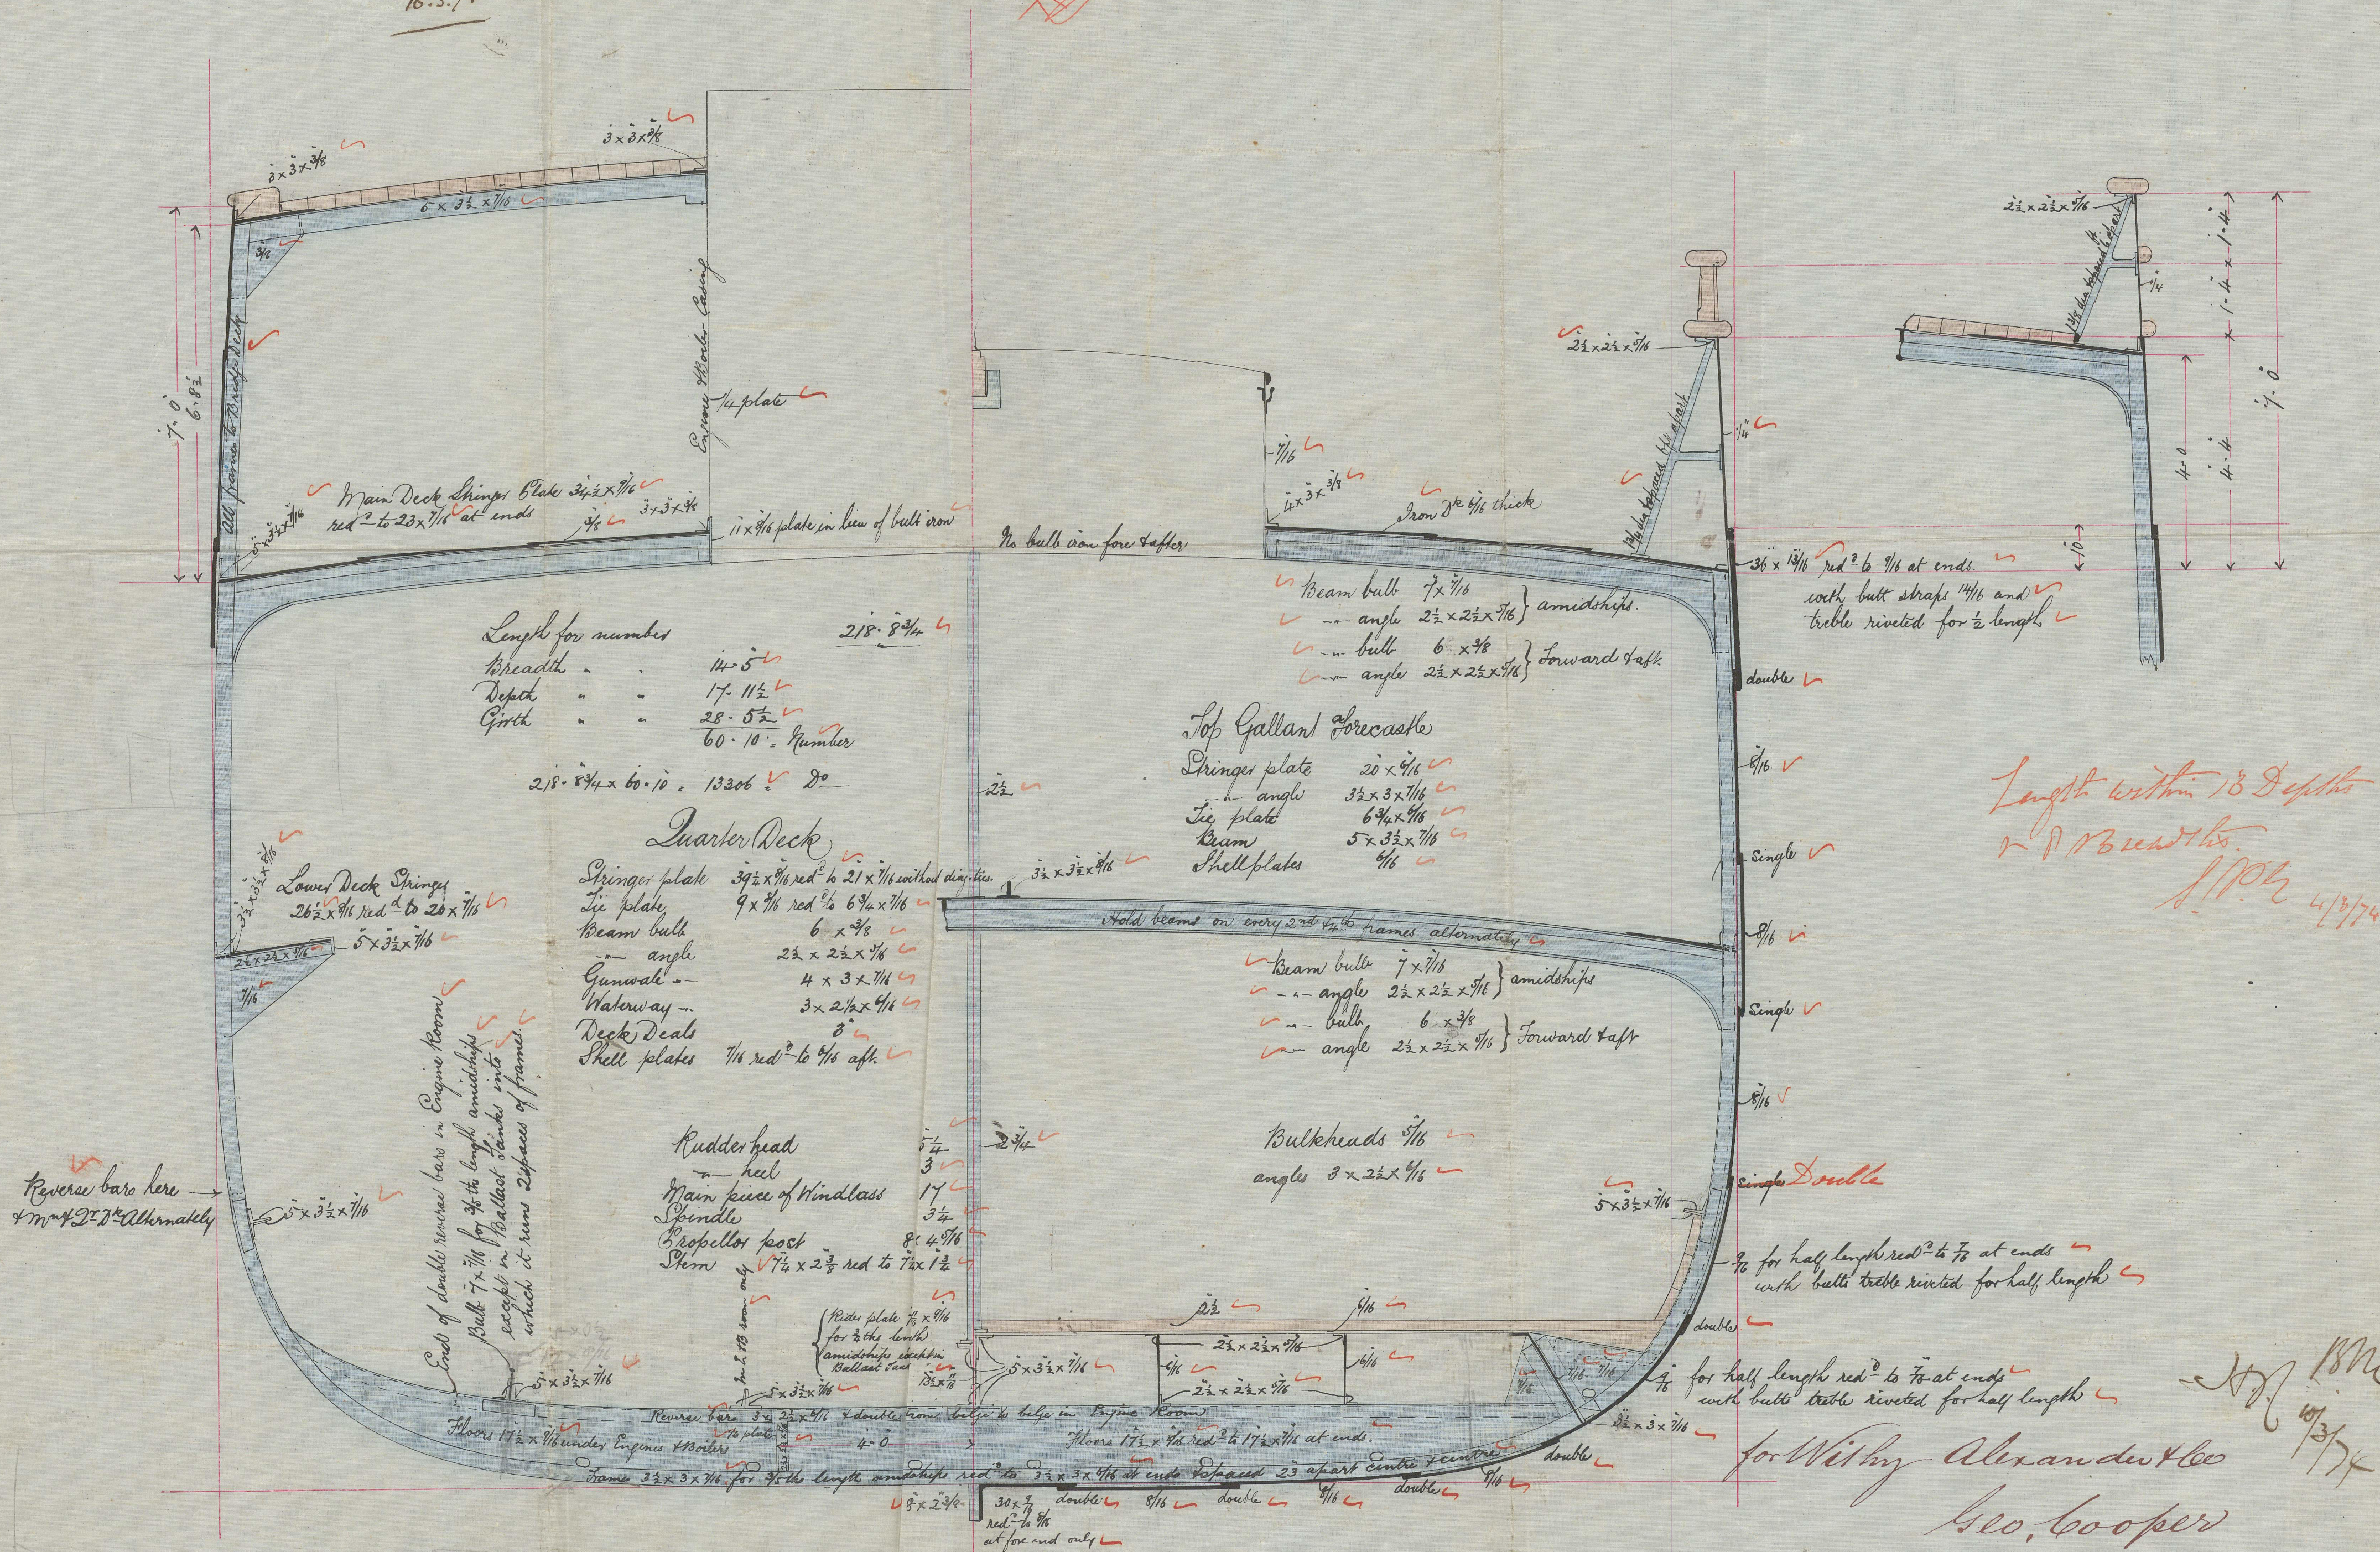


for Wm. Alexander & Co
Geo. Cooper