

S.S. HAYEA

Glasgow Report No 3971

CLASS 100 A

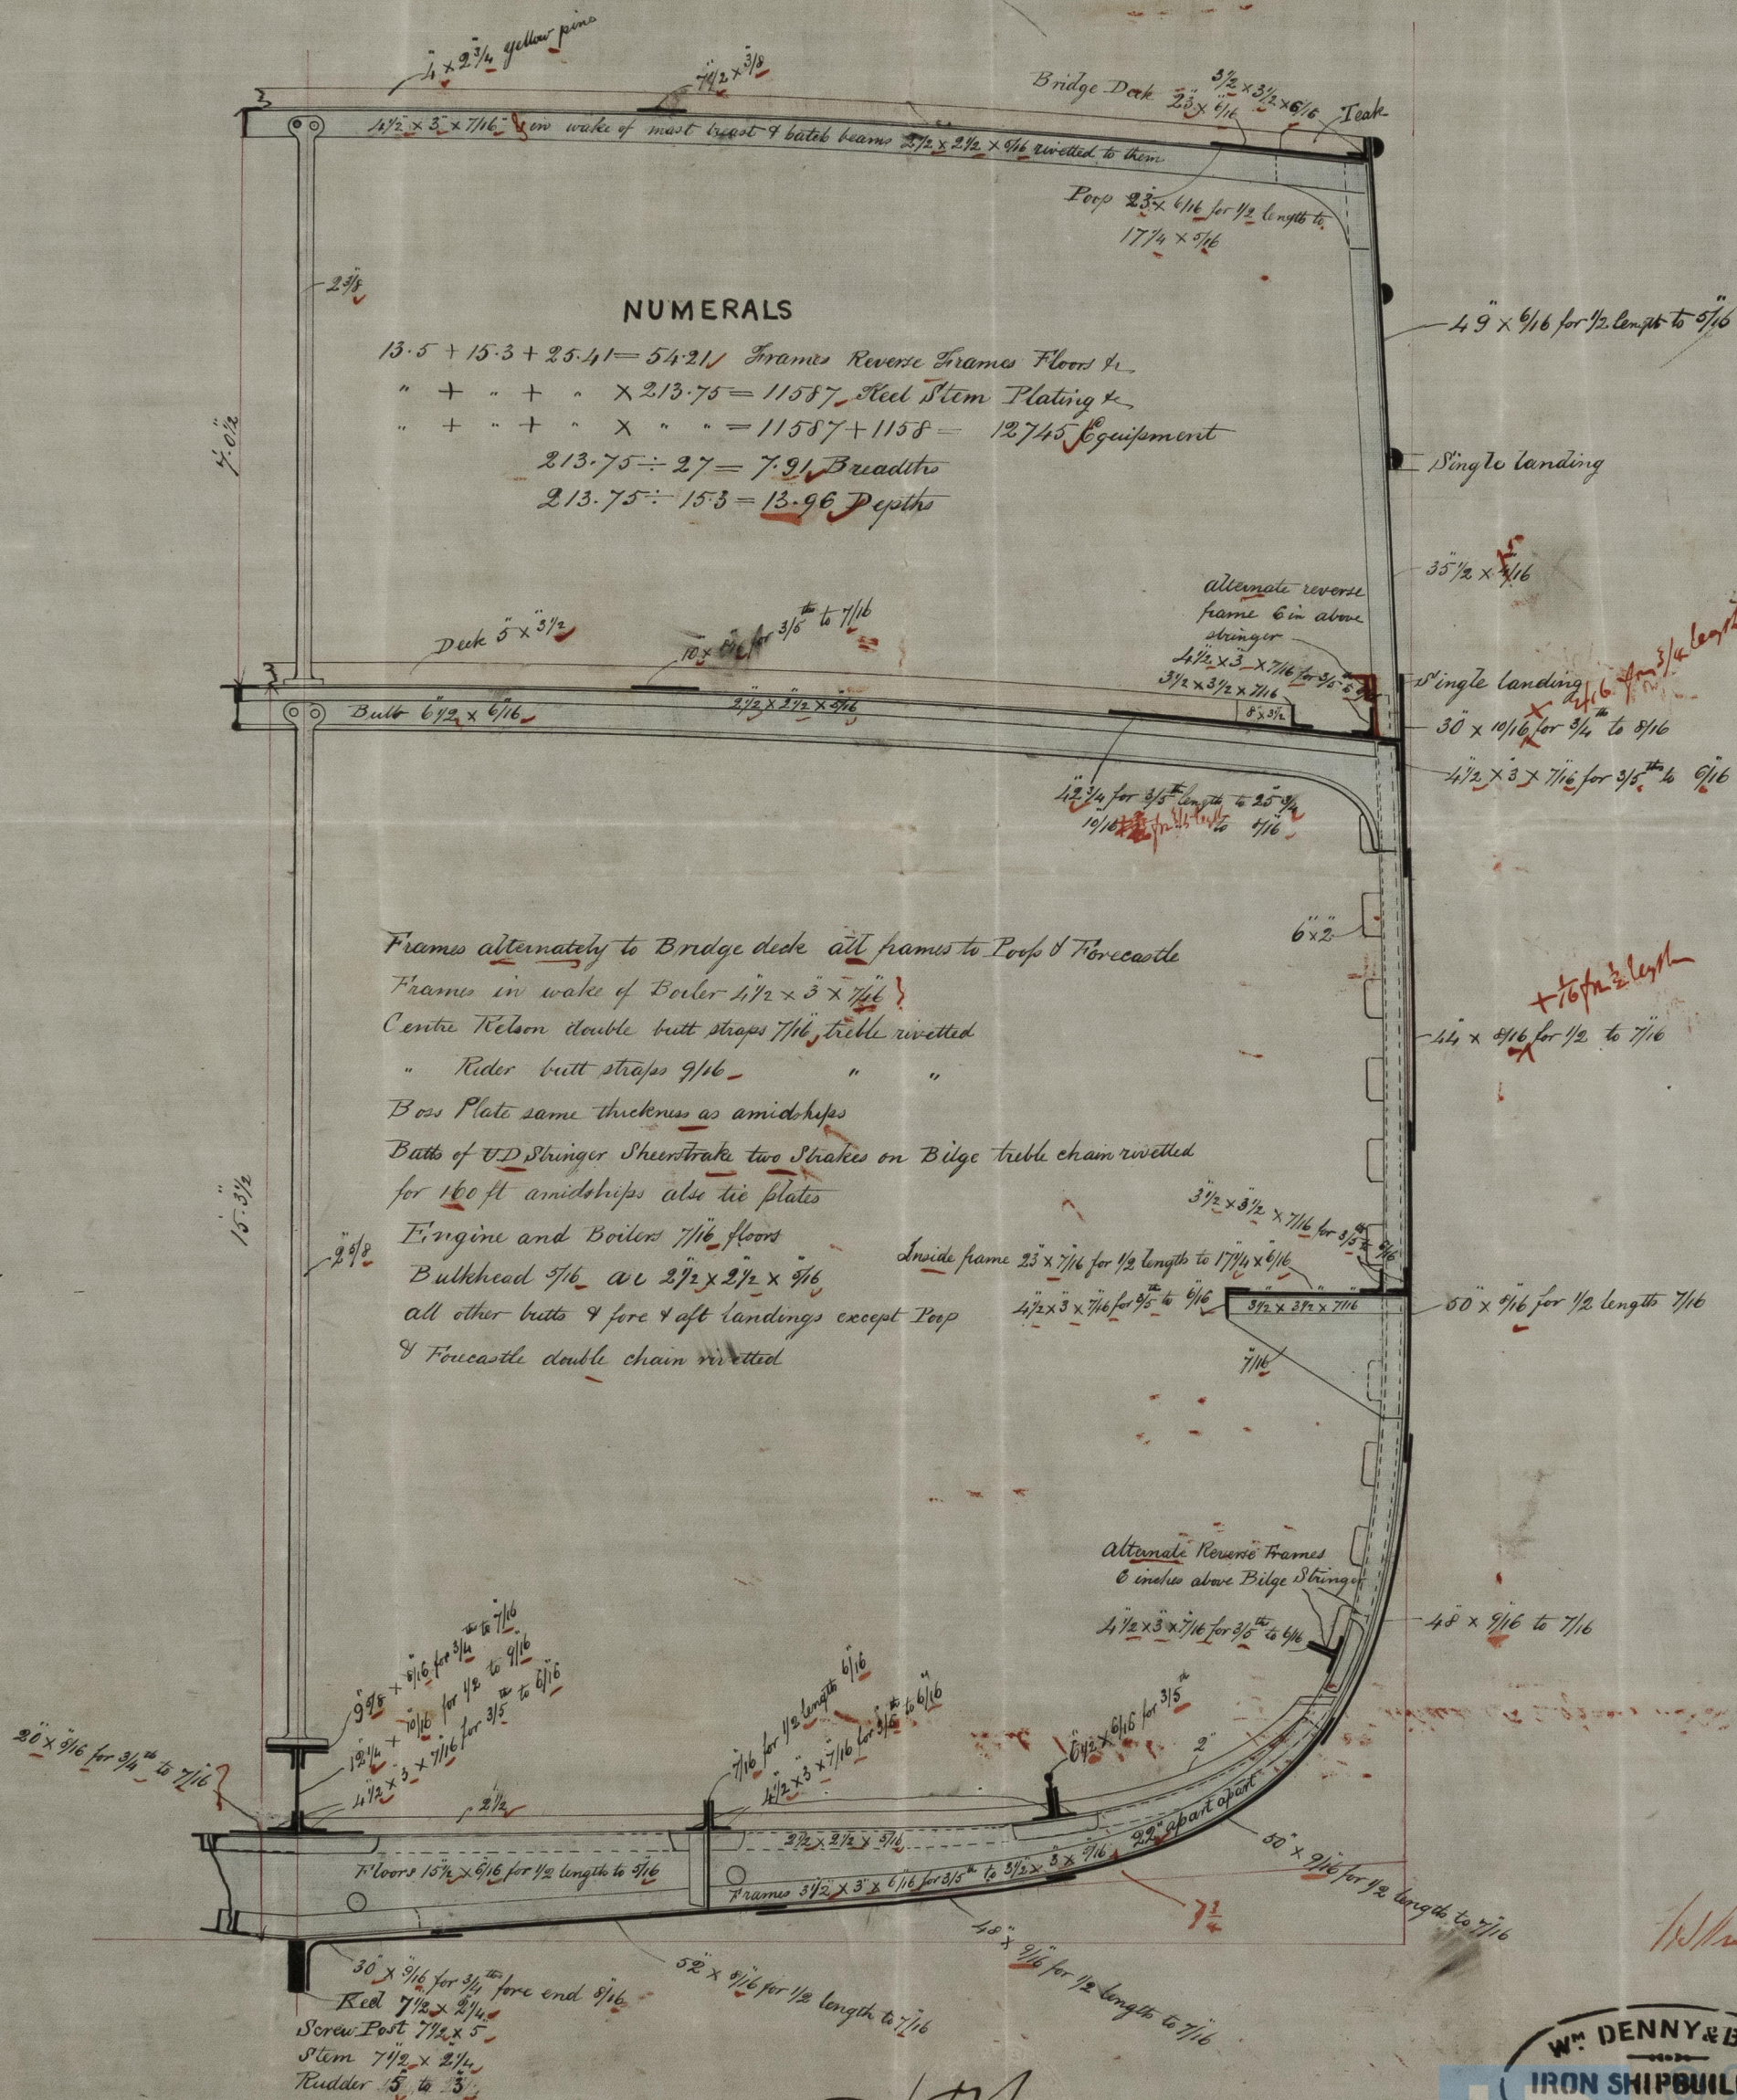
Prop 73 ft Deck house 60 ft Forecastle 40 ft

Total 120 feet.

213. 75

181 0 2

12.75

[illegible]

11. 7. 74

1577/74

WM. DENNY & BROS
IRON SHIPBUILDERS

Lloyd's Register
Foundation

120511-0027