


S.S. "RAJANATTIANUNAR"

Glasgow Report No. 14003

243 x 31.6 x 13.6

Nº 183. spar decked screw steamer

Rec 12/8/74

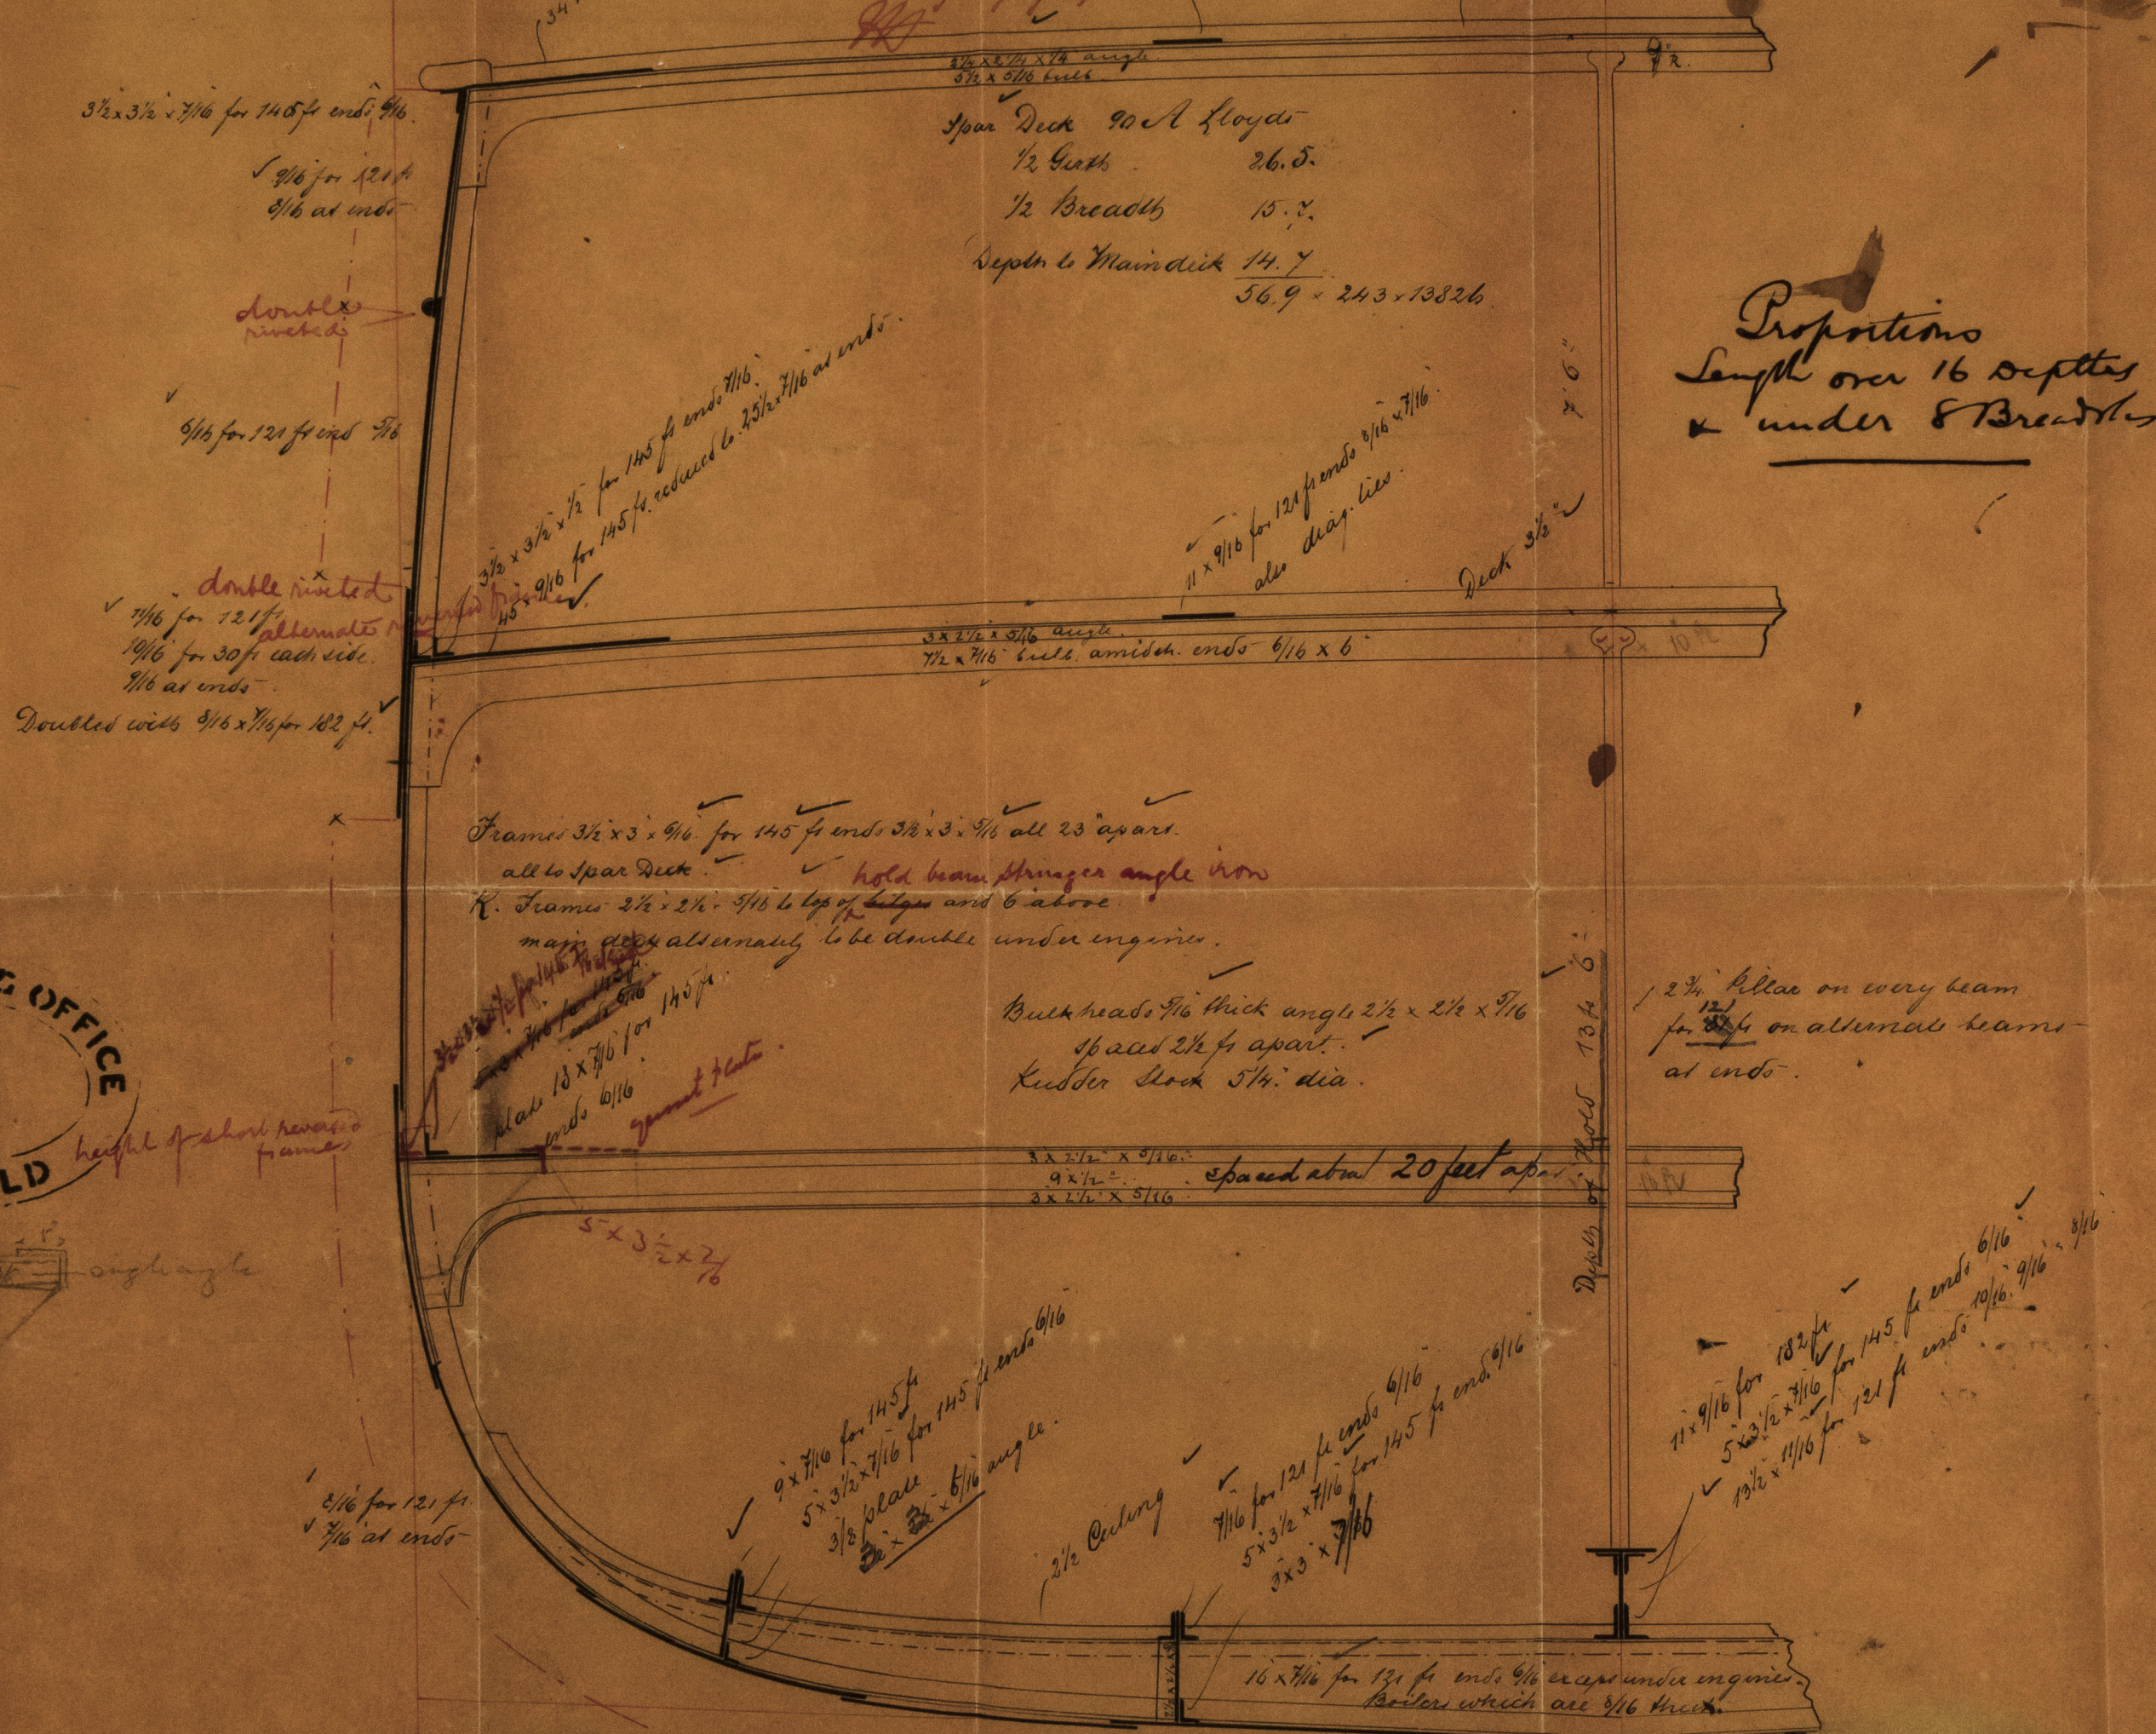

Rivetting Bulk Heads of Spar & Main Deck, Thrusts and Runners & 3 Bilge Beams to be 1/2 thicker than plates and bulk heads for 121 ft amidships. From Foreward to upper part of bilge also lower edge of Main Deck Sheerstrake double rivetted. Remainder single.

Scale 1/2" = 1 foot.

JOHN ELDER & CO
Shipbuilders & Engineers
GLASGOW.

