

Barge "Woollahra" Report No. 11043

To Cass. 100 A. I.


Midship Section of
Ship N^o 16

Democris

Length of p as per rule 195.6
Breadth moulded 38.4
Depth of hold to top of floor 20.6

$\frac{1}{2} M \cdot b. = 16.66$
 $\frac{1}{2} \text{ girth } 33.5$
 $\text{Depth } 22.37$
 $\frac{1}{2} 53$

Plating No. 14. 179. Under 6 breast and 9 depth in length.

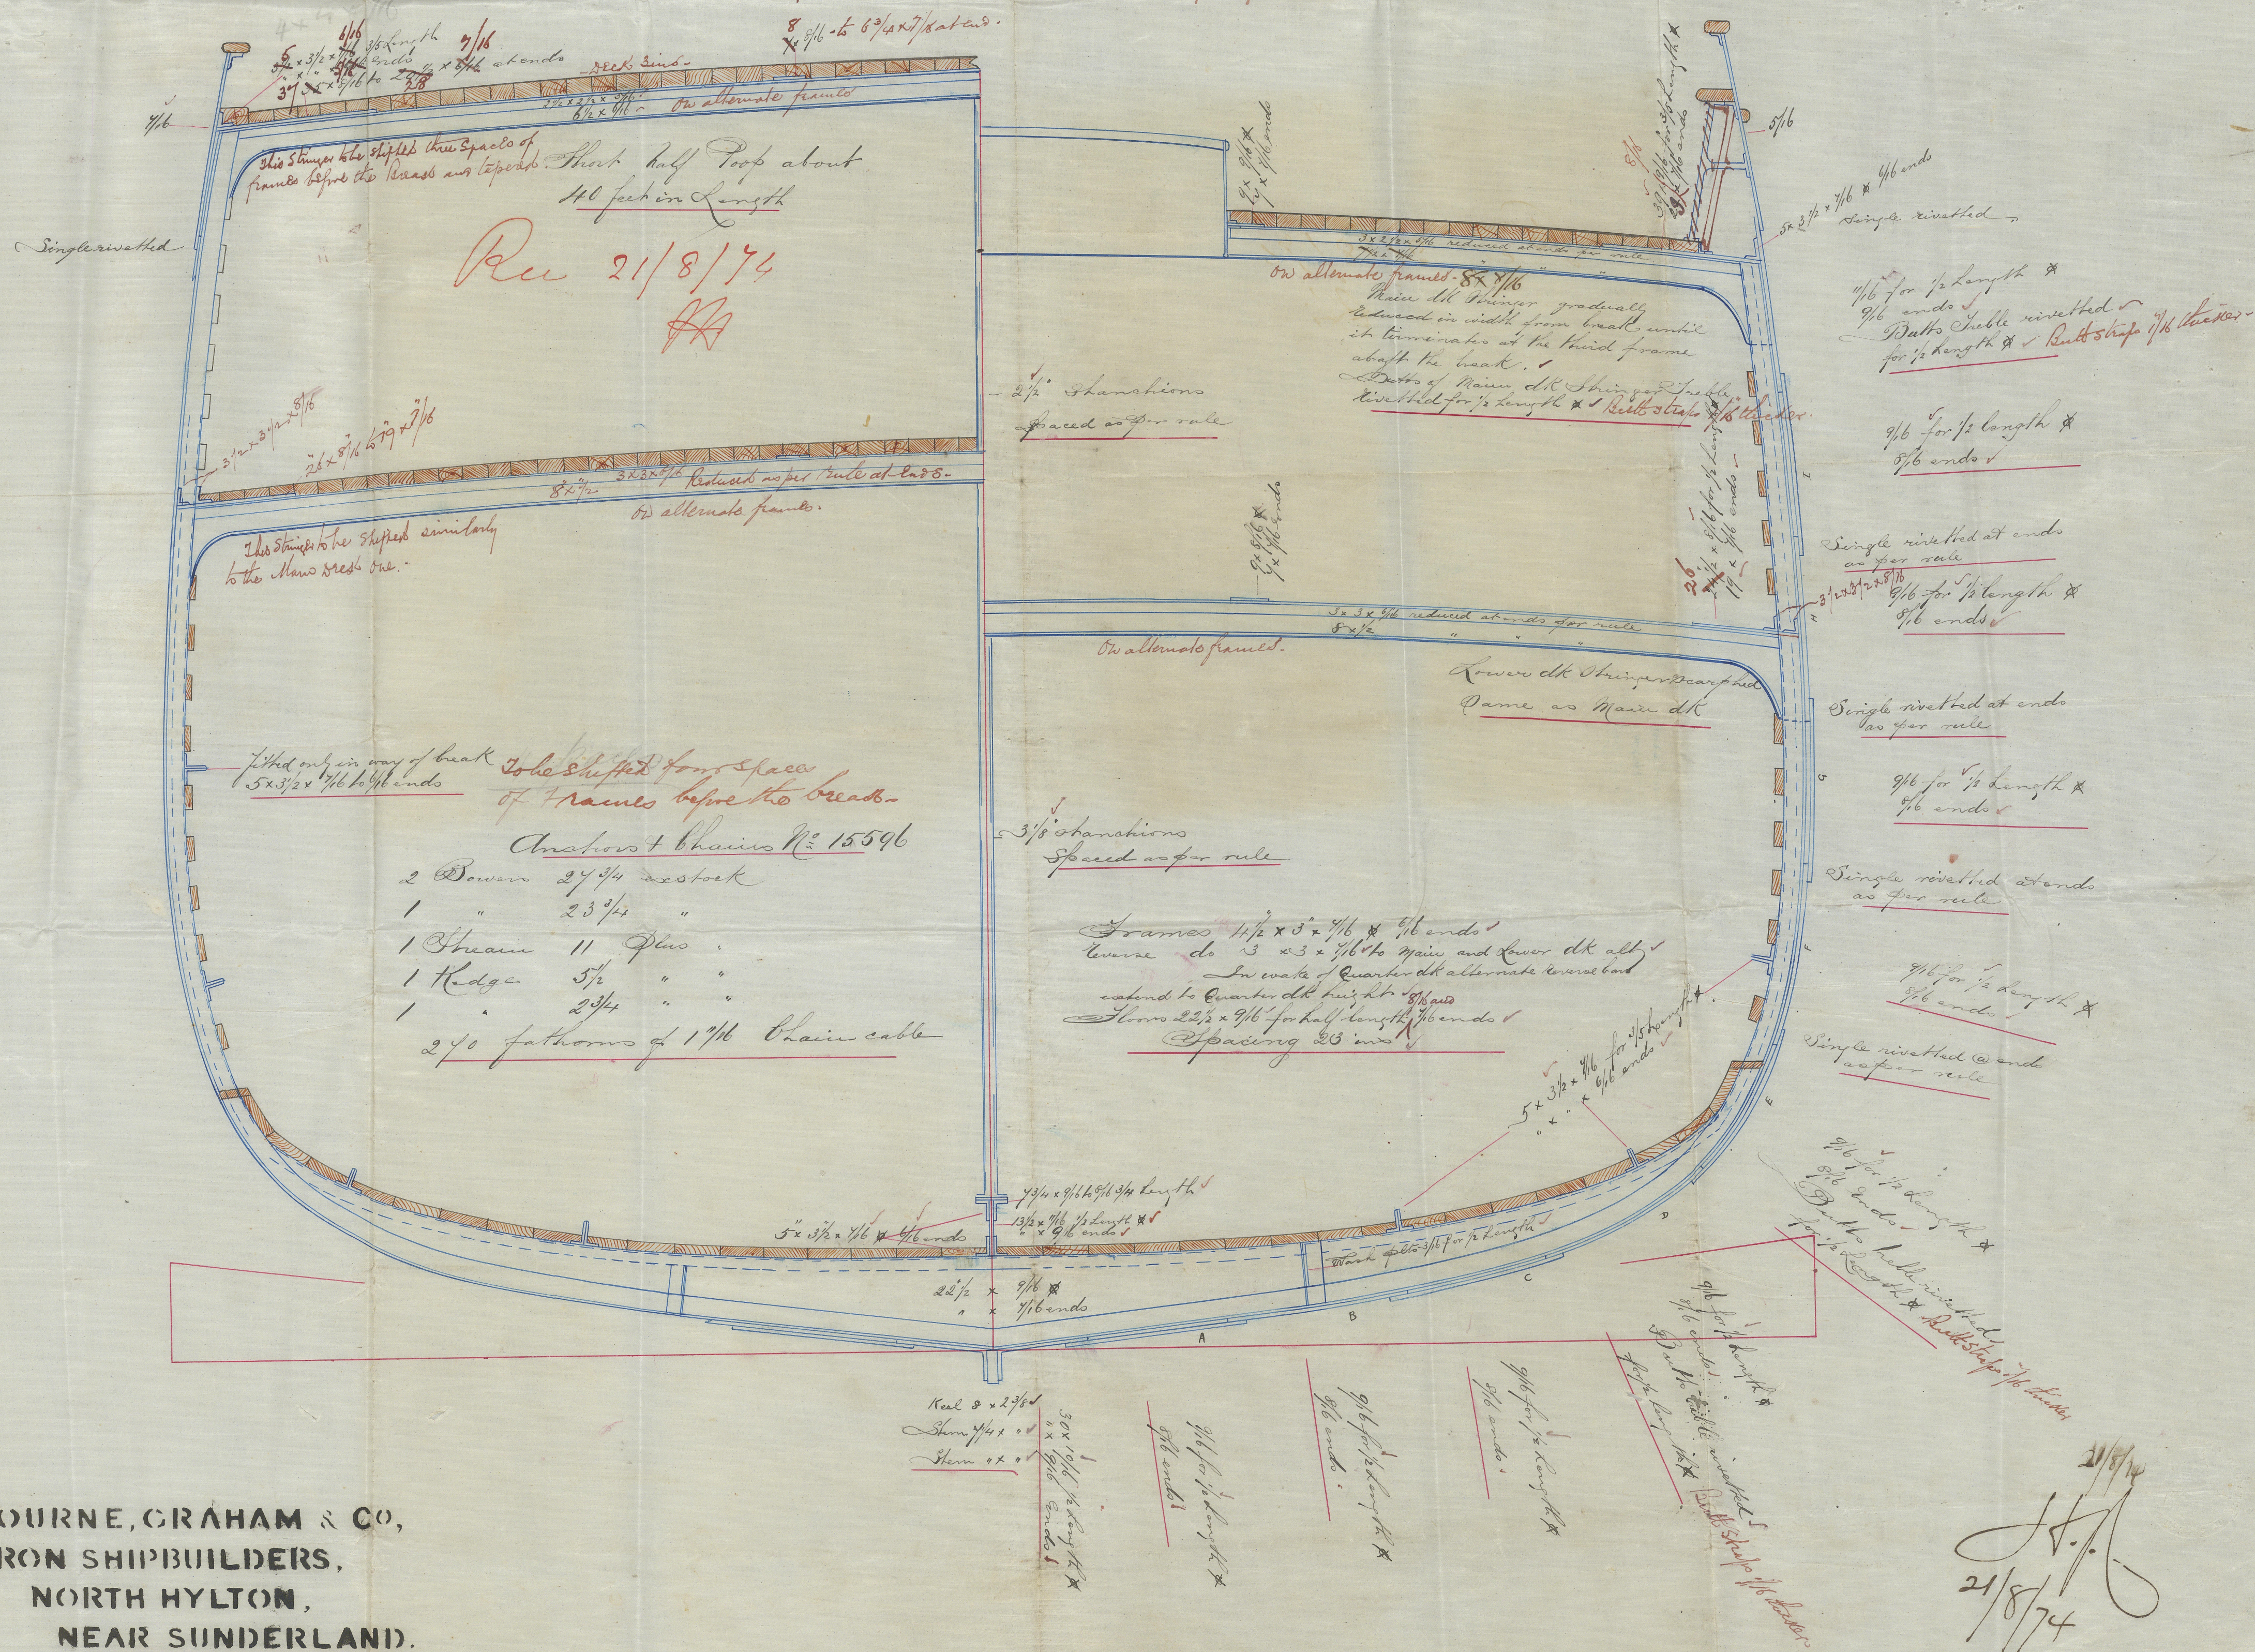

OSBOURNE, GRAHAM & CO,
IRON SHIPBUILDERS,
NORTH HYLTON,
NEAR SUNDERLAND.

August 13th 1874