


EARLES SHIPBUILDING &
ENGINEERING COMPANY
LIMITED.
HULL

Plan of top of Holes and Longitudinals

Bessemer Saloon Steamer

Scale 1/2 inch = One foot.

Rev 17/3/74
H

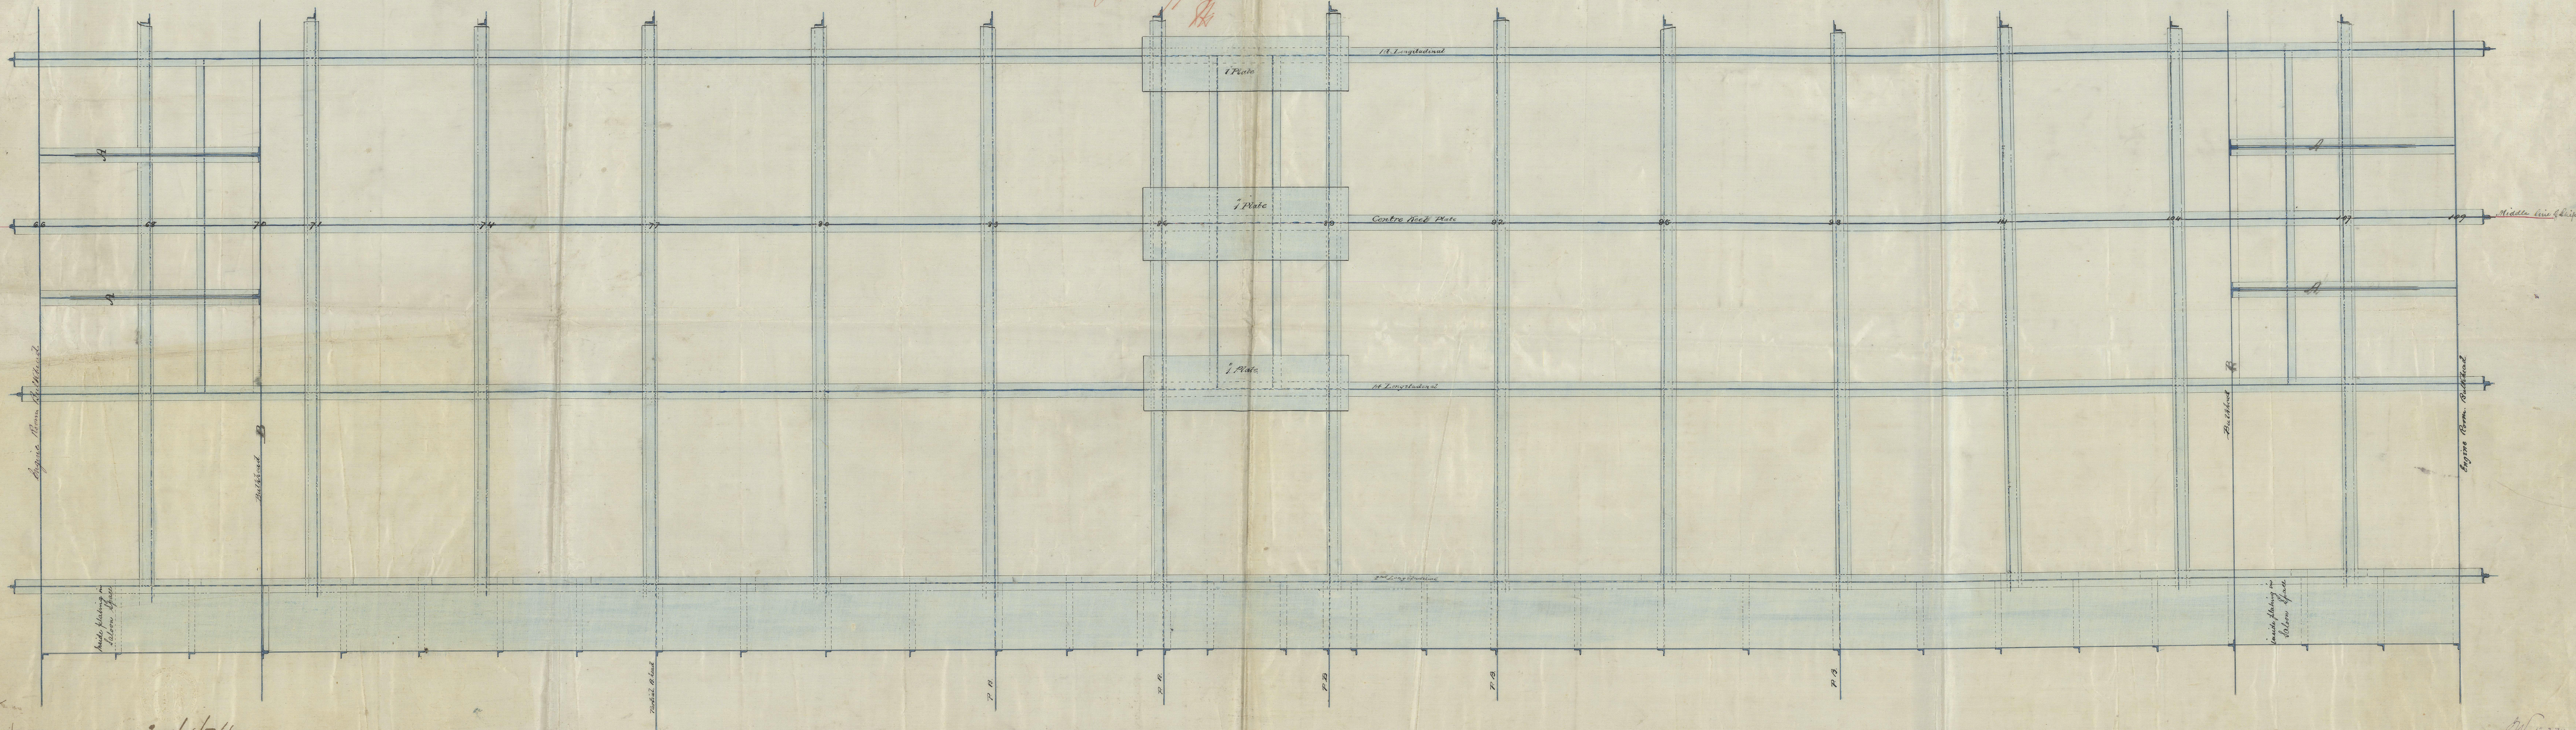

Wm
23/4/74

24/4/74