
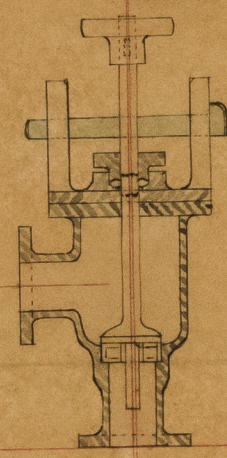



Bilge Discharge Valves

As recommended
By Board of Trade


As fitted
B

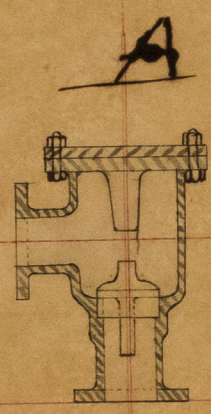

Scale 1" to one foot

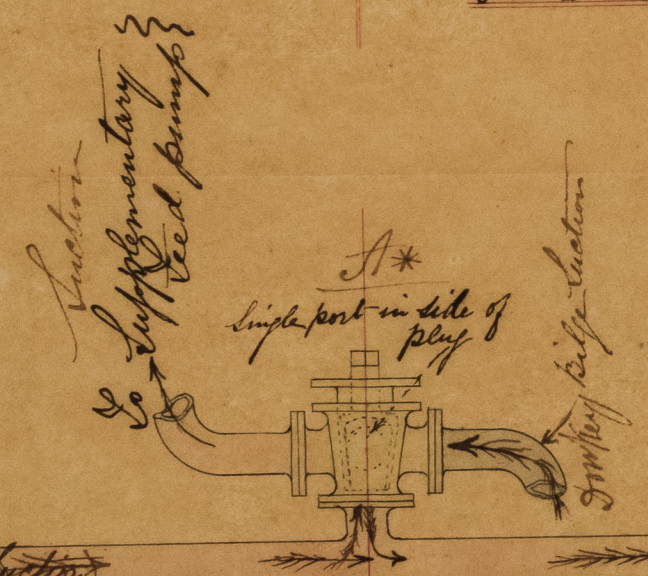

Scale 1" to one foot
This cock marked A. on plan drawing

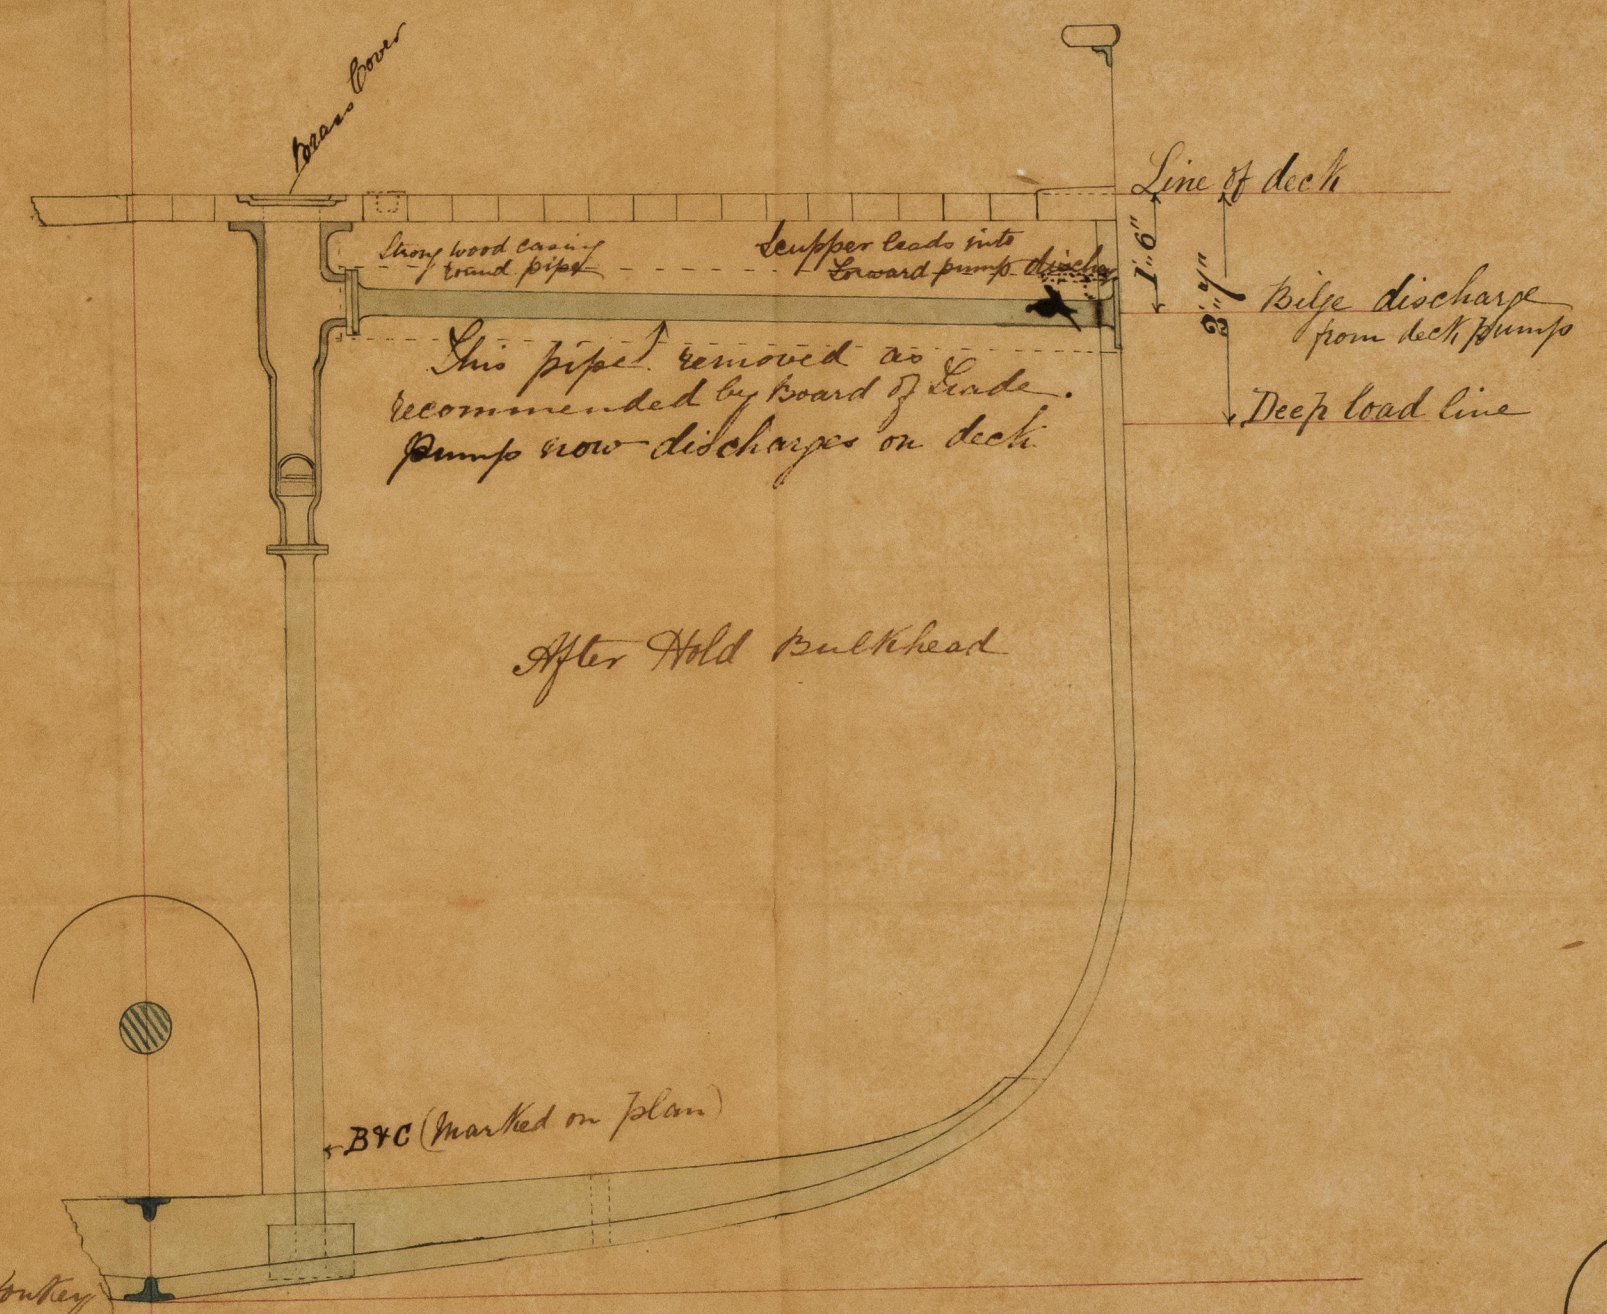

Scale 1/2" to one foot

J. Morrison
Greenock. 29.3.75

