

No. Report  
 14305

# N<sup>o</sup> 184 SHIP GIL ROY

Report N<sup>o</sup> 4029

Per 22/8/74  
 H


Roof and Forecastle Plating 6/16  
 Stringers 2 1/2 x 1/2 Angles 3 x 3 1/2  
 " " " 3/8  
 " " " 3/8  
 Beams (Angl) 6 x 3 1/2 x 8/16  
 Forecastle Beam (bulb) 7 x 7/16  
 " " " 2 1/2 x 2 1/2 x 5/16

100A Class  
 Length 247.0  
 Half Breadth 19.8  
 Depth 25.5  
 Half Girth 39.5  
 Nos for Rules 84.8 + 20970

Frames 5 x 3 1/2 x 8/16 for 147 ft ends 5 x 3 1/2 x 7/16 spaced 24" apart  
 all to top gallant rail on way of Poop to Main Deck  
 amidships to Forecastle deck forward  
 Reverse Frames 3 1/2 x 3 1/2 x 8/16 all to Main deck stringer


Bulkhead Plates 7/16 + 5/16  
 " " " 3/2 x 3 1/2 spaced 30" apart  
 Rudder Stock 6 1/2 diam. Plates 3/16  
 Keel 9 1/2 x 2 1/2  
 Stern at top 7 x 2 1/2  
 Stern Post 9 x 2 1/2

Butt Straps—Vertical plates  
 to have double strap, triple  
 rivelled 8/16 thick  
 Top plate single straps, 1 1/4  
 triple riv steel

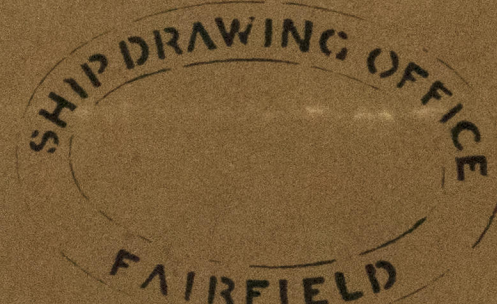

SCALE 1/2 INCH TO THE FOOT

JOHN ELDER & CO  
 Shipbuilders & Engineers  
 GLASGOW

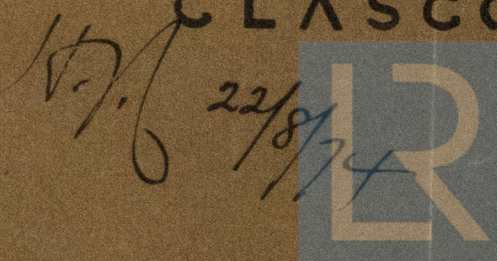

© 2021  
 Lloyd's Register  
 Foundation



