


442 100 30481



"Jogin" Report No 12017.

SS No 18
Scale of 1/4 inch = 1 foot
Rev 19/9/74

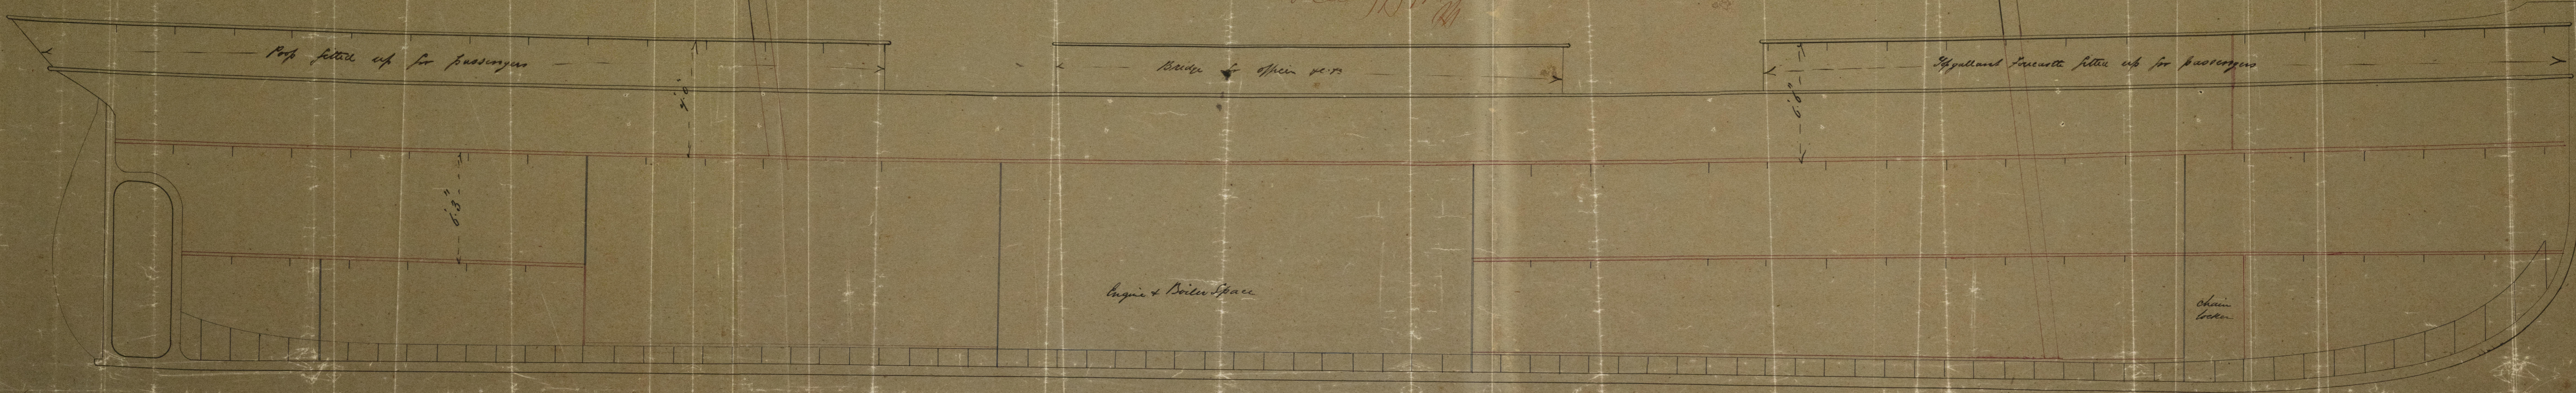

Letter to Mr. Innes
19/9/74

Sept 17th 1874 19/9/74



C. S. SWAN & Co
Iron Shipbuilders
WALLSEND
NEWCASTLE-ON-TYNE.



Lloyd's Register
Foundation
IRON 511 - 0125













© 2021

Lloyd's Register
Foundation