

No 18.
Under 2 beams
" 12 depths

"Sagu". Report No 12817.


1/2 girth 18.66
1/2 beam 11.0
depth 12.5

42.16


Class 100A


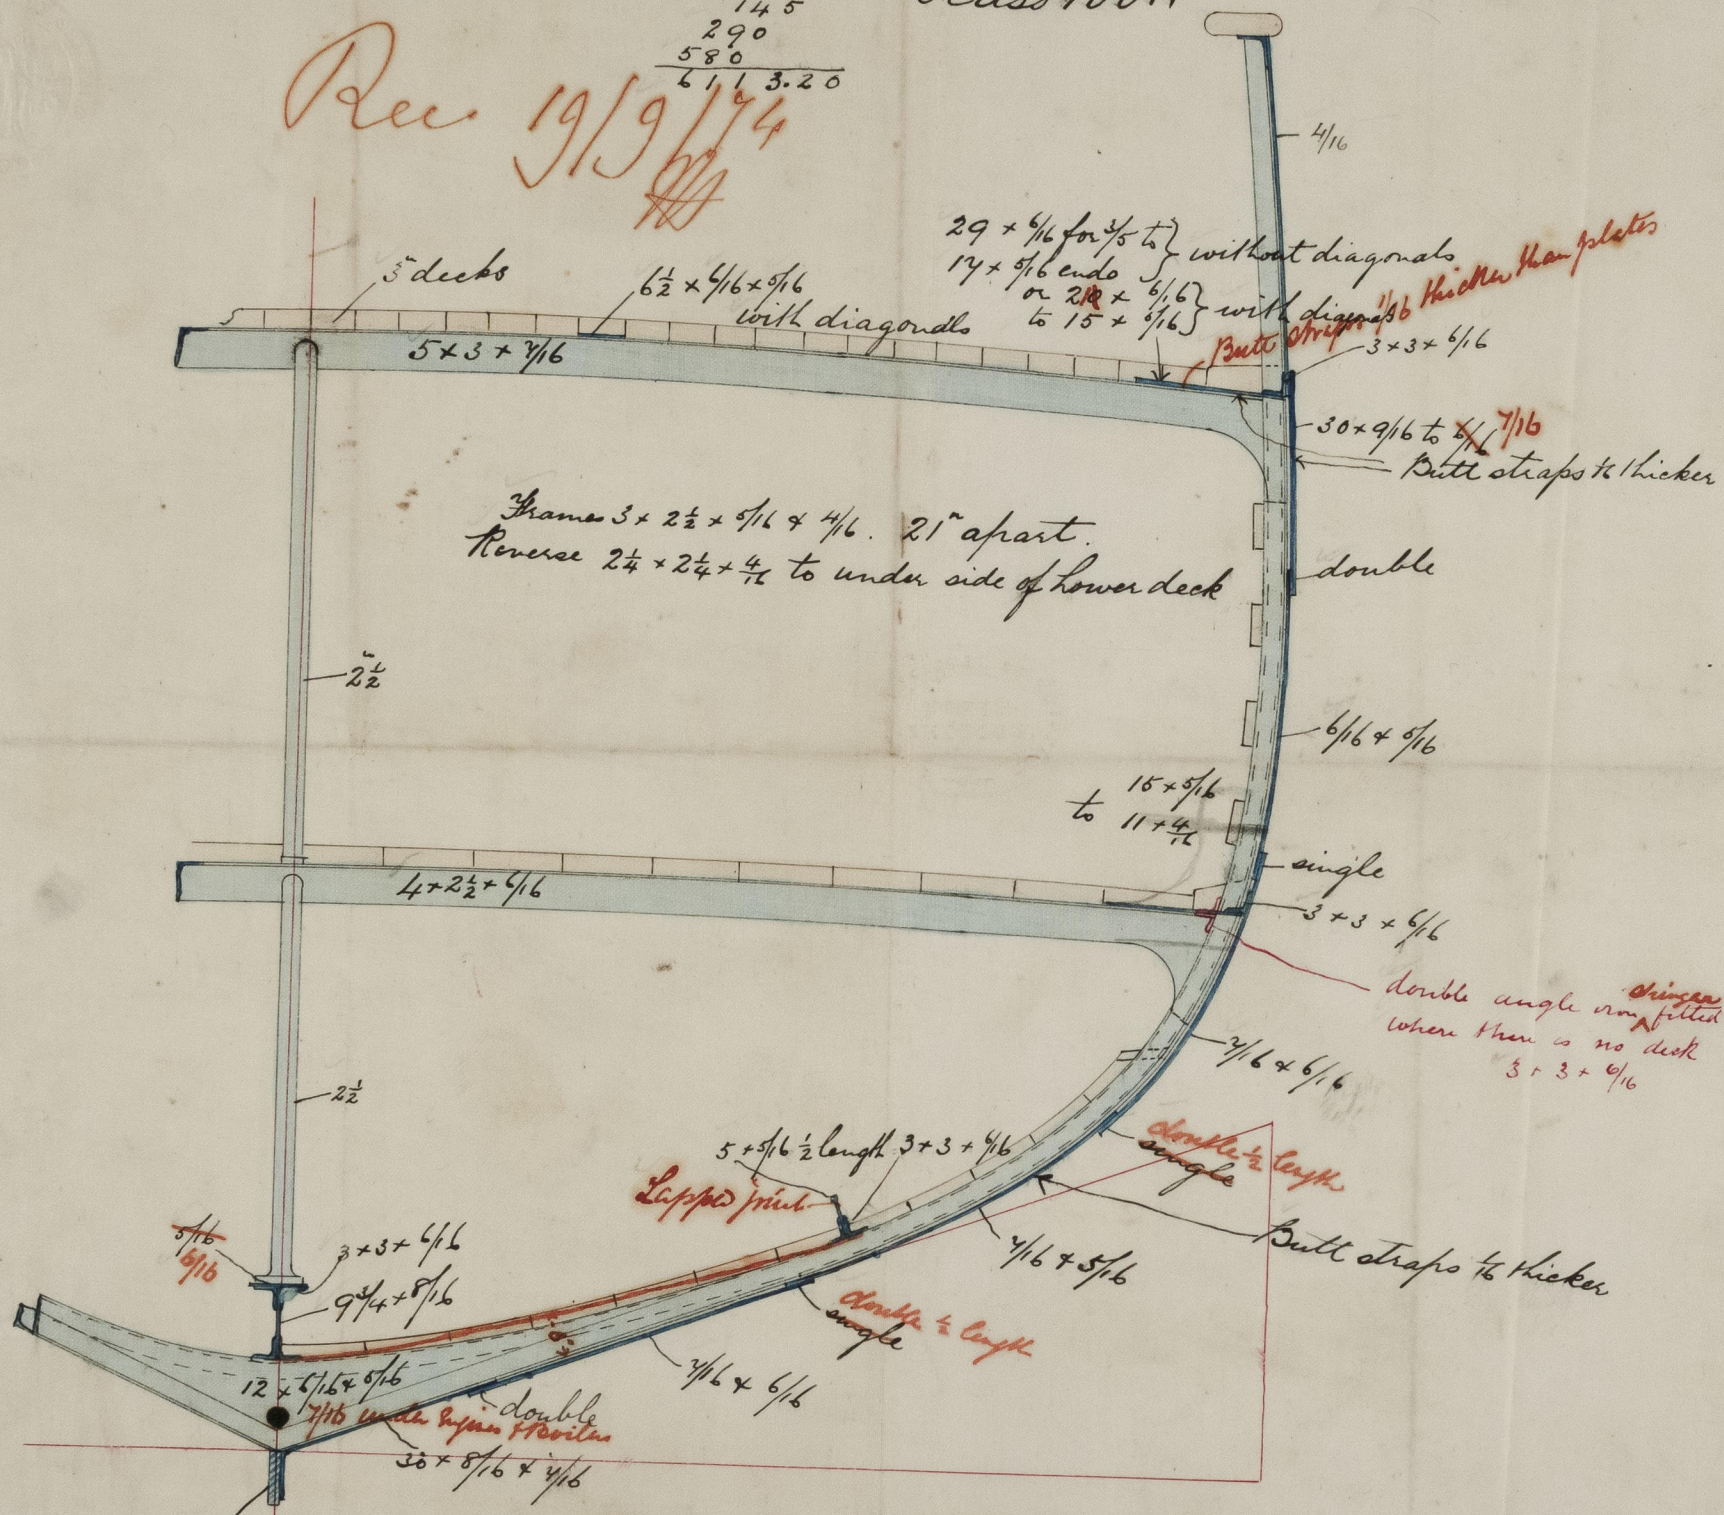

Keel $7 + 15/8$
Rudder Stock $3 3/4$
Puntles $2 1/4$
Stern post $6 1/4$

C. S. SWAN & Co
Iron Shipbuilders
WALLSEND
NEWCASTLE-ONTYNE.
Sept 16th 1874

Scale $\frac{1}{2}$ " = one foot

Letter to the Surveyors
- N Shulds 19/9/74

1919/74

© 2021

Lloyd's Register
Foundation

IRON 511-0126