Reports No 3456 — S. S. & J. B. Walker — 1607

No 114.

MIDSHIP SECTION
OF AN
IRON SCREW STEAMER

DIMENSIONS.

LENGTH OVER ALL —— 265.0
Do B. P. —— 255.0
BREADTH —— 32.0
DEPTH IN HOLD —— 24.0
Do MOULDED —— 25 1
TONNAGE O M — 1284
CLASS 90 A AT LLOYDS.

Rec 28/8/74 & 19/2/75

THREE DECKED.
WITH
Topgallant forecastle

½ Girth 37.60
½ Breadth 16.00
Depth 25.87
79.47
7
72.47 Number
253.46
18368.24
20142.00 Equipment Number
201.4
*215.6.00 Equipment Number with Topgallant Forecastle

Proportions
Under 11 Depth to Upper Deck
" 14 " Main Deck
" 8 Breadth

Anchors		& Chains cut
2	Bowers	30 exclusive of Stock
1	"	25½ " " "
1	Stream	12 including "
1	Kedge	6 " "
1	"	3 "
270	fathoms	1 12/16 stud chain cable
90	"	1 10/16 steam chain
90	"	11" Warp
90	"	8" "
2	Warps	6 fathoms 5"

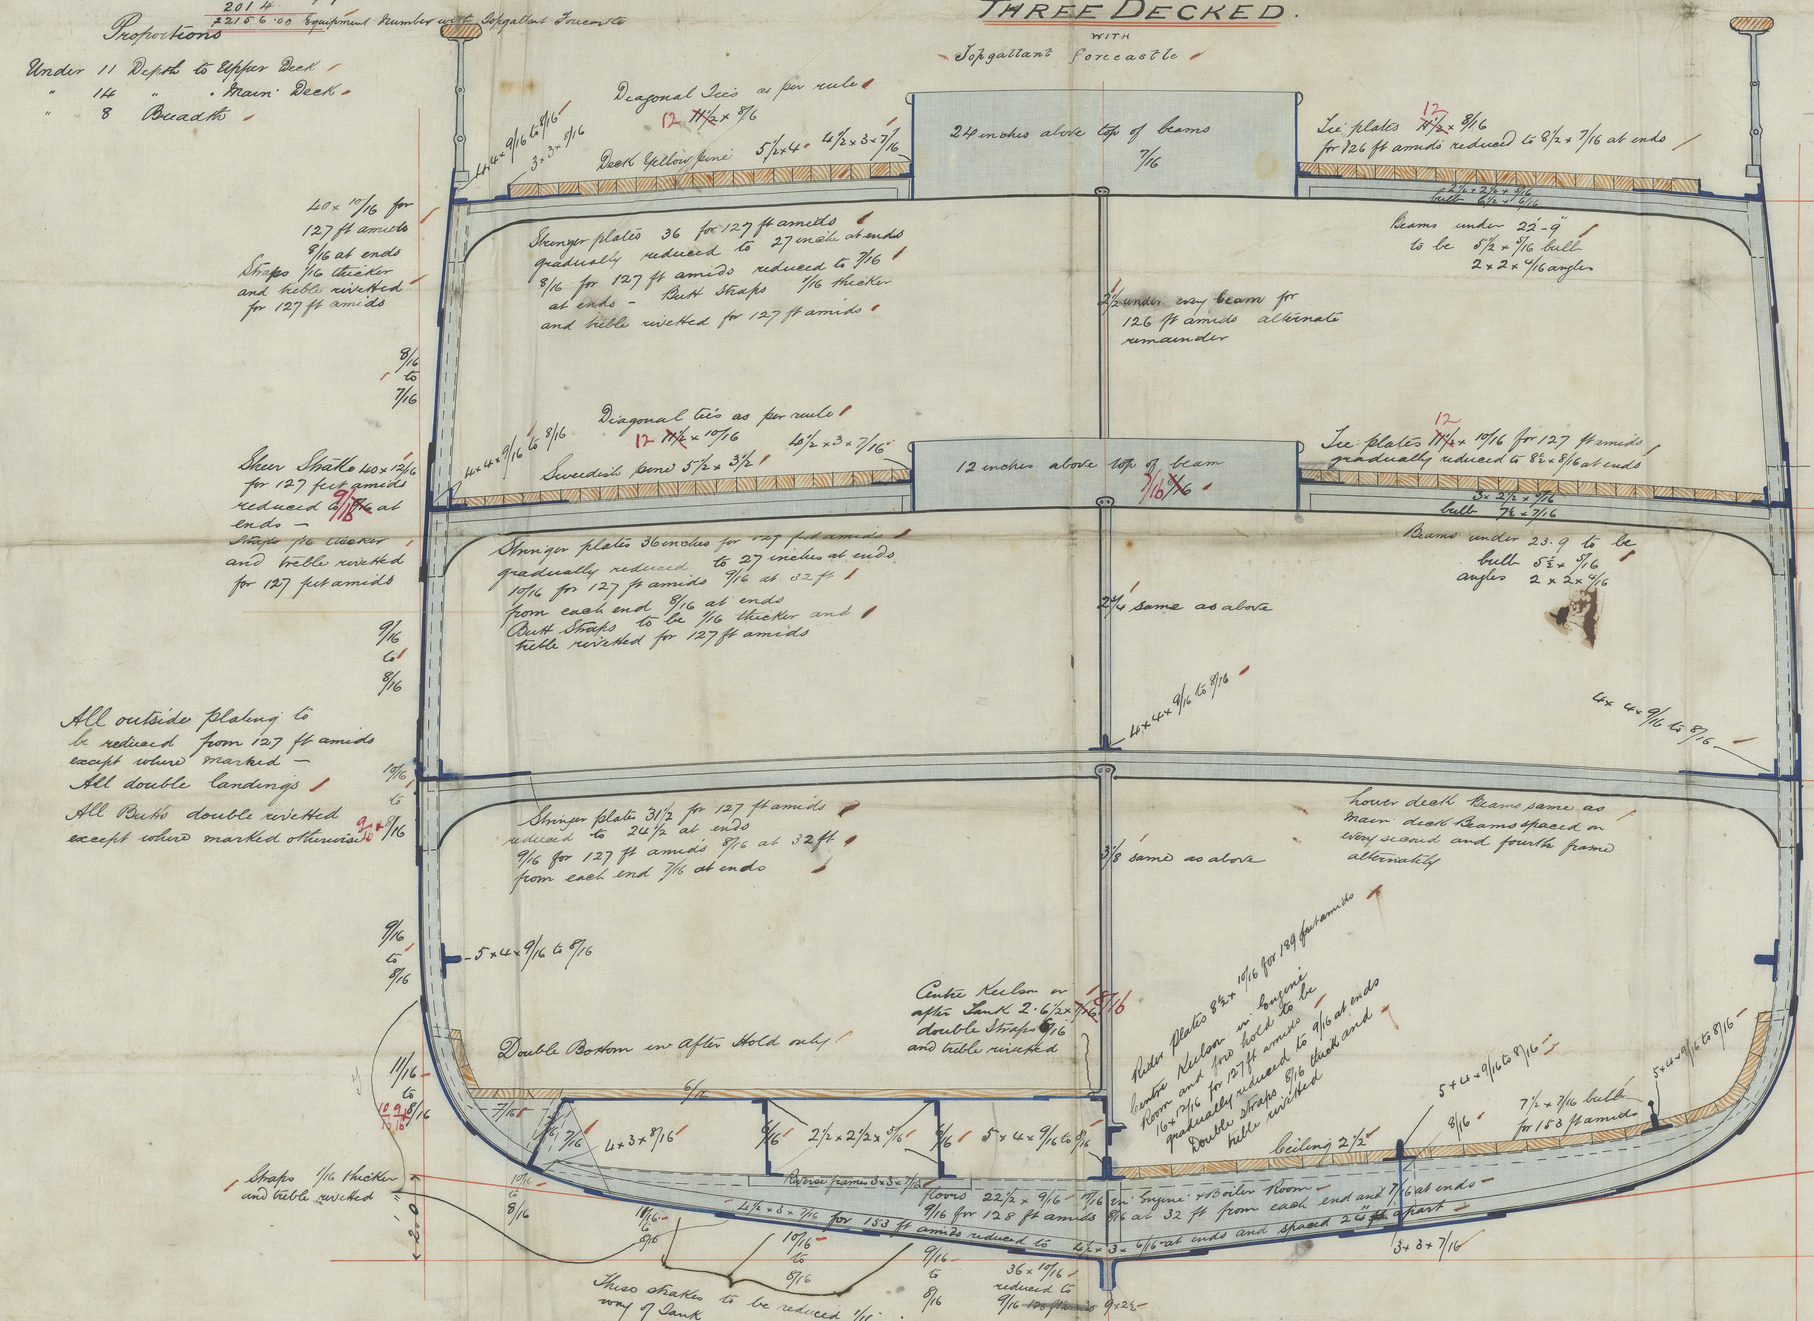

Stem	8½ x 2½
Stem frame	10 x 6½
Rudder at head	6"
Do at heel	3½
Pintles	3½
6 Watertight Bulkheads	
Bulkhead plates	6/16 to 5/16
Do Bars	3 x 3 x 7/16
Do placed 2'-6 apart	

SCALE ½ = 1 FOOT

RAYLTON DIXON & Co
IRON SHIP BUILDERS.
MIDDLESBRO-ON-TEES.

August 26th 1874

24/8/74 August 1874

160511-0142
© 2021 Lloyd's Register Foundation