

Recd 26/10/74

Barque "Jamaica" Report No 11,109.

S. No 67

MIDSHIP SECTION.

SCALE 1/2 INCH PER FOOT.

PRINCIPAL DIMENSIONS.

LENGTH BETWEEN PERPENDICULARS	170.6
BREADTH EXTREME	29.9
DEPTH IN HOLD TO TOP OF FLOORS	19.3
TONNAGE REGISTER GROSS	About 690

Classification Lloyds 100A - Rule 1874-5

Numeral


1/2 Girth	31.6
1/2 Breadth	14.9
Depth	21.0

$67.5 \times 170.5 = 11,508$

Equipment numeral 12,275. 12658

Depth of from keelson does not equal  
at least 700 tons - 278 fathoms 18 1/2 cable 19 1/2  
2 lower sections 24 cwt 23 1/2  
1 - " - " - 18 - " - 20.

Vessel built with a raised  
Quarter deck 40 feet long  
+ not enough 1/4 length of vessel or  
Extra strength required

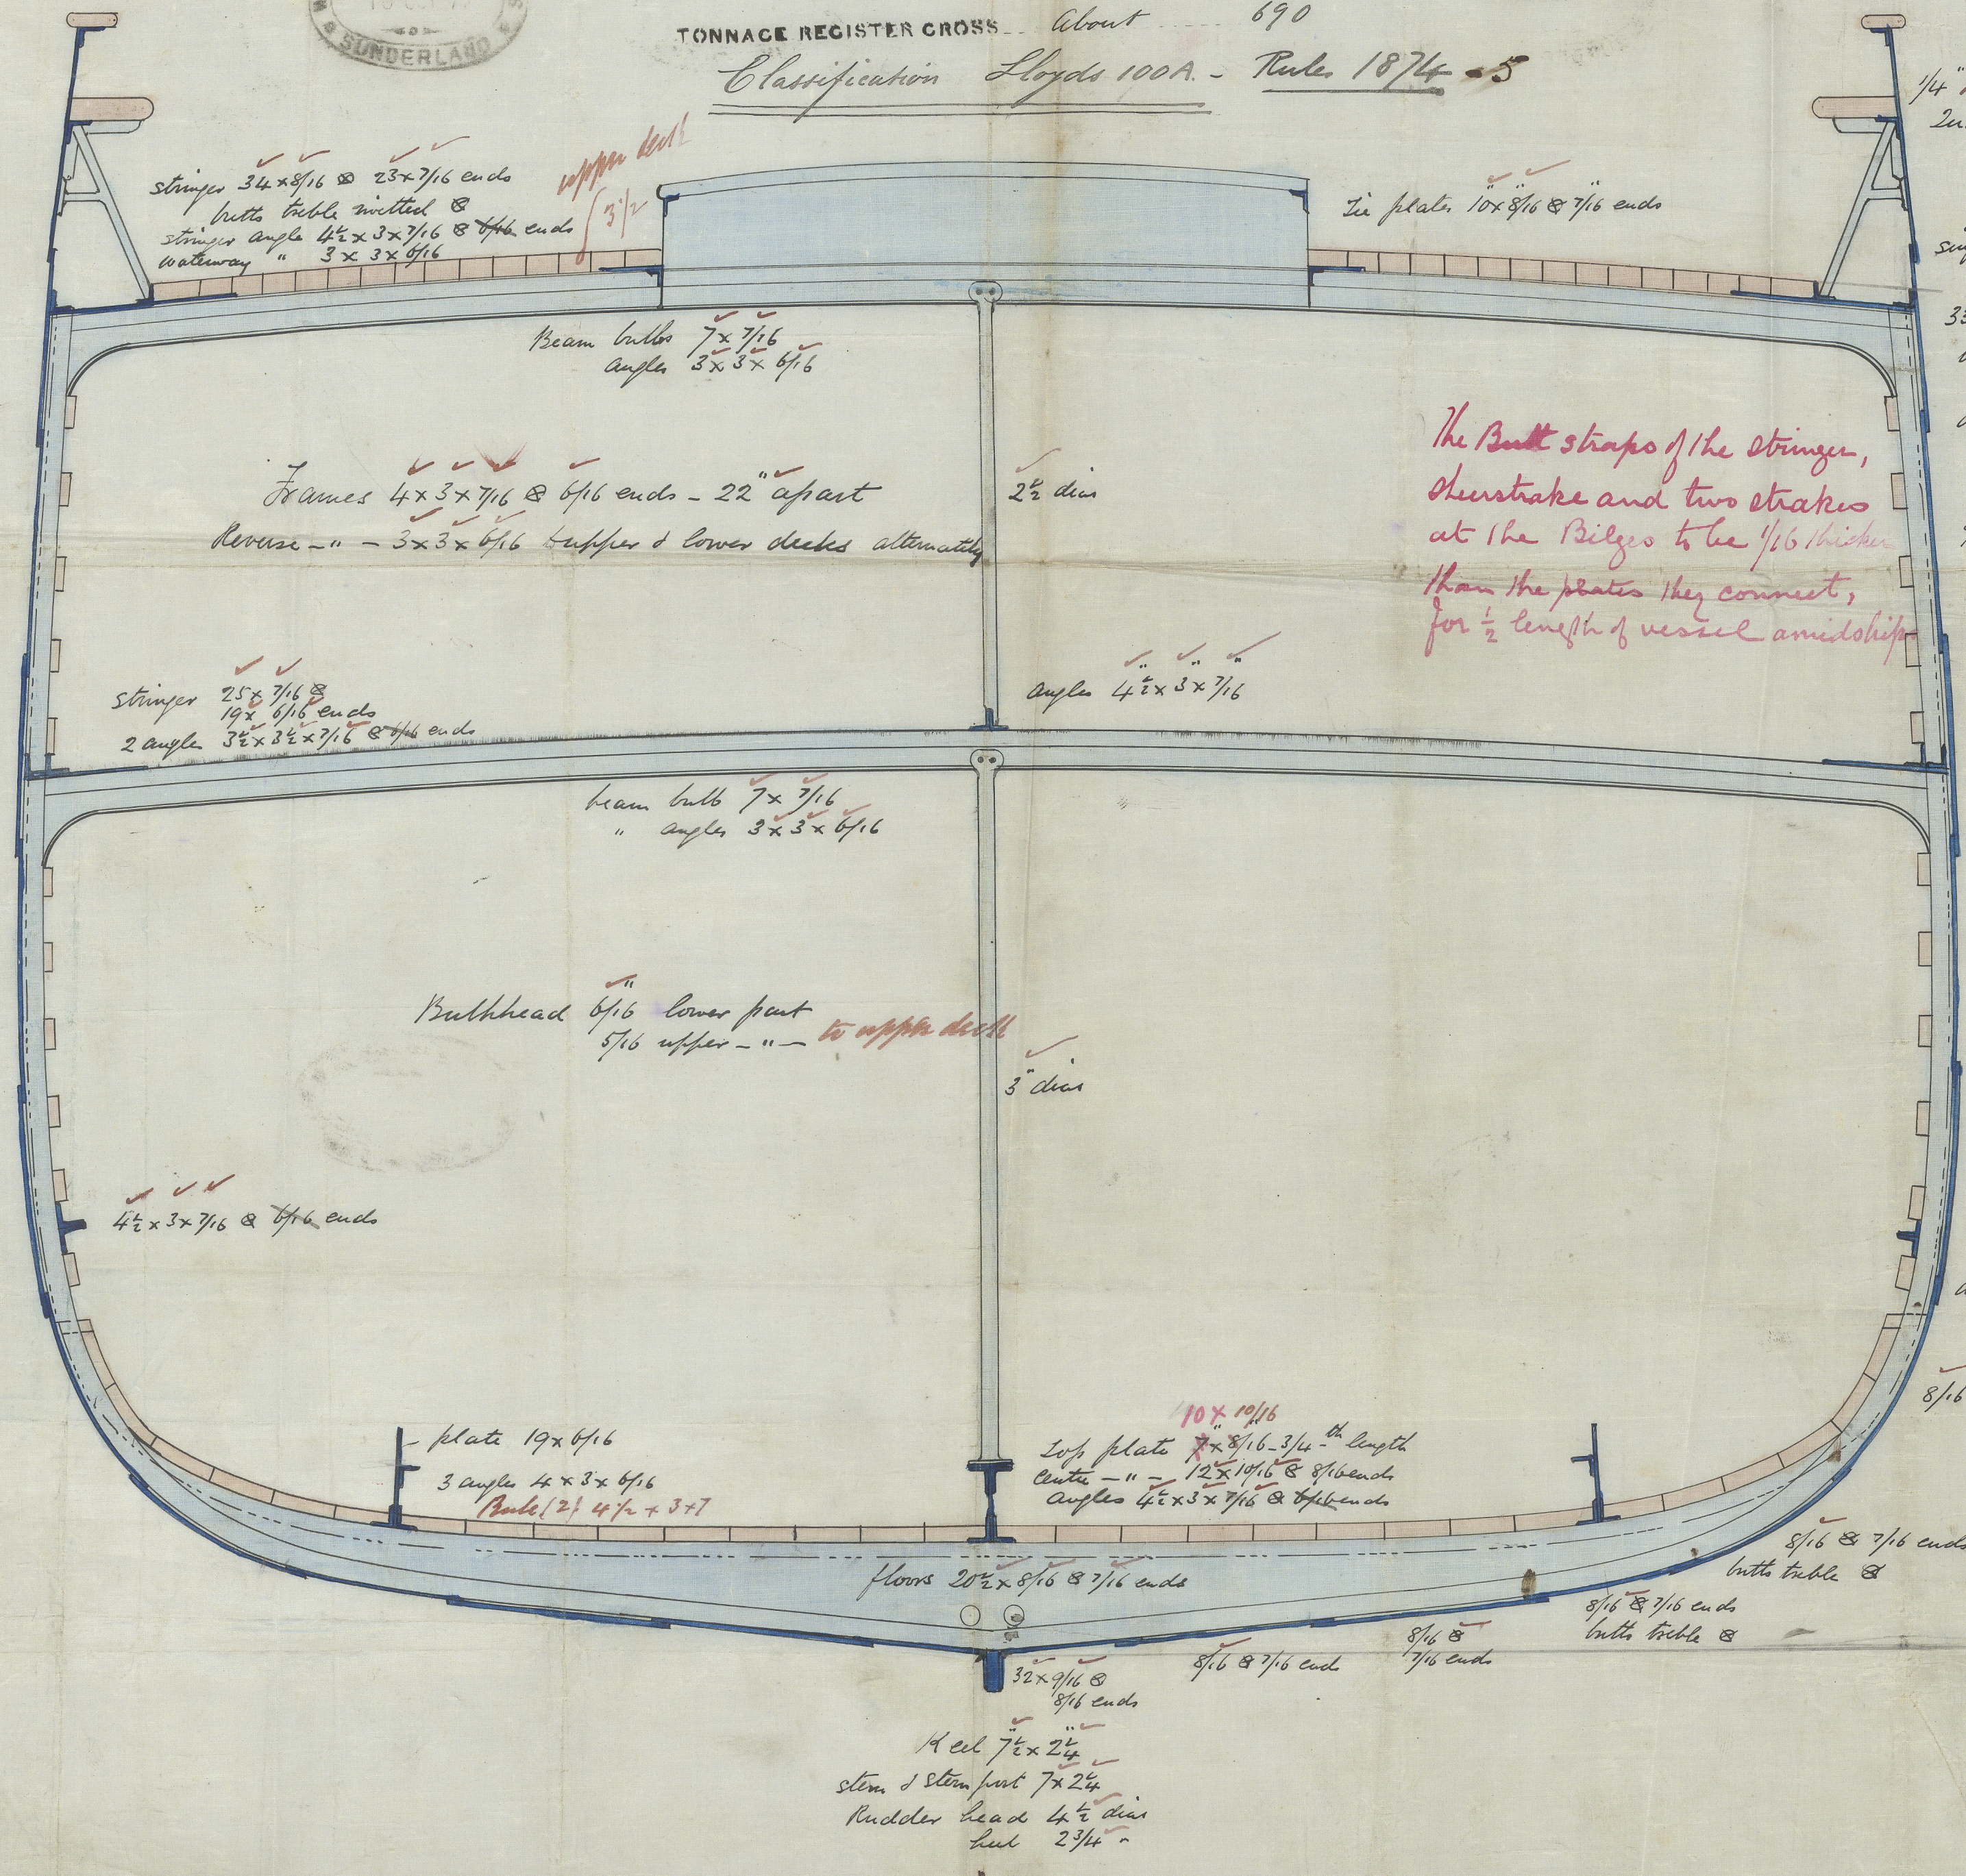

1/4" Plating raised  
Quarter deck plating 5/16" if  
under 1/4 length

single for 1 aft

33x10 1/2 & 8/16 ends  
butts treble &

double

8/16 & 7/16 ends

single

8/16 & 7/16 ends

single

8/16 & 7/16 ends

single

8/16 & 7/16 ends

double & below this

8/16 & 7/16 ends

8/16 & 7/16 ends  
butts treble &

8/16 & 7/16 ends  
butts treble &

8/16 & 7/16 ends

8/16 & 7/16 ends

8/16 & 7/16 ends

1874  
26/10/74

23/10 74