
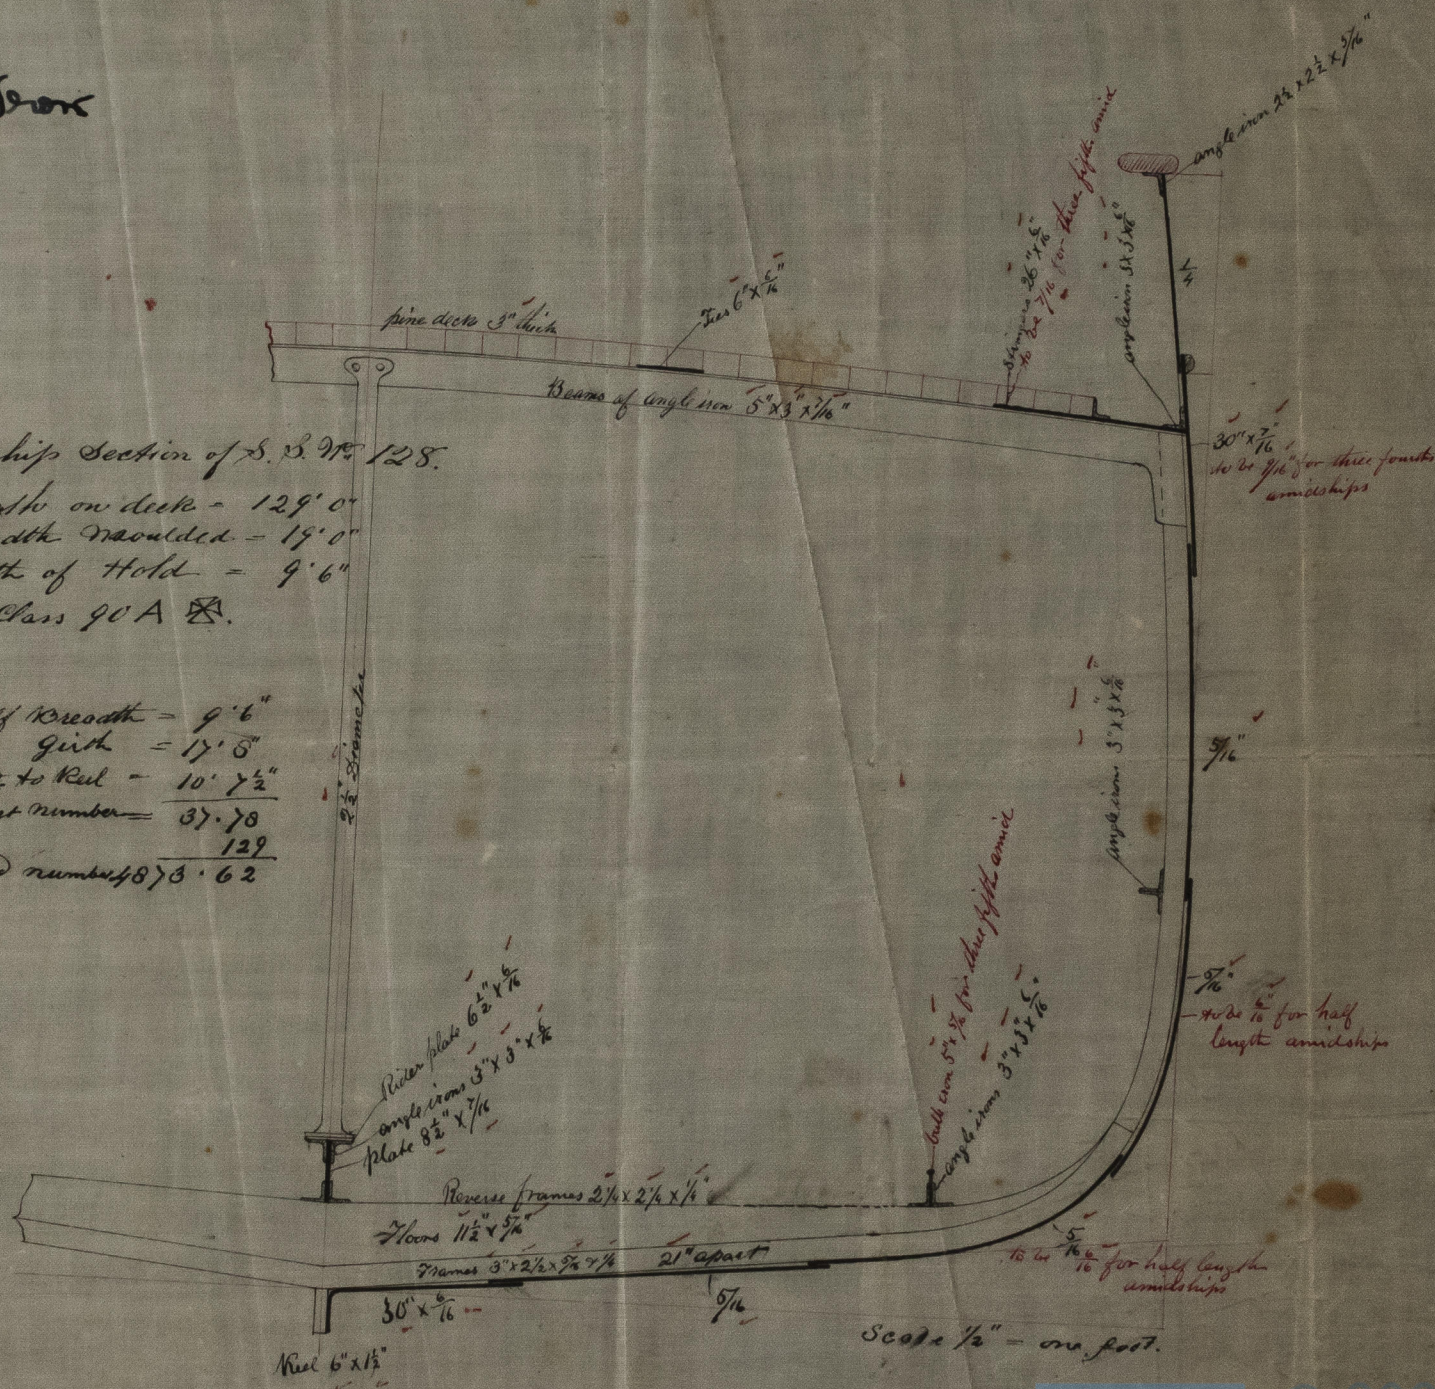


14302 Iron

Midships Section of S. S. No 128.
 Length on deck = 129' 0"
 Breadth moulded = 19' 0"
 Depth of Hold = 9' 6"
 To Class 90A 

Half Breadth = 9' 6"
 " Girth = 17' 8"
 Depth to Keel = 10' 7 1/2"
 First number = 37.78
 129



Blackwood & Gordon
 Port Glasgow
 18/9/54
 2579.76
 IRONSII-0174.2