


Midship Section of Screw Steamer No 129.
 To Class 90 A. X. at Lloyd's.

12.7 Depth
 6.2 Breadth

Depth from top of keel = $10' 1\frac{1}{2}"$
 half breadth = $10' 5\frac{1}{2}"$
 half girth = $17' 8\frac{1}{2}"$
 first number = $38 \cdot 3\frac{1}{2}" = 38.29$
 Length on deck = $129' 0"$

Second number = 4939.41

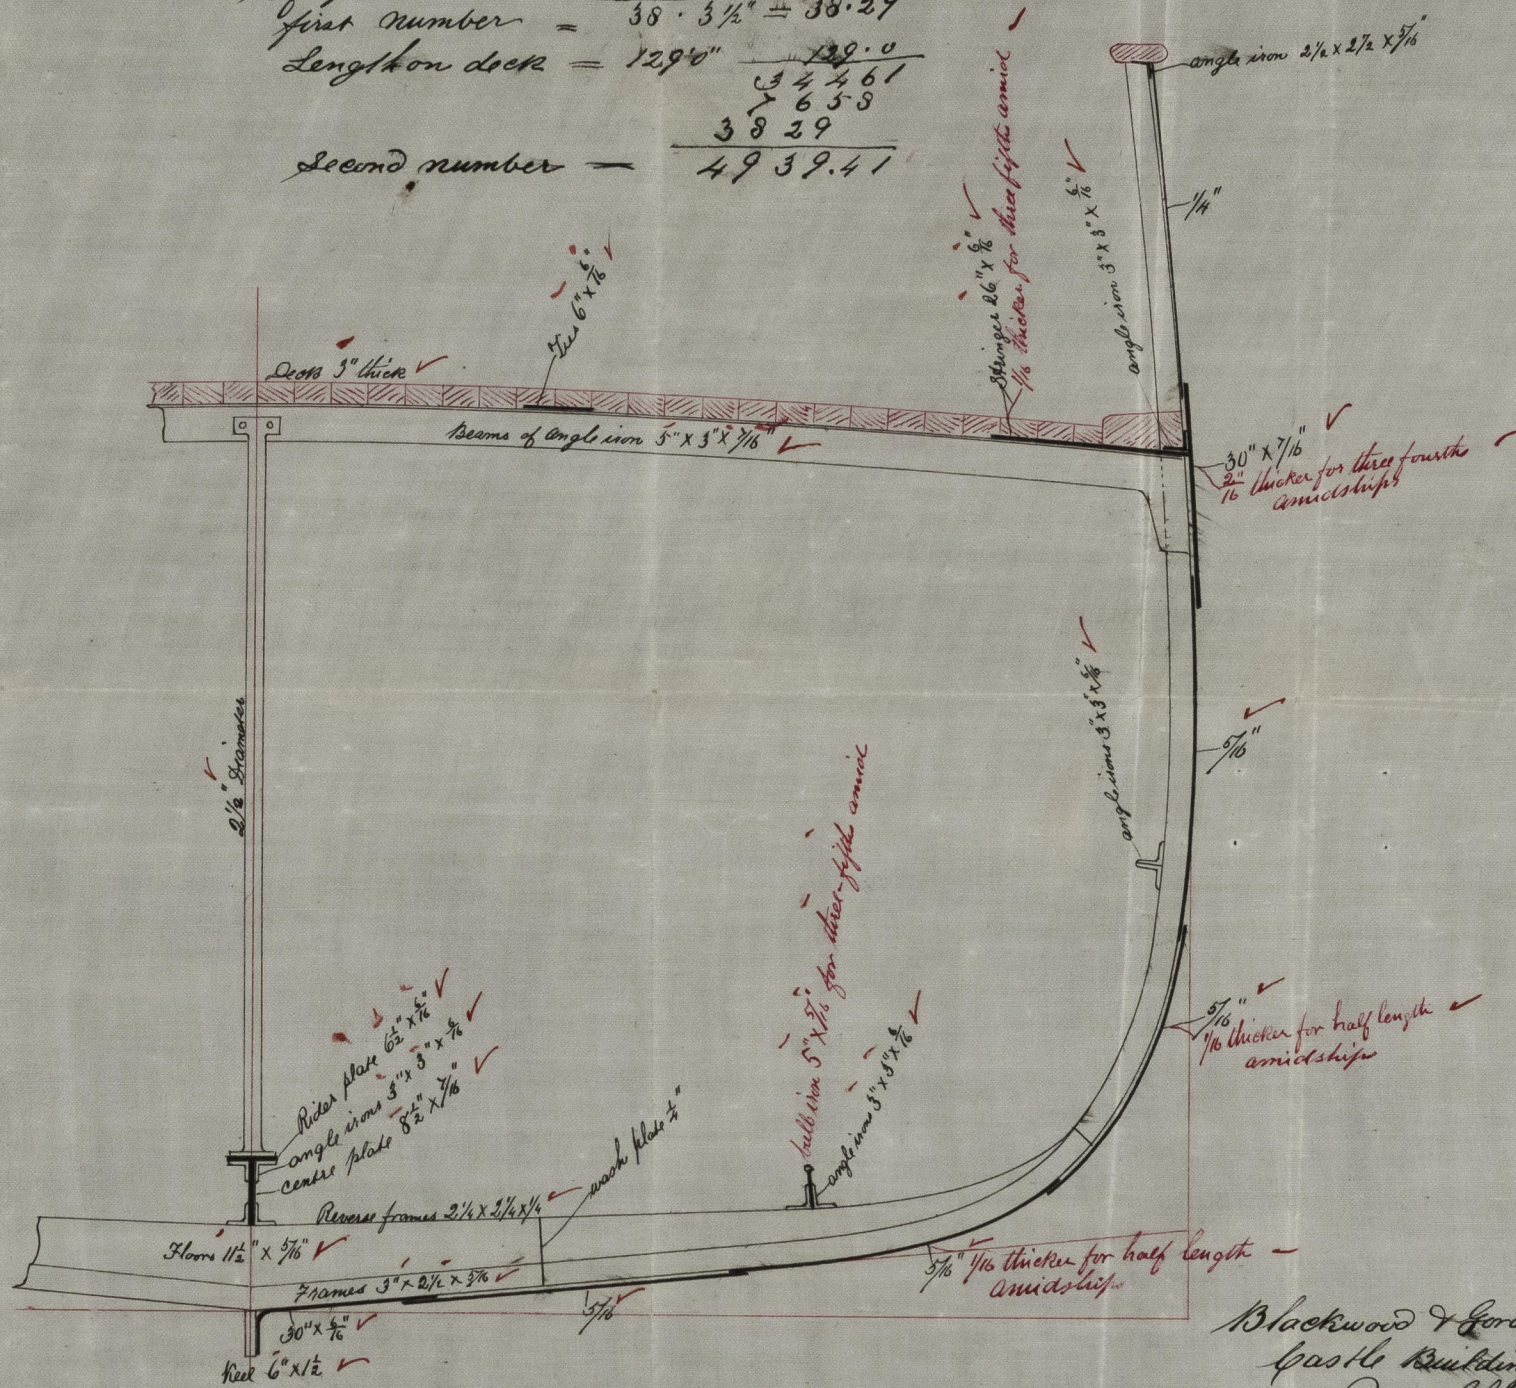

Blackwood & Gordon
 Castle Building Yard
 Port Glasgow
 12/11/74

11/12/74.



© 2021
 Lloyd's Register
 Foundation