


proposed Compensation for break in
Center Section for No 12,9 S. S.
Blackwood & Gordon
Port Glasgow
1874

Top of Beams at Centre of ship
Top of Beams at Side of ship

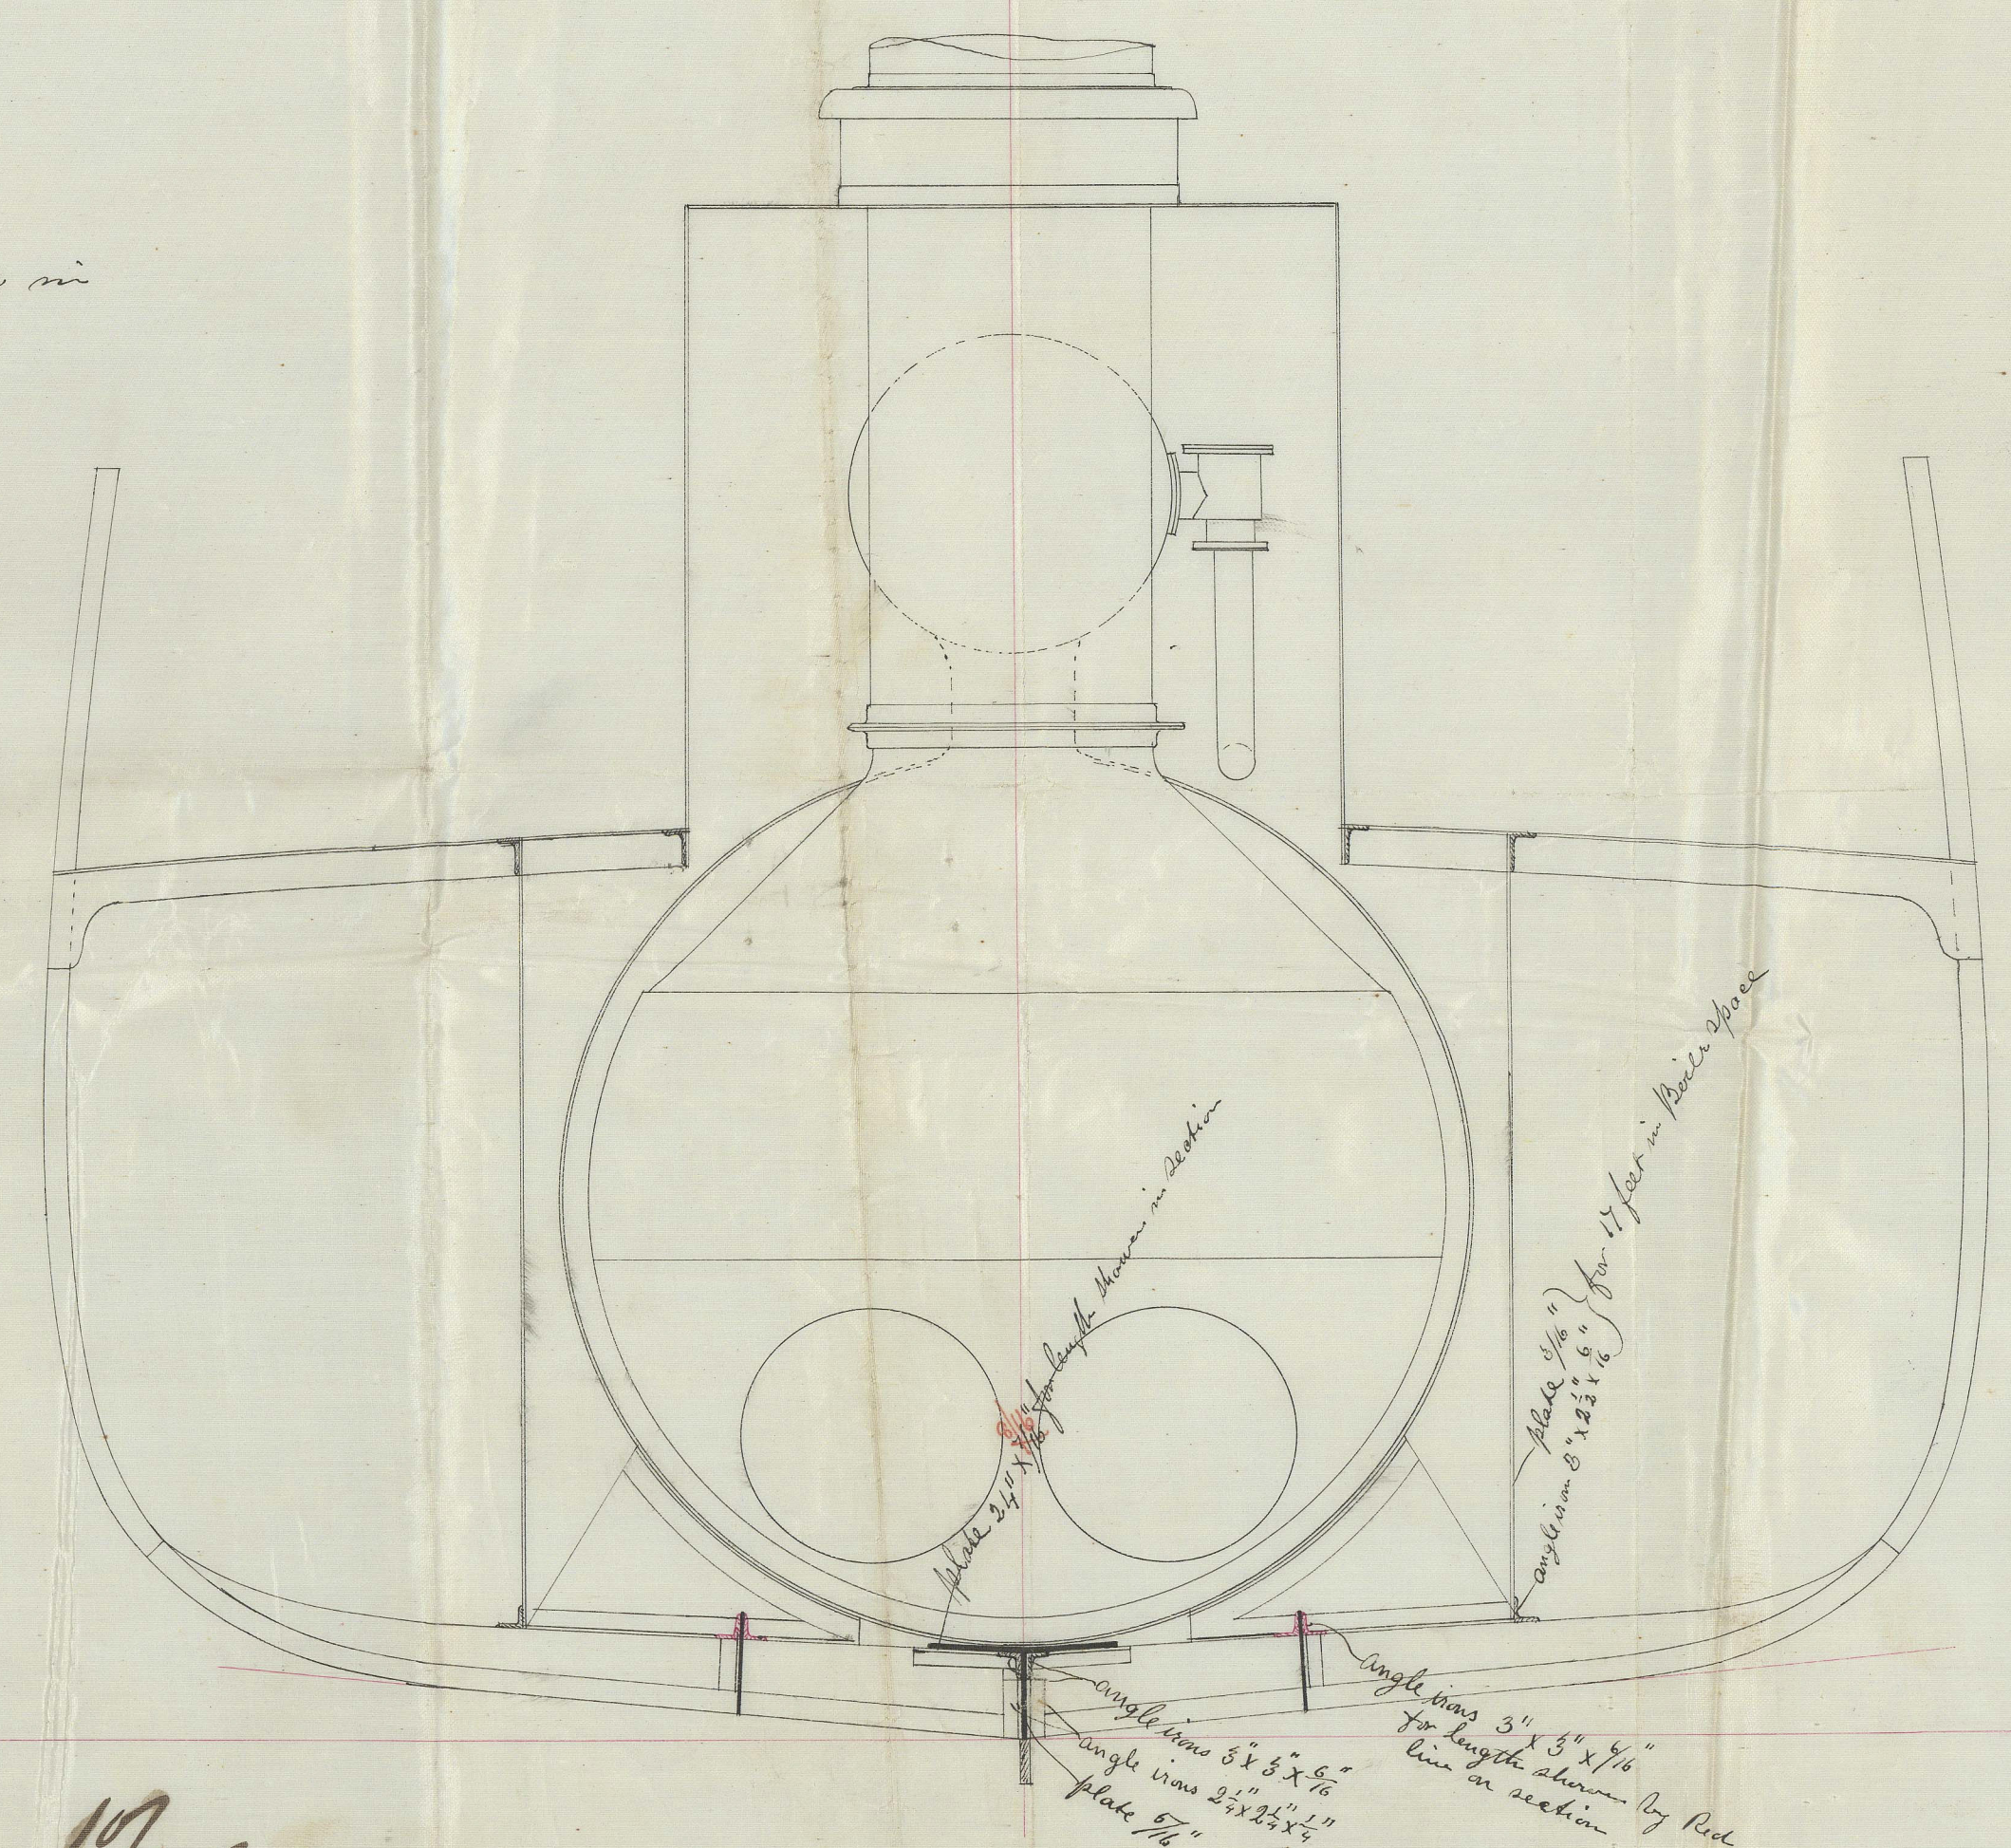

19/12/74