


Barque "Belle of Benin" Report No. 11.122.

Iron Mast No 2


Main Mast  
5' 2" 0

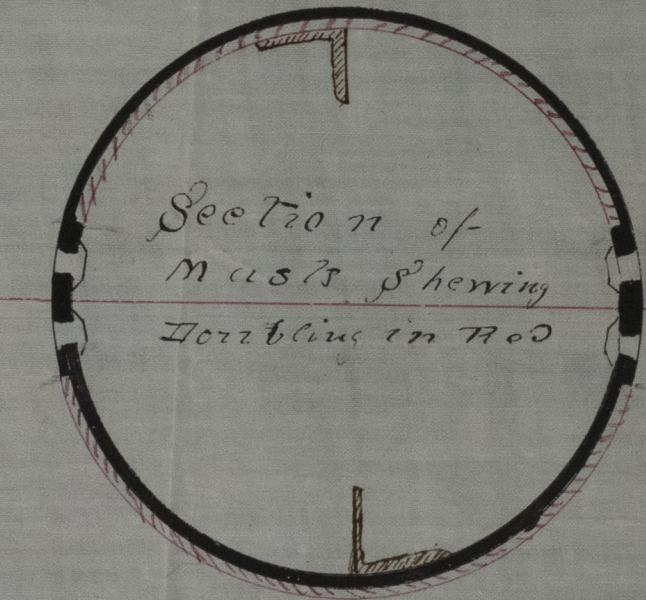

G. S. G. 22 75 75 n  
Iron Ship barrel  
Pinnerelars

Jan 28/75  
P. T. Air bill

Received same for  
day for thickness of plating  
to be shown - 11/11 -

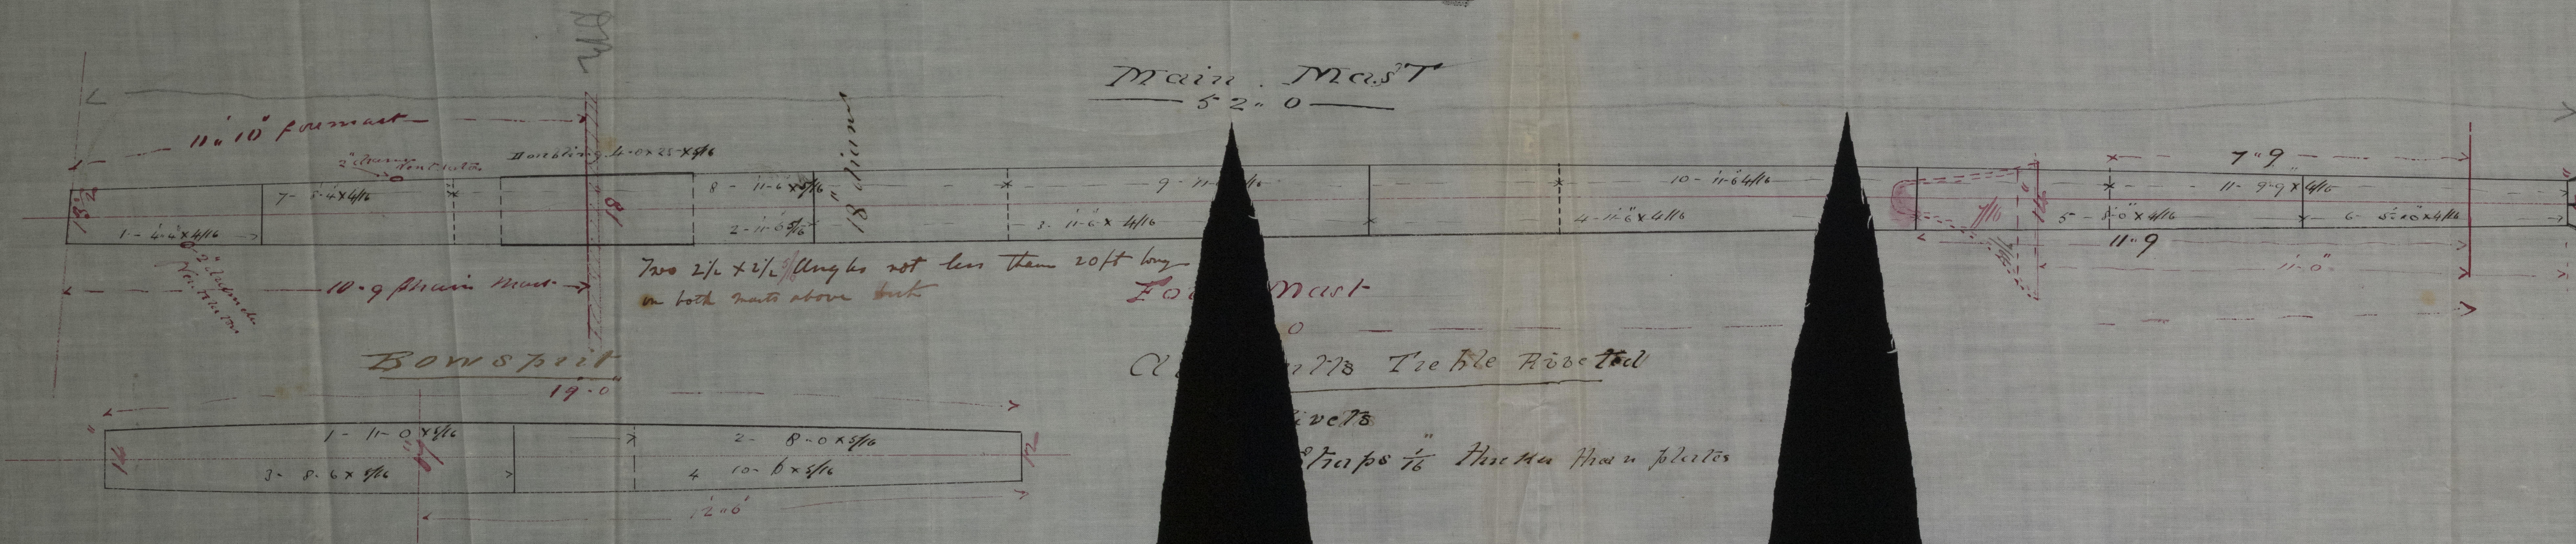

Red.

IRON 11-0209



14496 Lon



© 2021

Lloyd's Register  
Foundation

1204511-0209