

Compared with Rules dated 30th July 1874

Drawn No 14522

MOUNSEY & FOSTER
IRON SHIP BUILDERS,
SOUTH DOCK,
SUNDERLAND.

Report No 11,123
S.S. Plover.

Jan 6th 1875.

9.1.75

Handwritten signature

MIDSHIP SECTION OF NO 73

100A *grad*

SCALE $\frac{1}{2}$ INCH = 1 FOOT

Rev 14/1/75

To be shifted & spaced
before Break

Plating to be
shifted & spaced
before Break
Fitted to alternate for

Shifted & spaced
before Break

To second and
fourth frames
of Deck alternate for


To second and
fourth frames
of Deck alternate for

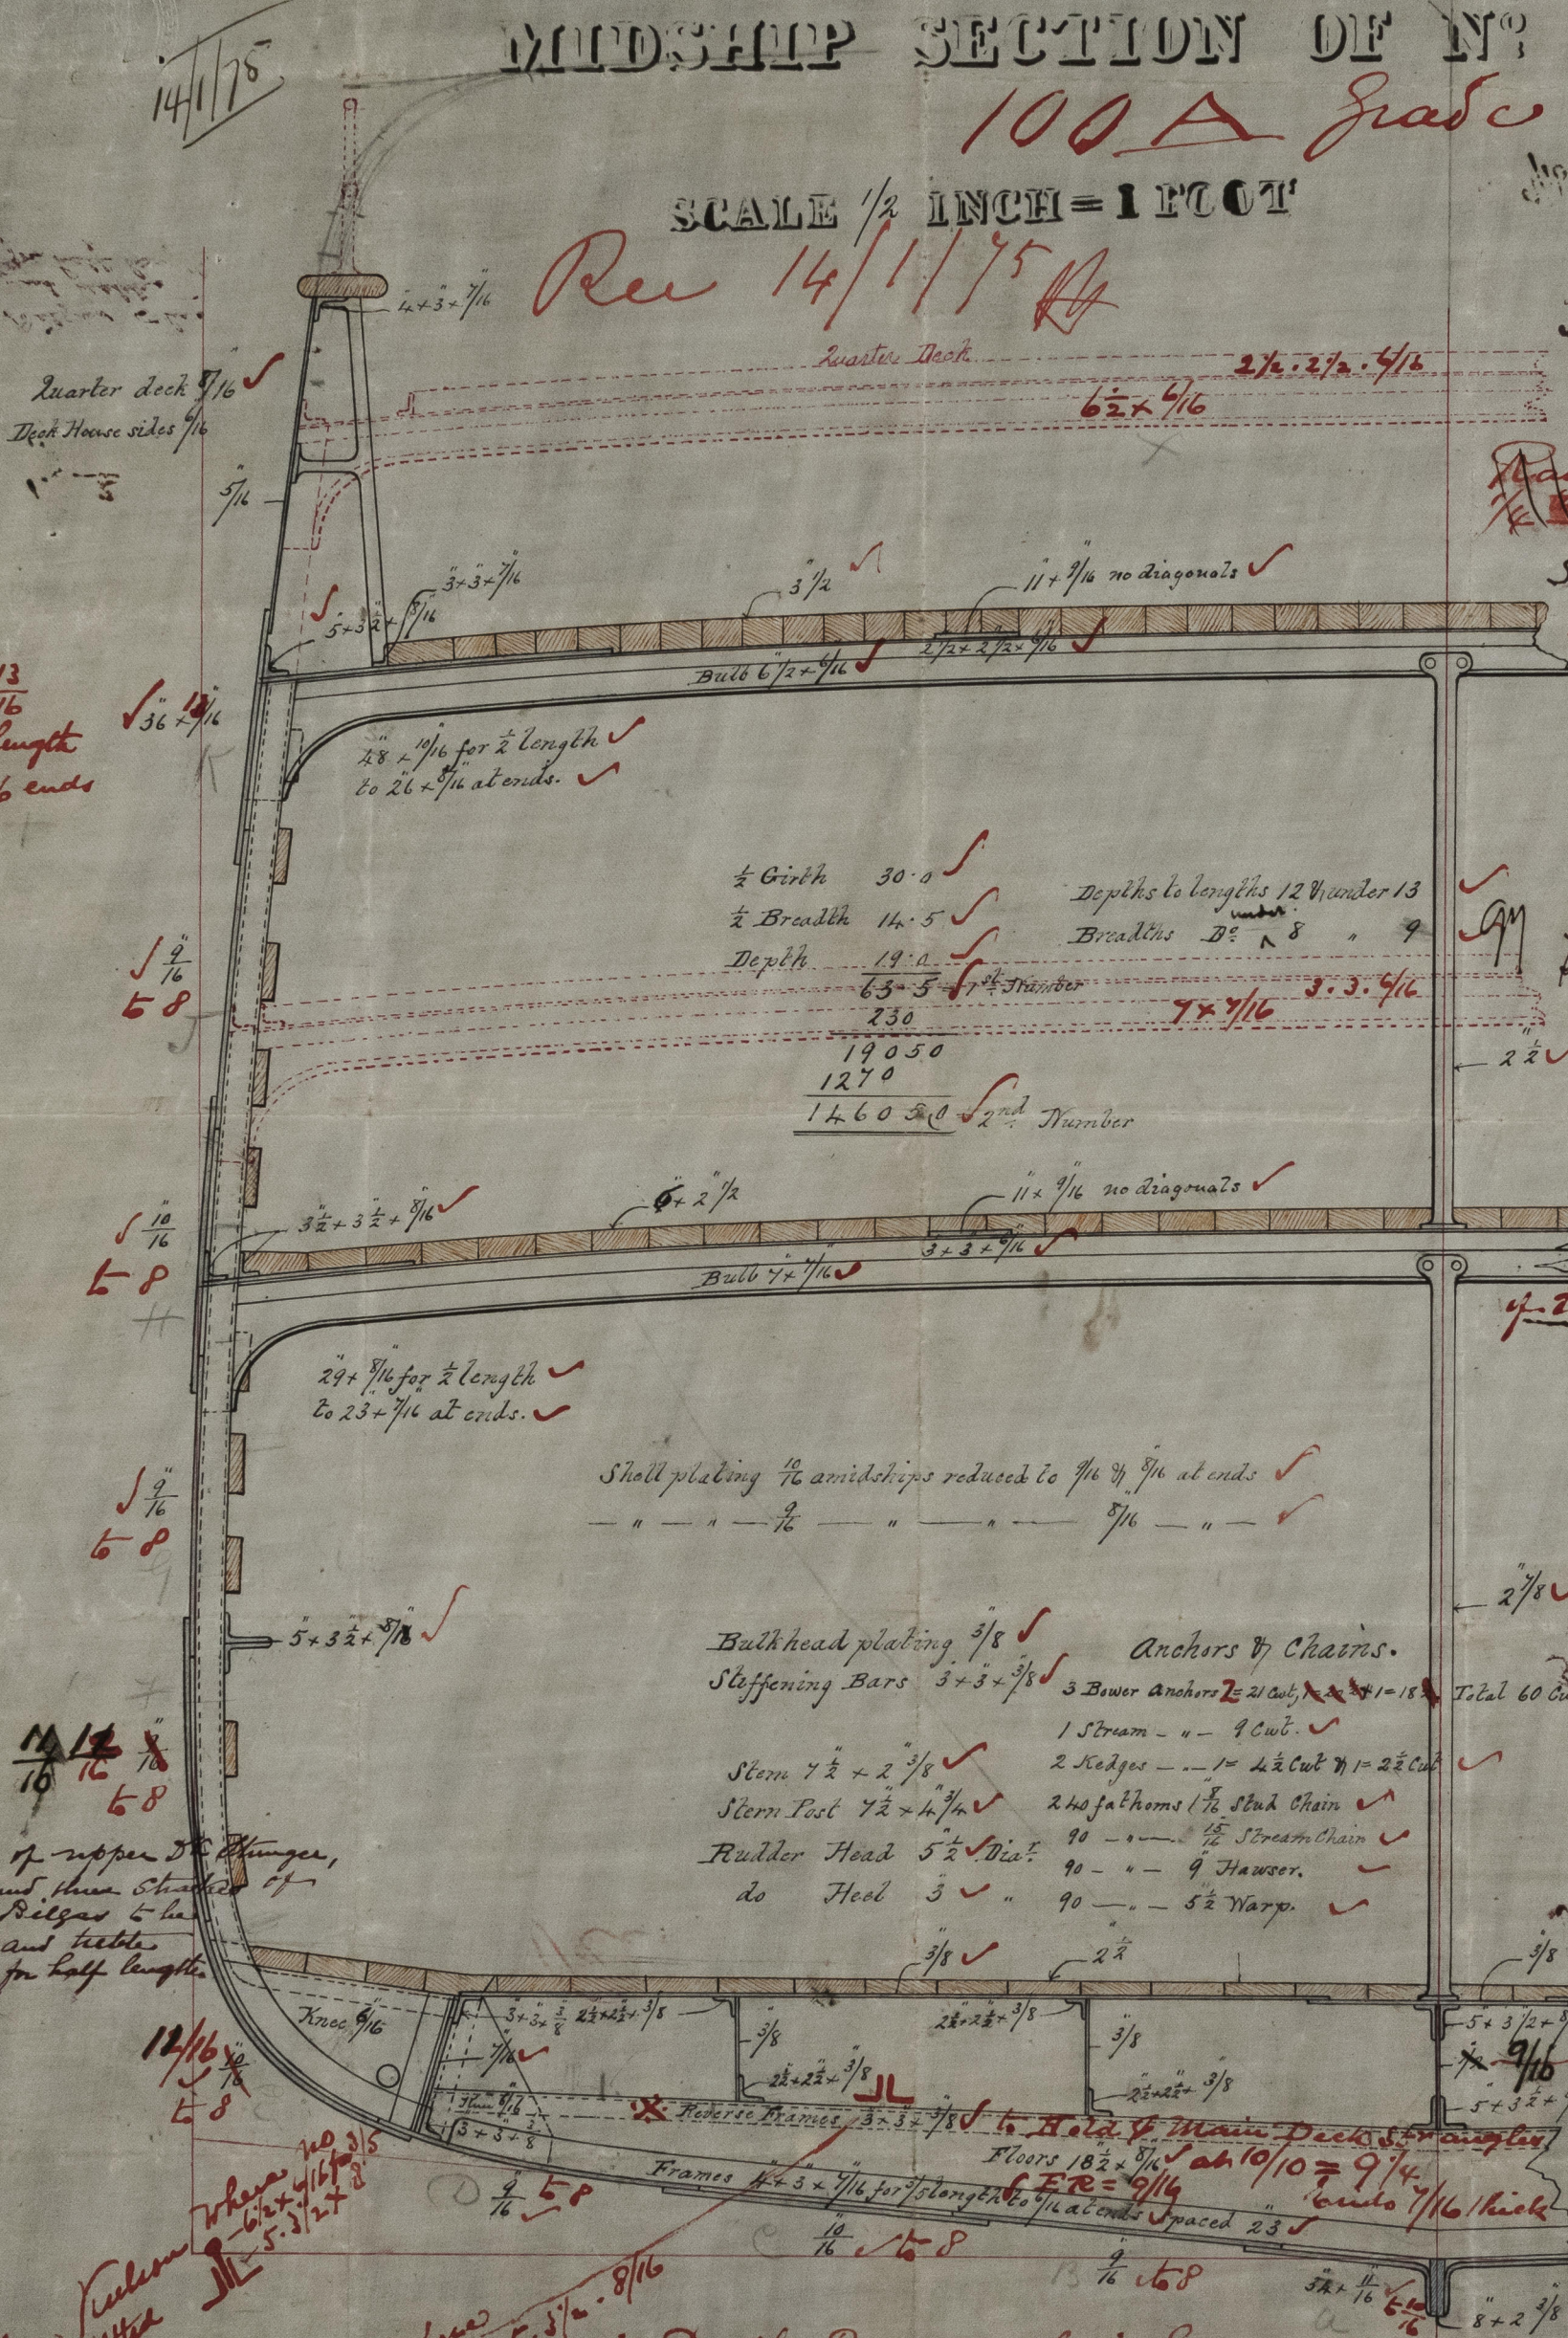

36 x 13/16
for 3/4 length
to 9/16 ends

36 x 13/16
5/8

36 x 13/16
5/8

14 1/2 x 8
5/8

Butt straps of upper & lower
stanchions and three straps of
plating at bilge & keel
1/16 thickness and rivets
riveted for half length

12 1/2 x 8
5/8

Bilge keelson
Sank is fitted

Side keelson
no sank is
also wash plates

* Double Reverse angles in Eng. & Boiler space
to upper turn of Bilges

More Boil plates 1/16 thicker than
amidship plates

1/2 Girth 30.0
1/2 Breadth 14.5
Depth 19.0

Depths to lengths 12 Number 13
Breadths D² 8 " 9

230
19050
1270
1460 2nd Number

Bulkhead plating 3/8
Stiffening Bars 3 x 3 x 3/8

Anchors & Chains.

3 Bower Anchors 2 1/2 Cut, 1 1/2 = 18
1 Stream " 9 Cut
2 Kedges " 1 1/2 = 2 1/2 Cut
2 40 fathoms 1/2 Stud Chain
90 " 1/2 Stream Chain
90 " 9 Hawser
90 " 5 1/2 Warp

Stern 7 1/2 x 2 3/8
Stern Post 7 1/2 x 4 3/4
Rudder Head 5 1/2
do Heel 3

Total 60 Cut.

5. Hold & Main Deck Strapping

Floors 18 1/2 x 8 1/4 10/10 = 9 1/4
Cuts 1/16 thick

LR

© 2021 Lloyd's Register Foundation