


S.S. N^os 193. 194.

Proposed Arrangement of Diagonals on Main Deck, at sides of Engine & Boiler Hatches, in lieu of plating.

Rev 15/12/94

15/12/94

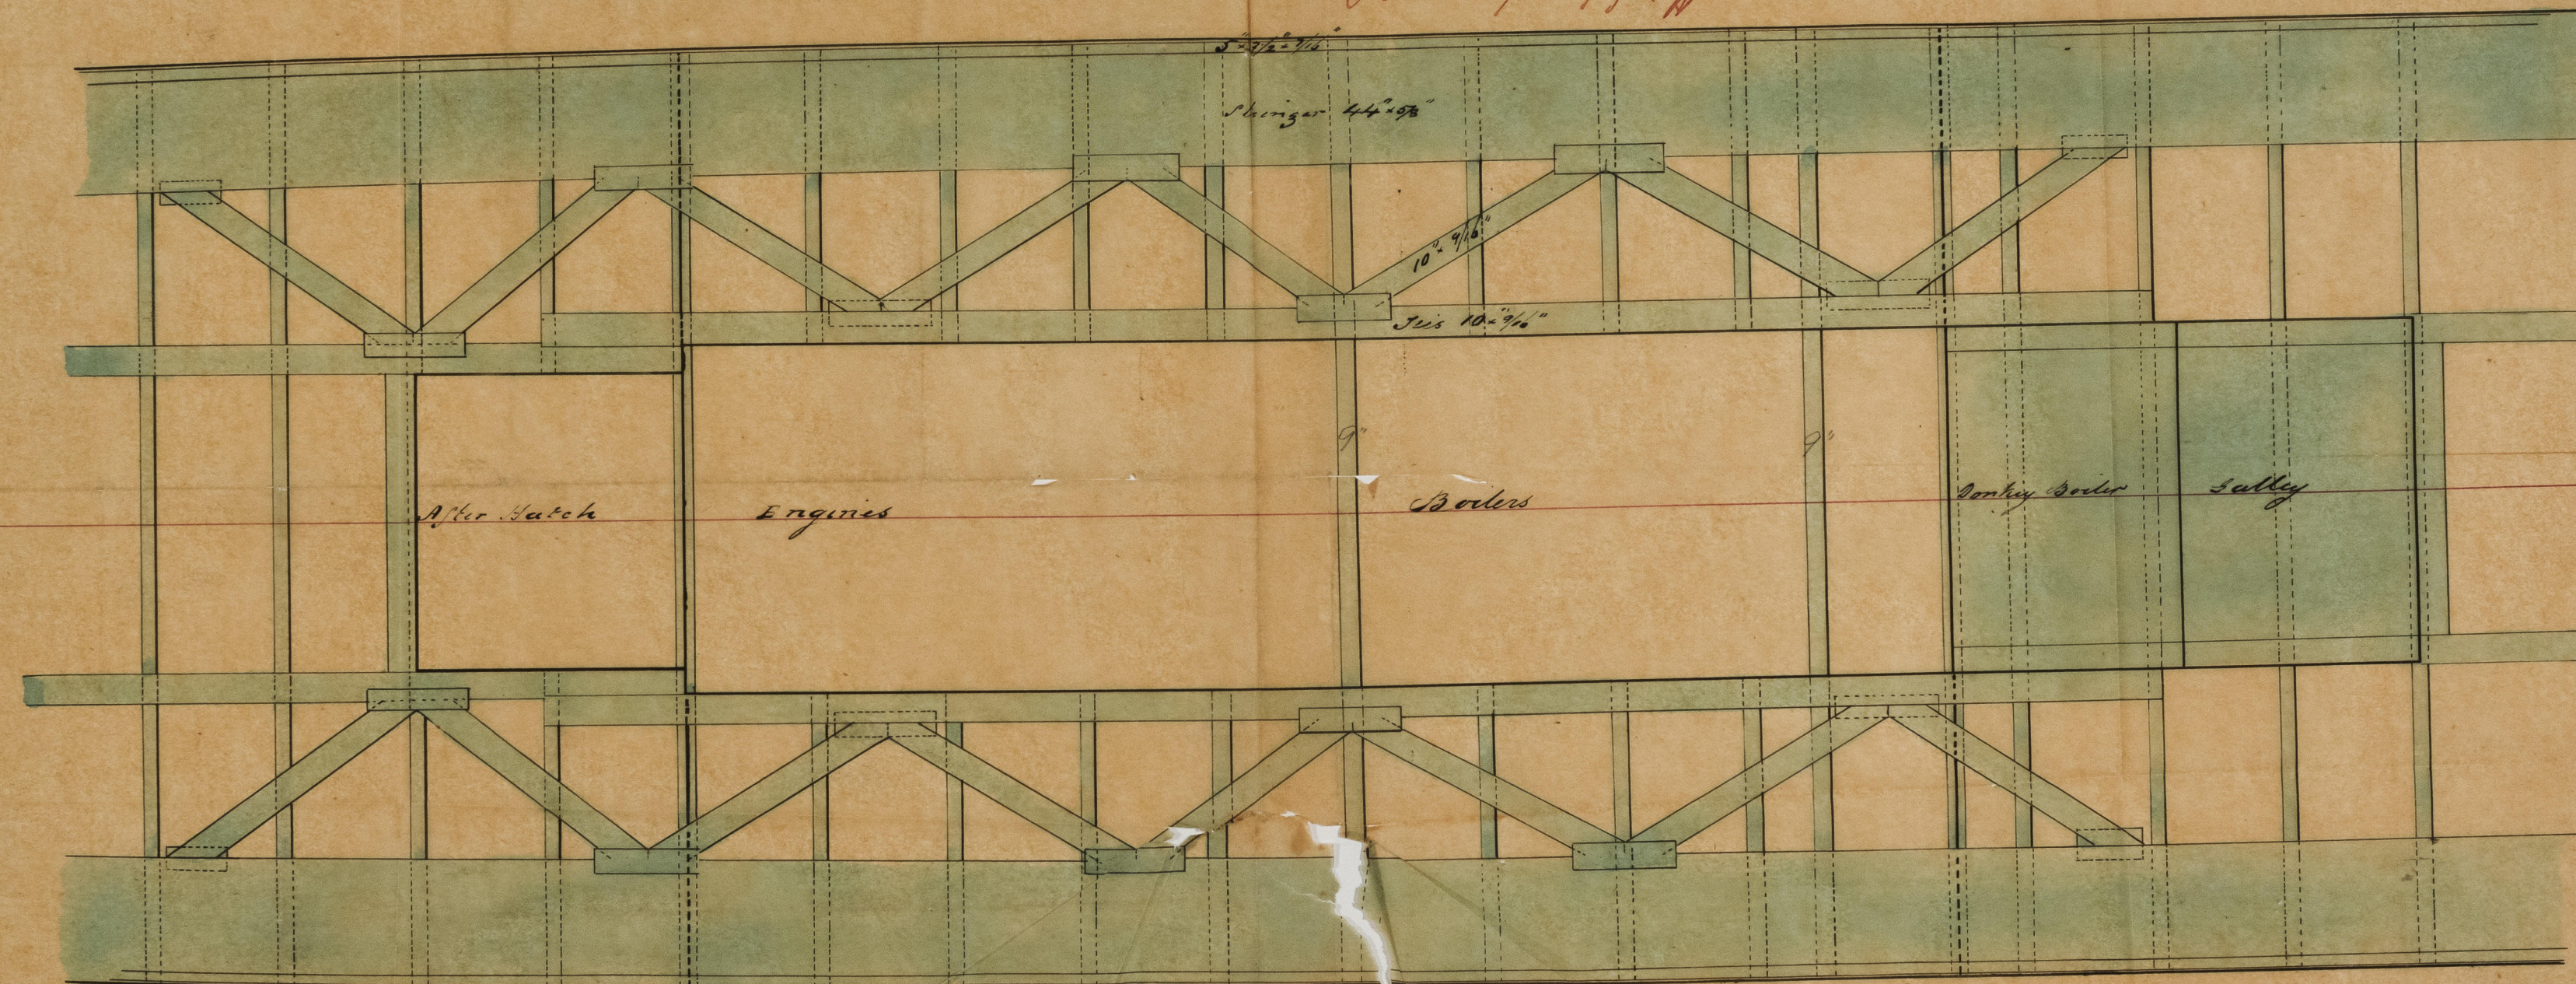

Scale $\frac{1}{4}$ Inch to one Foot

CARRD & CO
ENGINEERS & IRON SHIPBUILDERS

GREENOCK. 15/12/94

180511-0523