


"Naples." Report No. 12908.

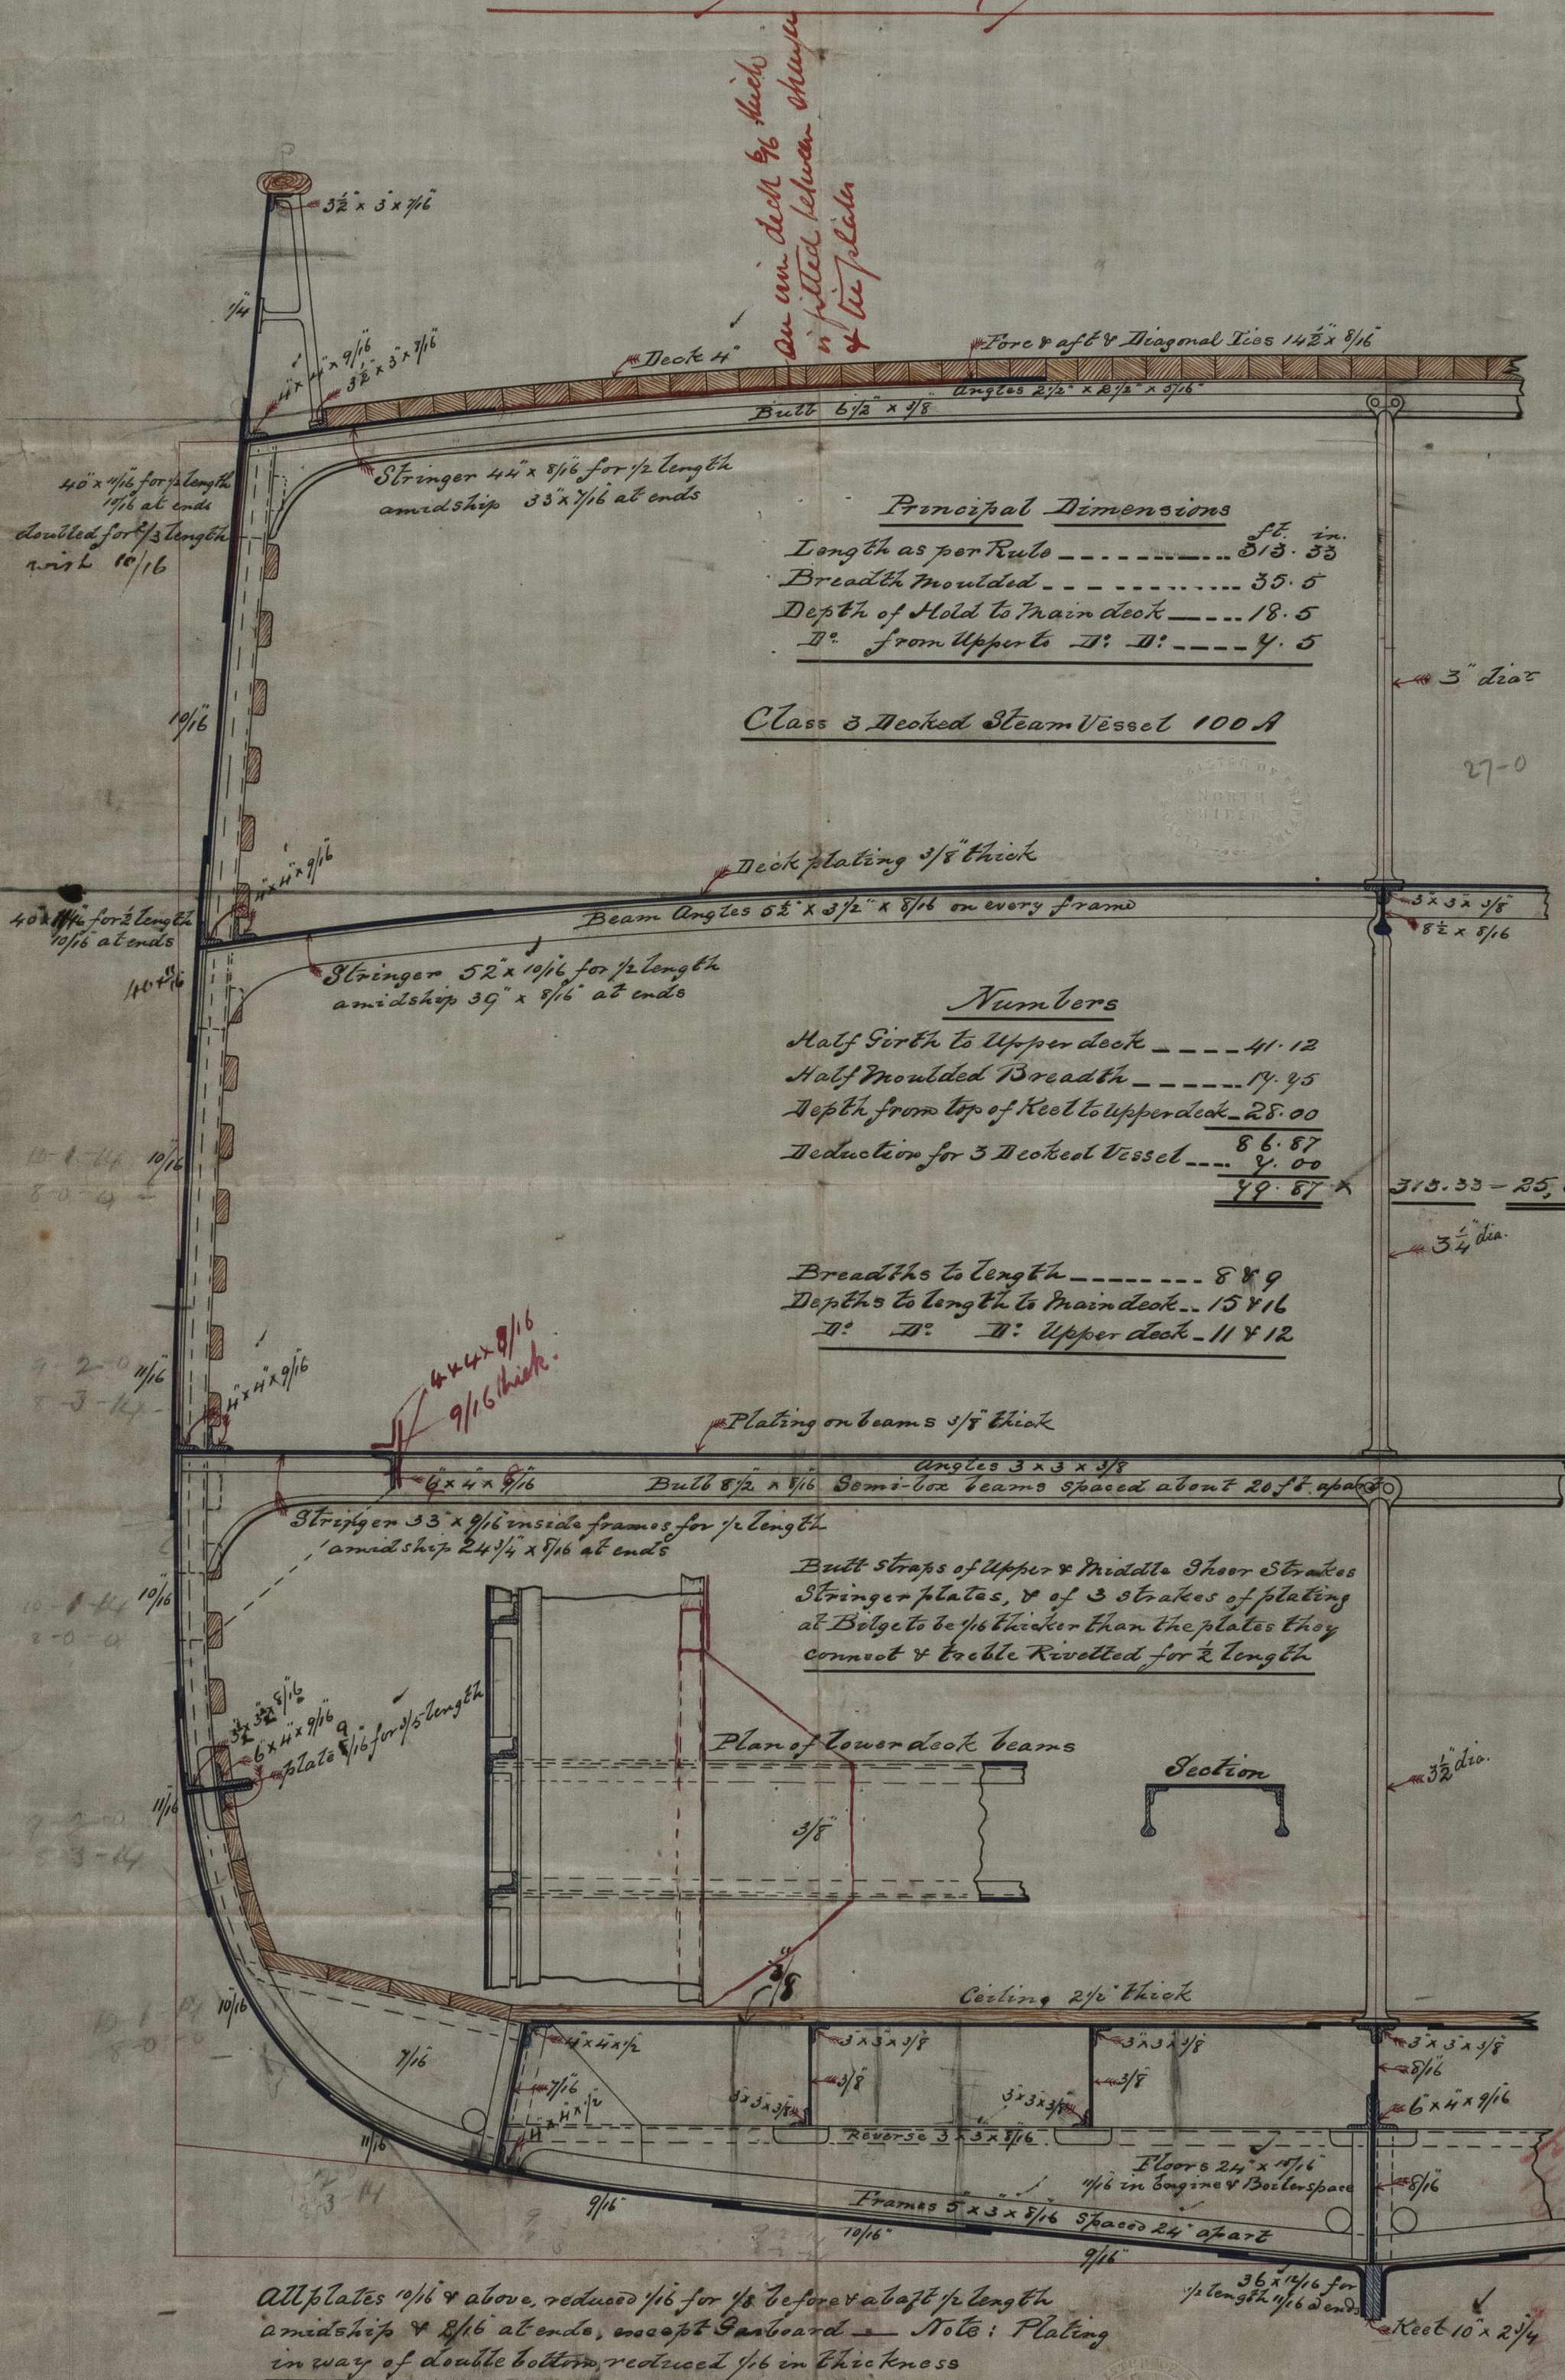

All plates $\frac{10}{16}$ & above, reduced $\frac{1}{16}$ for $\frac{1}{8}$ before & abaft $\frac{1}{2}$ length
in way of double bottom, reduced $\frac{1}{16}$ in thickness

187/7^m

LR 1/1/74

Lloyd's Register
Foundation

IRON SII-0550

Naples 1844

Iron 14647

IRON 511 - 0335

Naples 12908

ss. No 514



© 2021
Lloyd's Register
Foundation