14674

Nomd. "Belfast" No. 87
"Star of Russia" 88
"Majestic" and 89

Report 22.70

To class 100-A.
No. 87.4 and 22.878
Proportions under 8 breadths
and -"- 11 depths in length.

Rec 21/8/73

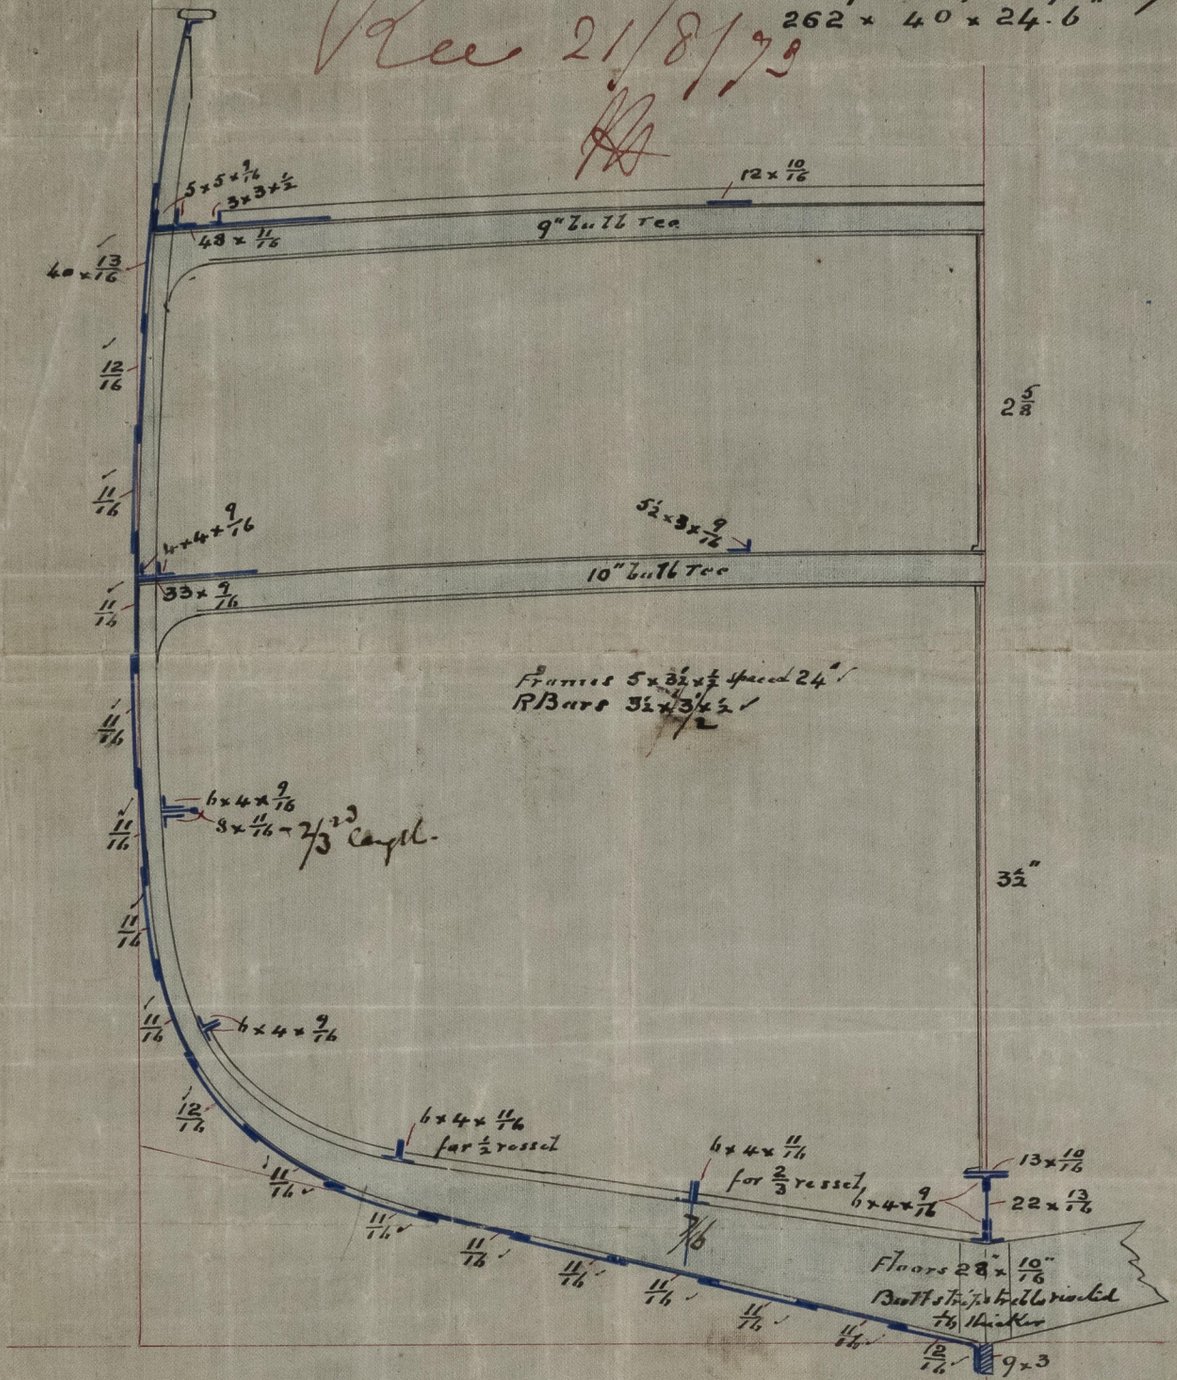

BM
21/8/73

22.8.73

18/8/72

Scale ¼" = 1 Ft

© 2021 Lloyd's Register Foundation
IRON511-0339