
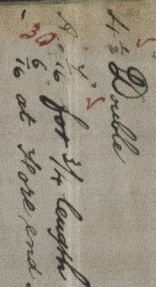


-188 No. 4-
To class 90 A. 1. at Loyds

12-10
11-3
20-9

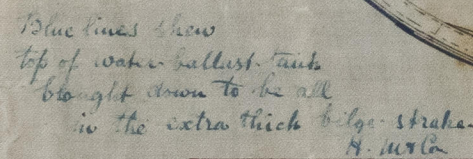

W. J.

IRONS12-0003

14746 Jan-

IRON 512-0003



© 2021

Lloyd's Register
Foundation