

# MIDSHIP SECTION

## S.S. N° 181

**Class 100 A**

**3 Decks**

Scale 1/2" = 1 foot

Numbers to 75

Half breadth 19.25  
Half depth 30.58  
Half girth 48.75



Glasgow Report No. 4068

Note.  
We have put in bottom  
plate to centre keelson  
since section has been  
15/6/74 approved

**Chains and anchors**

2 Bower anchors 33 cwt. 12 st. 12 lb. 3 1/2 tons  
1 " " 32 1/2 " " " 30 7/20  
1 " " 14 1/2 " " " 13 1/4  
1 " " 7 1/4 " " " 3 1/2

300 fathoms 2" steel chain total to 7 1/2 tons  
90 " 1 1/2" steel chain  
90 " 1" steel chain

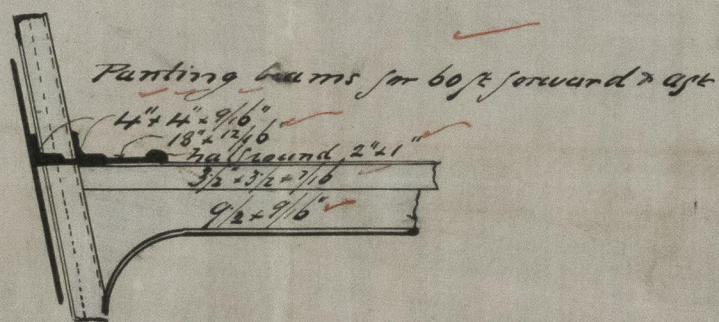

Bulkheads 7/16" x 14" long as 3 1/2" x 14" x 9/16"  
Rudder head 82" pinches 4 1/2" x 14" x 9/16"  
Rudder to keelson  
Steel plating 1/2" double chain  
riveted 5/8" lap 7/8" rivets  
The main 7" upper shear 7" straining plate  
3 struts in the legs bolted 10" x 12"  
with straps 1/6" thicker than plating they are riveted

LONDON & GLASGOW  
ENGINEERING & IRON SHIP BUILDING CO.  
LIMITED  
GLASGOW & COYAN

IRON 512-0111



Noy ds

THE CIV

IRONS12-0111

122

(3 Dec 18)

1000



© 2021

Lloyd's Register  
Foundation