


*Glasgow Works*  
**S.S. N° 181**  
*Rev 14/9/74*  
 SCALE 1/4 INCH TO THE FOOT  
 Showing Vertical Ends in Line of Hold Beams in  
 Engine and Boiler Spaces

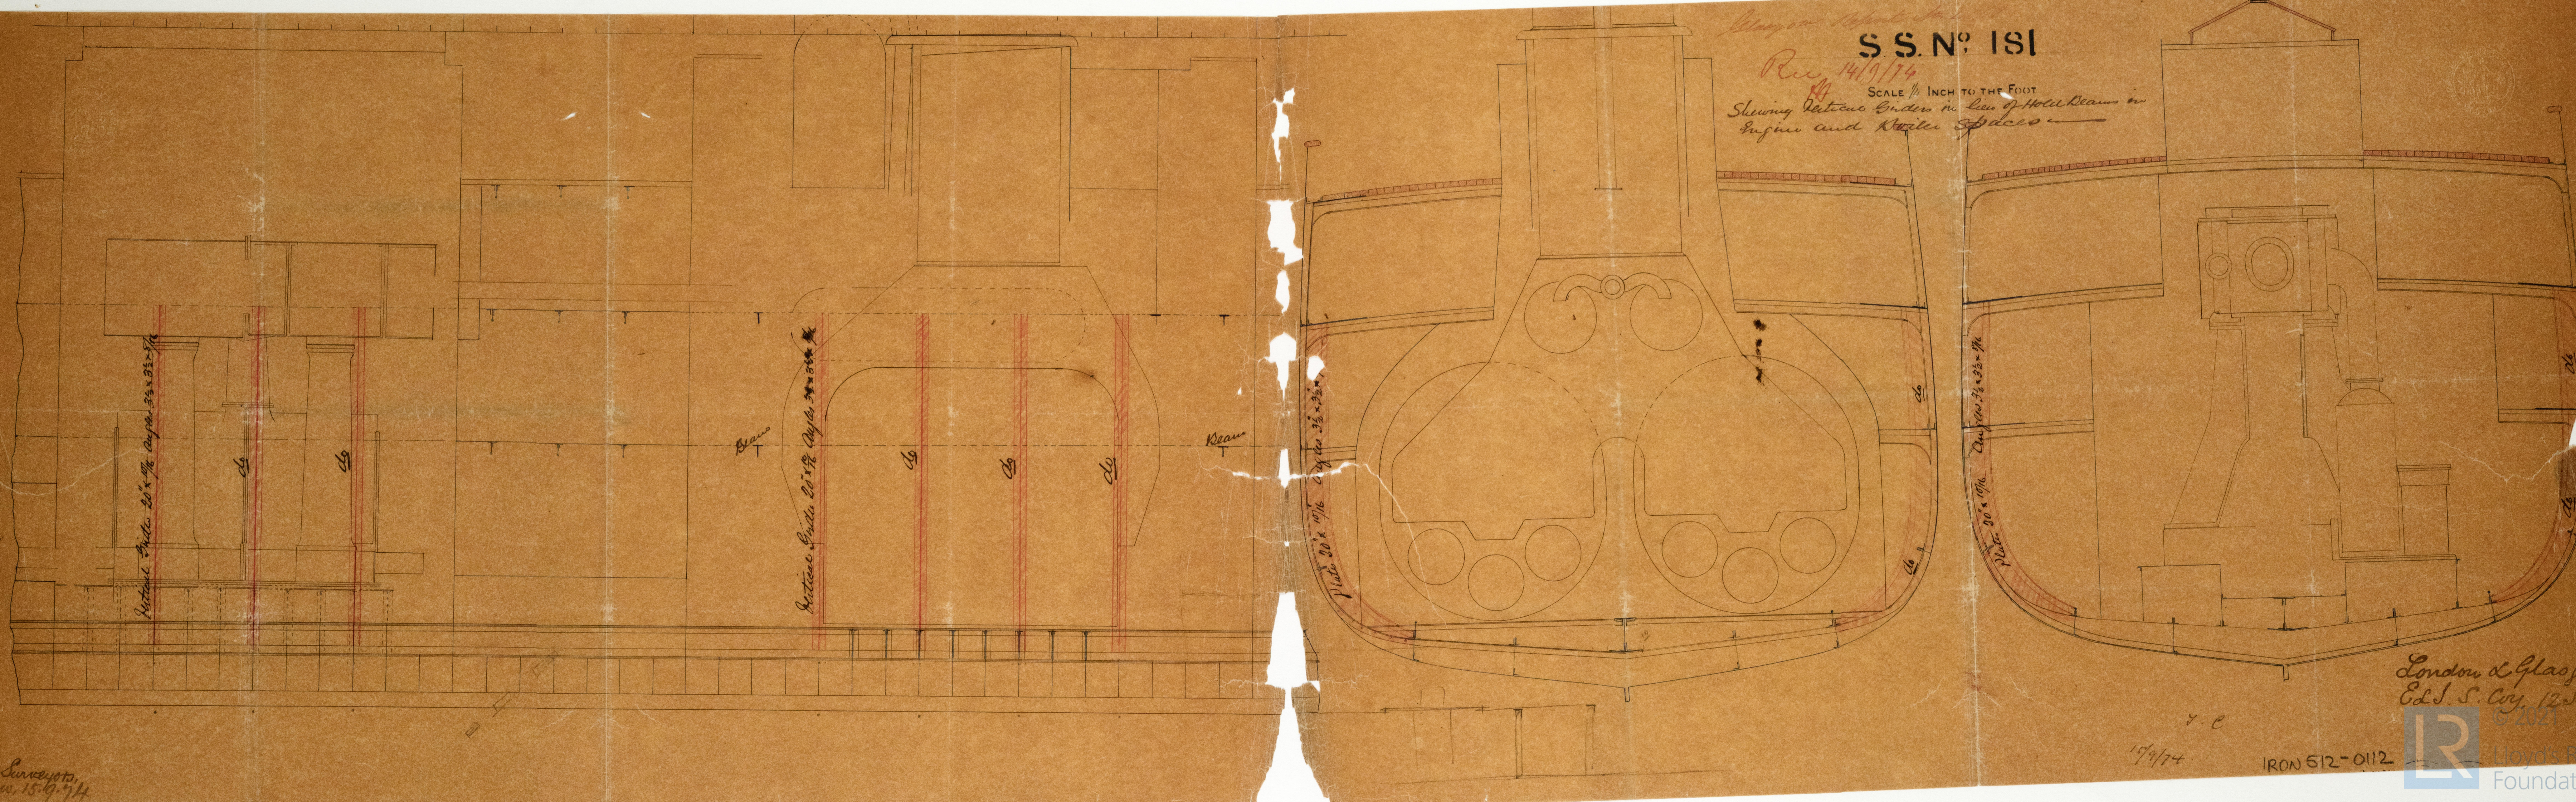

*Letter to Surveyors,  
 Glasgow, 15.9.74*

*L. C.*  
*17/9/74*  
 IRON 512-0112  
 London & Glasgow  
 Ed. S. Coy. 12 Sept-  
 © 2021  
 Lloyd's Register  
 Foundation