



Ship "Bann" Report No 11. 1914


Sections of masts & yards 147 ship. Built under 1872 Rules.
 Similar to those approved for the
 Ship "Foyle". Report 10. 960.

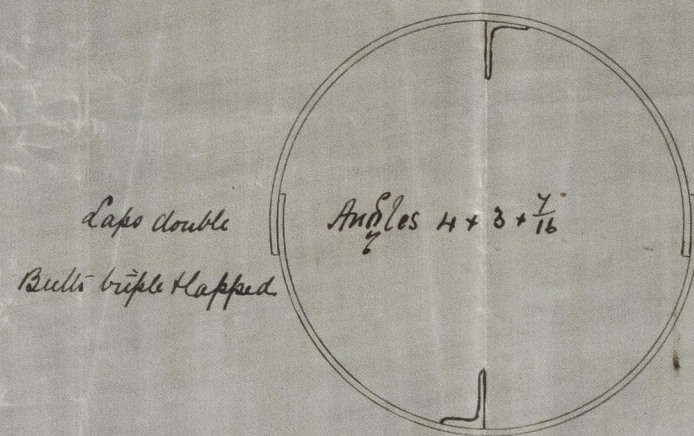


Fore mast length over all = 87.10
 " " of housing 26.10
 " " Head 15.0
 Base at head 30 inches
 " " Horns 24 1/2
 " " Partners 20 3/4
 " " Keel 22 1/2
 Plating 1/2 in way of meeting 1/2 head & keel

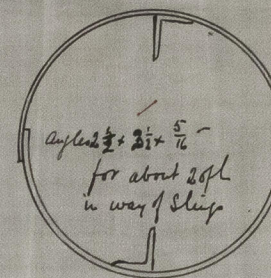


Fore main lower yard
 Length over all 79.0
 Base at center 19 in
 " " 1st Quarter 18 1/2
 " " 2 " 17 1/2
 " " 3 " 14 1/2
 " " Sm d 9 1/2

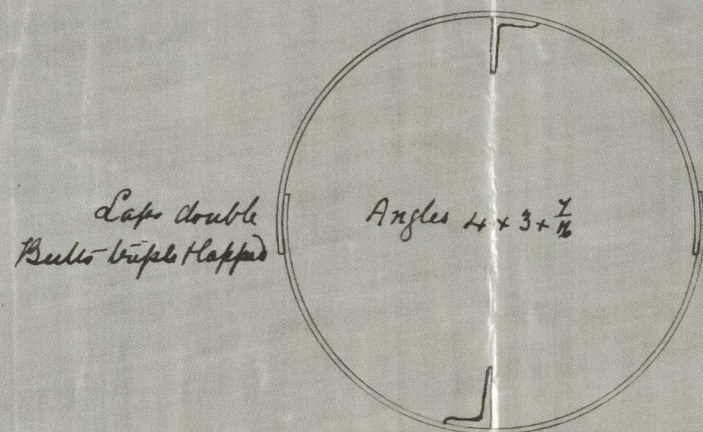


Main mast length over all 89.10
 " " of housing 24.10
 " " Head 15.0
 Base at head 30 inches
 " " Horns 24 1/2
 " " Partners 20 3/4
 " " Keel 22 1/2
 Plating in way of meeting 1/2 head & keel 1/2

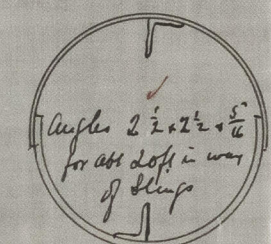


Fore main lower topsail yards
 Length over all 69.0
 Base at center 14 inches
 " " 1st Quarter 16 1/2
 " " 2 " 15 1/2
 " " 3 " 13 1/2
 " " Sm d 8 1/2

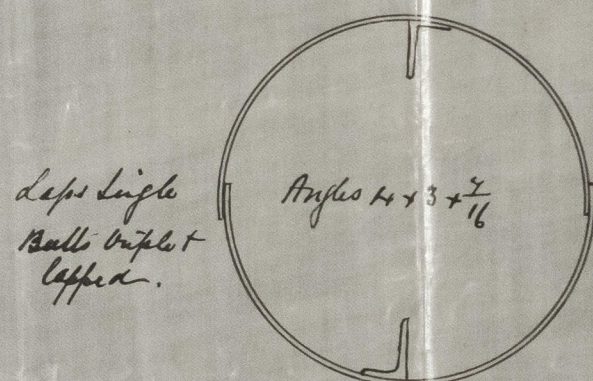


Main mast length over all 82.10
 " " of housing 25.10
 " " Head 13.6
 Base at head 19 inches
 " " Horns 22 1/2
 " " Partners 20 1/2
 " " Keel 2 1/2
 Plating in way of meeting 1/2 head & keel 1/2

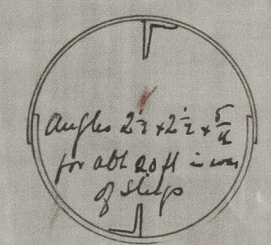

Crossjack yard
 Base at center 16 in
 " " 1st Quarter 14 1/2
 " " 2 " 13 1/2
 " " 3 " 11 1/2
 " " Sm d 7 1/2

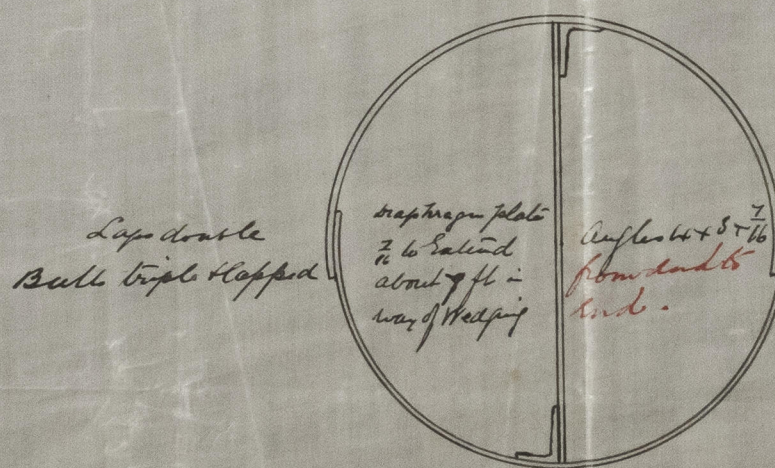

Mast & sprit length outside bed 26 ft
 Base at keel 27 inches
 " " Bed 32 1/2
 " " Cap 21 1/2
 Plating in way of Bed & keel 1/2
 " " Cap 1/2

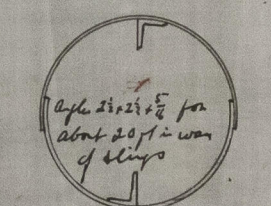

Main lower topsail yard
 Base at center 14 in
 " " 1st Quarter 13 1/2
 " " 2 " 12 1/2
 " " 3 " 10 1/2
 " " Sm d 7

Mast & sprit doubled in way of meeting

J. R. Oswald
 Partner
 Sunderland

all red. with alterations. as made for the vessel
 J.R. 25/5/1915

all yards doubled in way of ship
 all seams in yards single riveted
 Butts triple lapped