


"Martin" Report No 12961.

No. 318

7/12/74 Midship Section Rev 7/12/74  
Scale of 1/2 inch = 1 foot

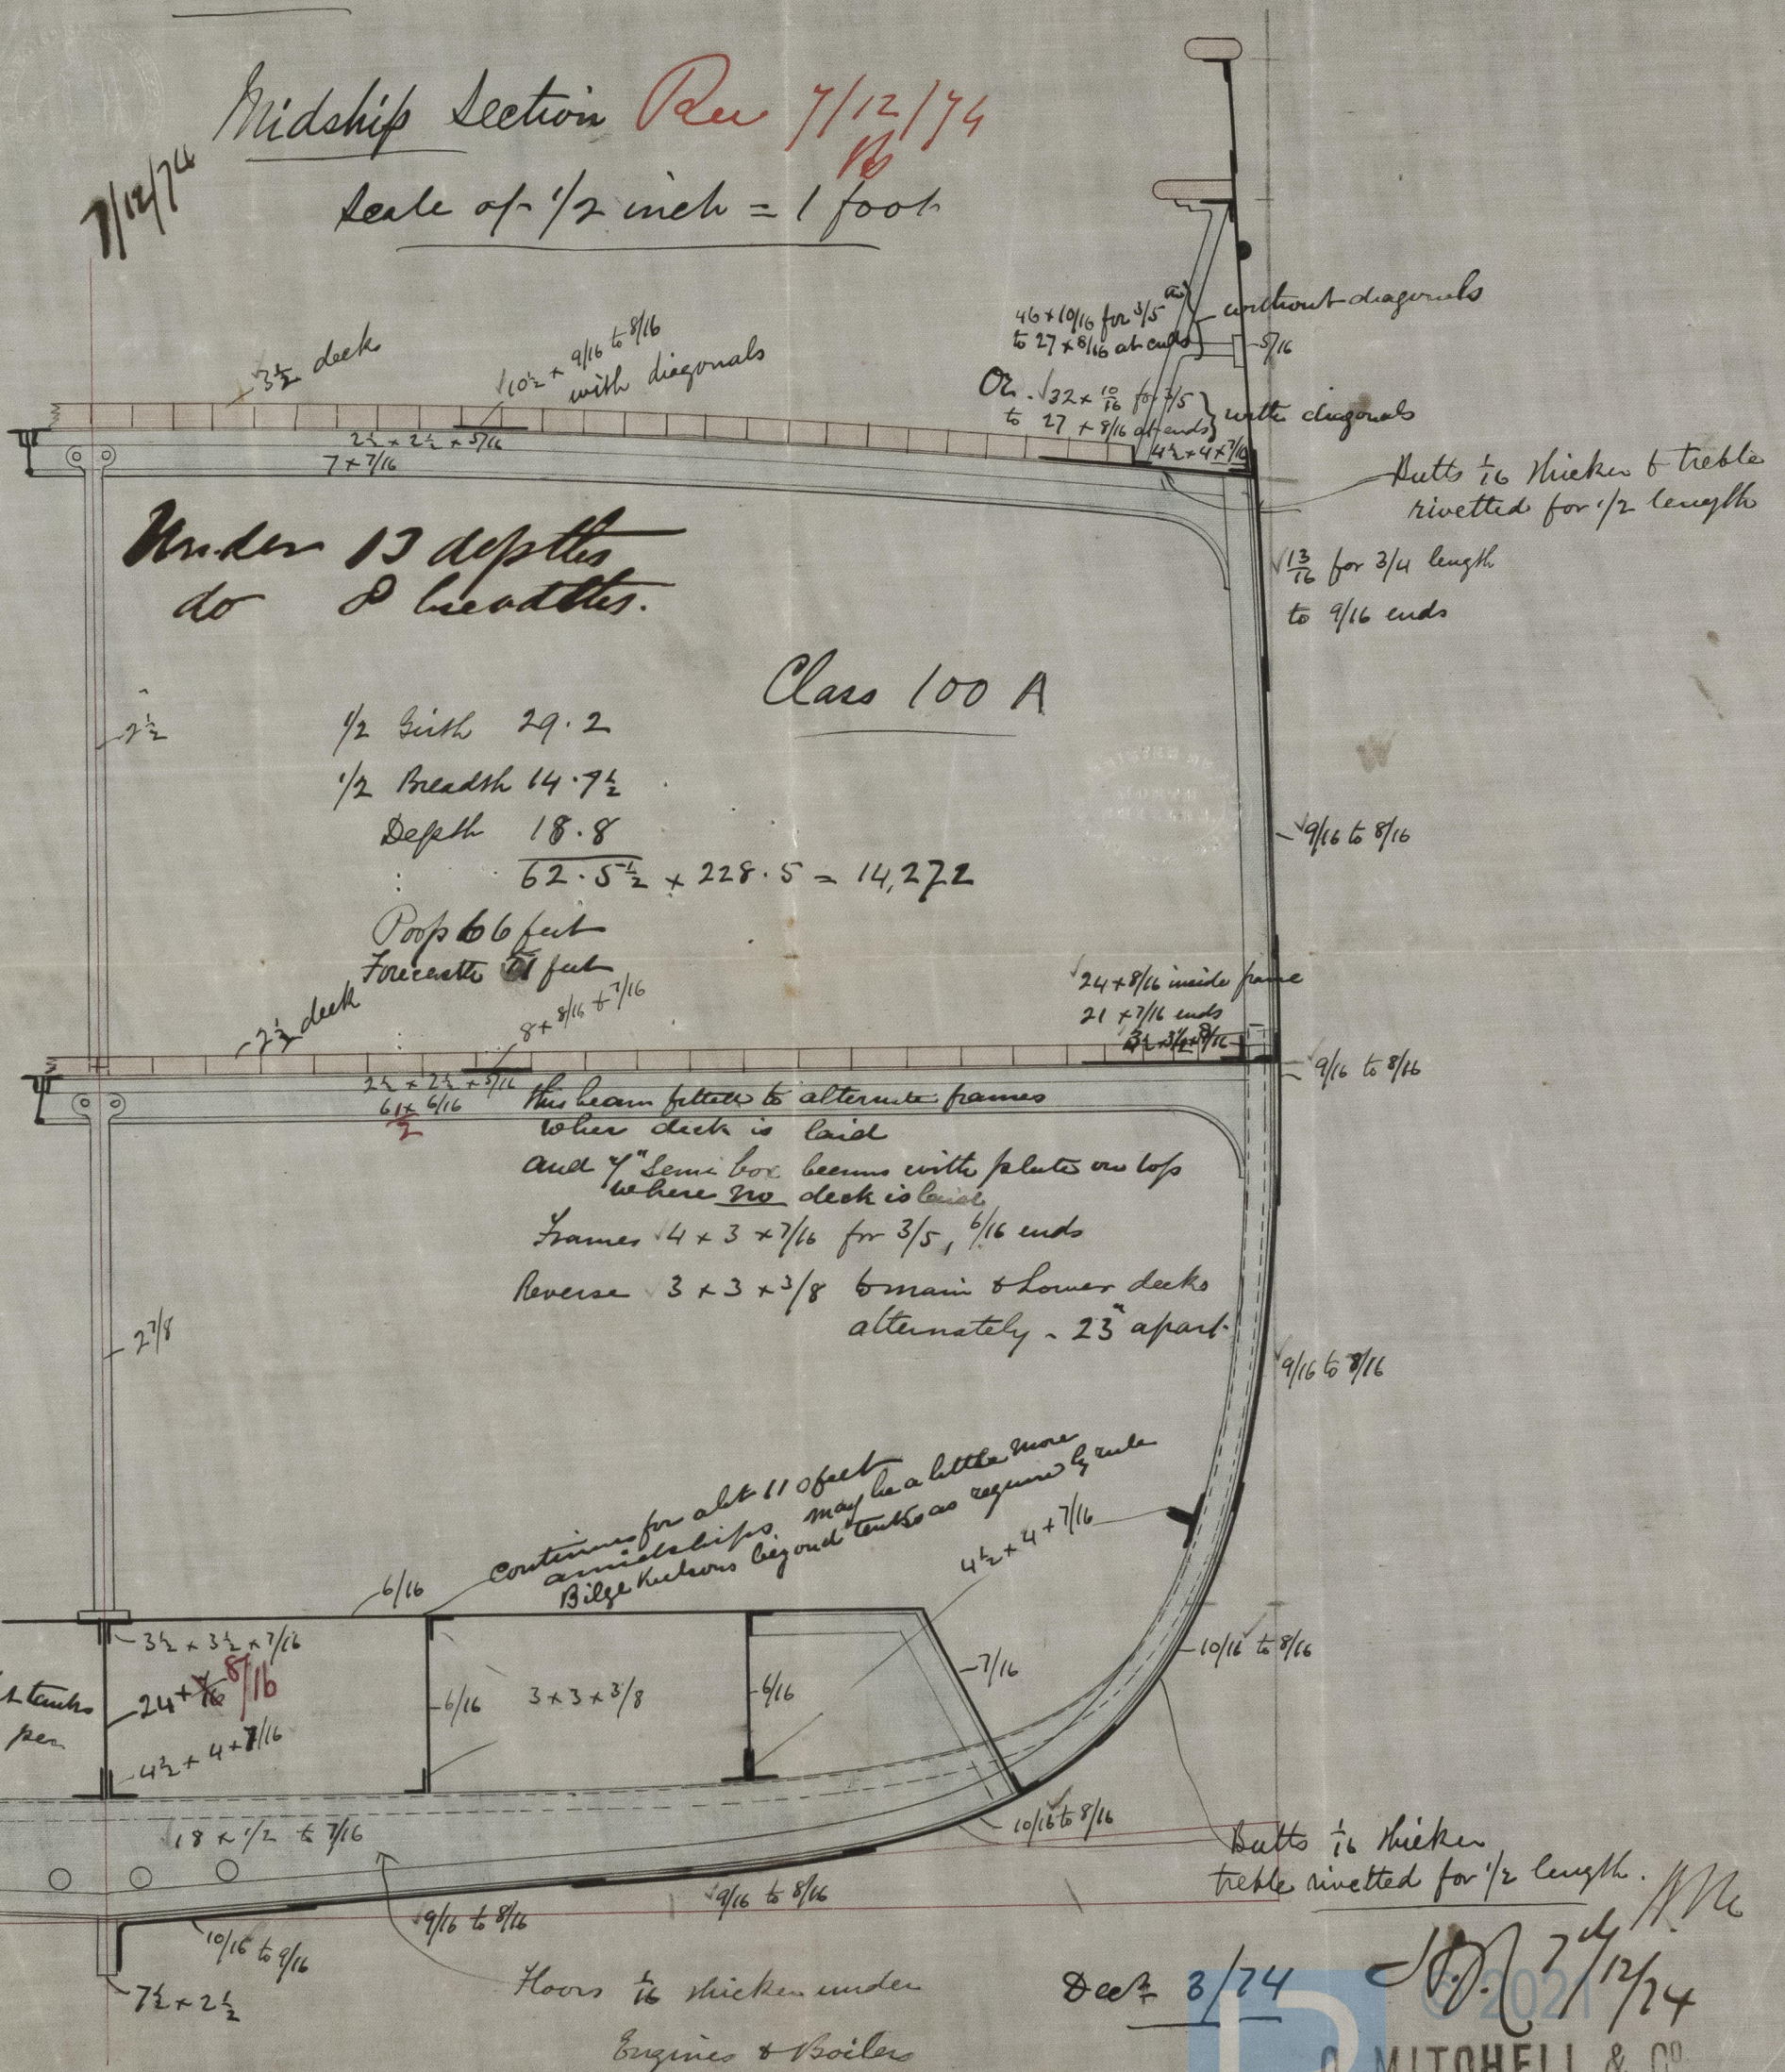

Dec 3/74

7/12/74

O. MITCHELL & CO  
SHIPBUILDERS,

NEWCASTLE-ON-TYNE

IRON 512 - 0195