Sept 19th /74

MID SECTION.

SAILING SHIP No 68.

DIMENSIONS.

Length of Keel & Forerake	220 ft
Breadth Moulded	36 "
Depth "	22"-6½
" in Hold to Top of Floor	21-3½
" " " " " Ceiling	21"-1

Rec 22/3/74

SCALE ¾" INCH = 1 FOOT.

Traced by A.Gh
Compared " A.Gh & W.D

Half Girt	35'-0"
" Beam	17'-6"
Whole Depth	23'-3"
	75·9
	218·75
	16570·31
	1657·03
	18227·34

1st Number
2nd No
Equipment No

Under 10 Depths
" 7 Breadths.

To Class 100.A.

Rec'd 21/9/74
Rec'd 19/9/74
F.S.

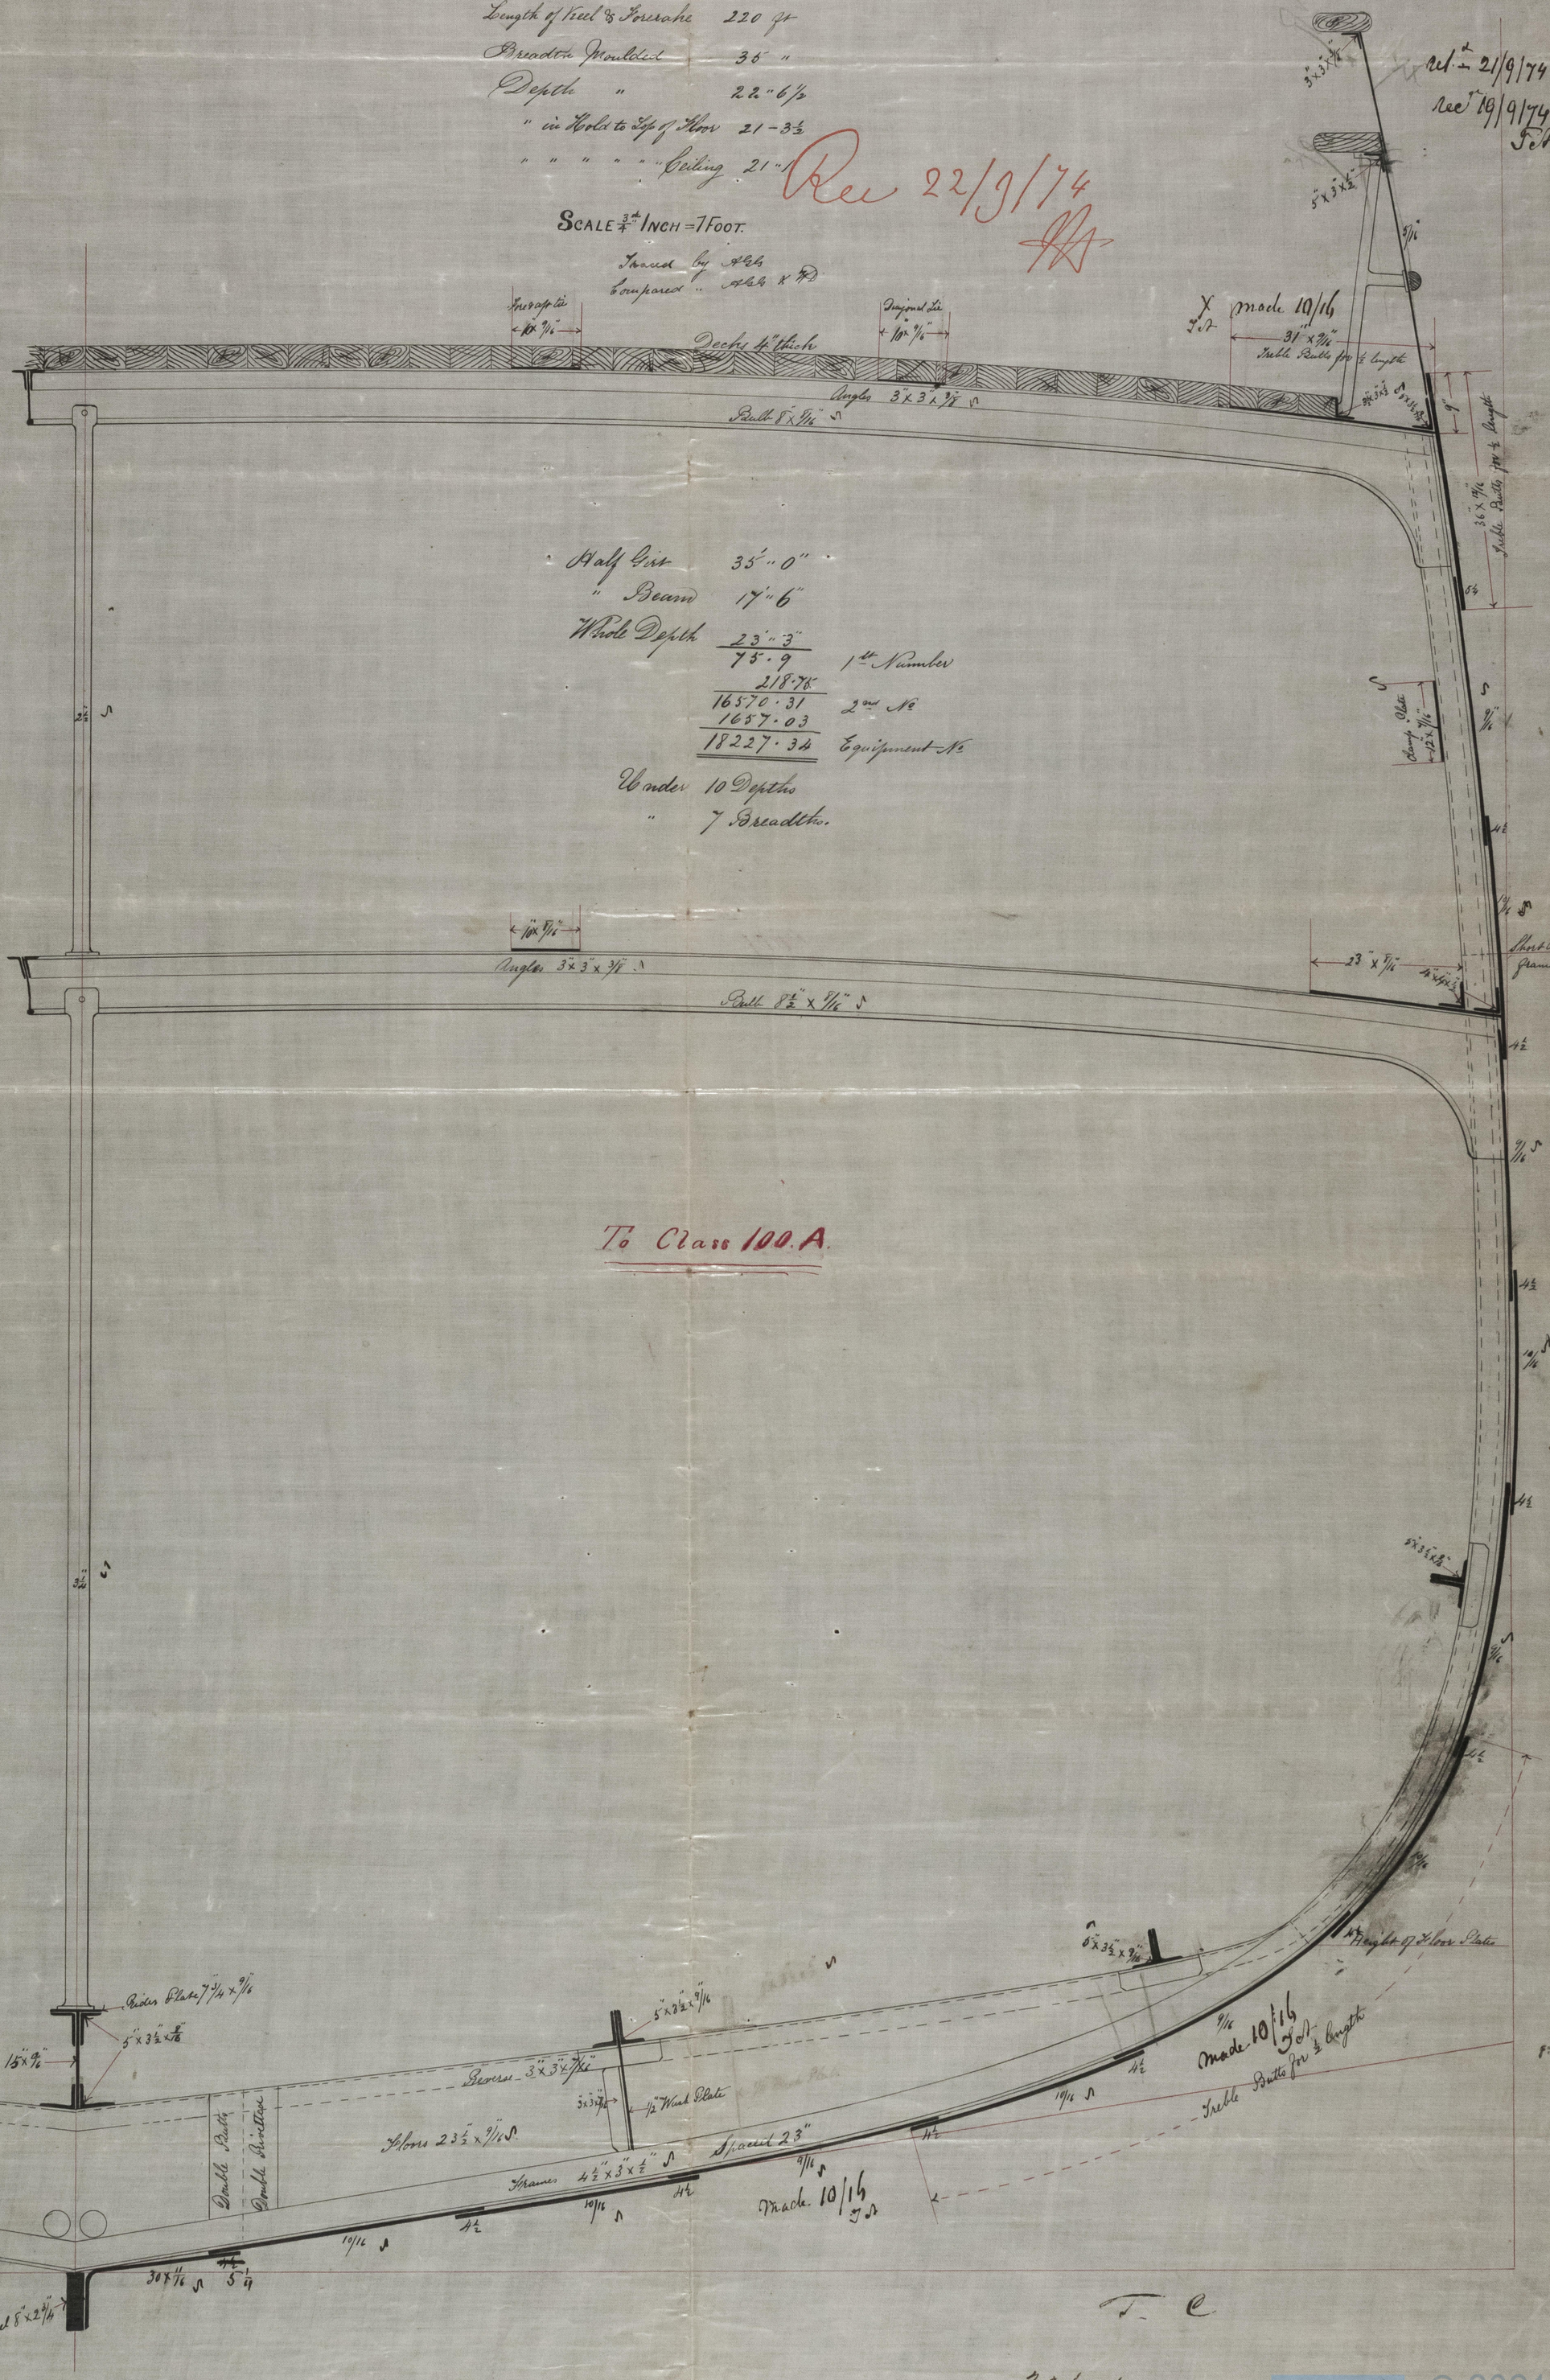

Letter to Mr Alexander
22/9/74

22/9/74

© 2021 Lloyd's Register Foundation

IRONSIZ-0224