

Scale $\frac{1}{4}$ Inch = one Foot


20/4/75

WILLIAM HAMILTON & CO

Shipbuilders.
PORT GLASGOW.

$$\frac{19}{4} \sqrt{75}$$

Rec: 30-9-75

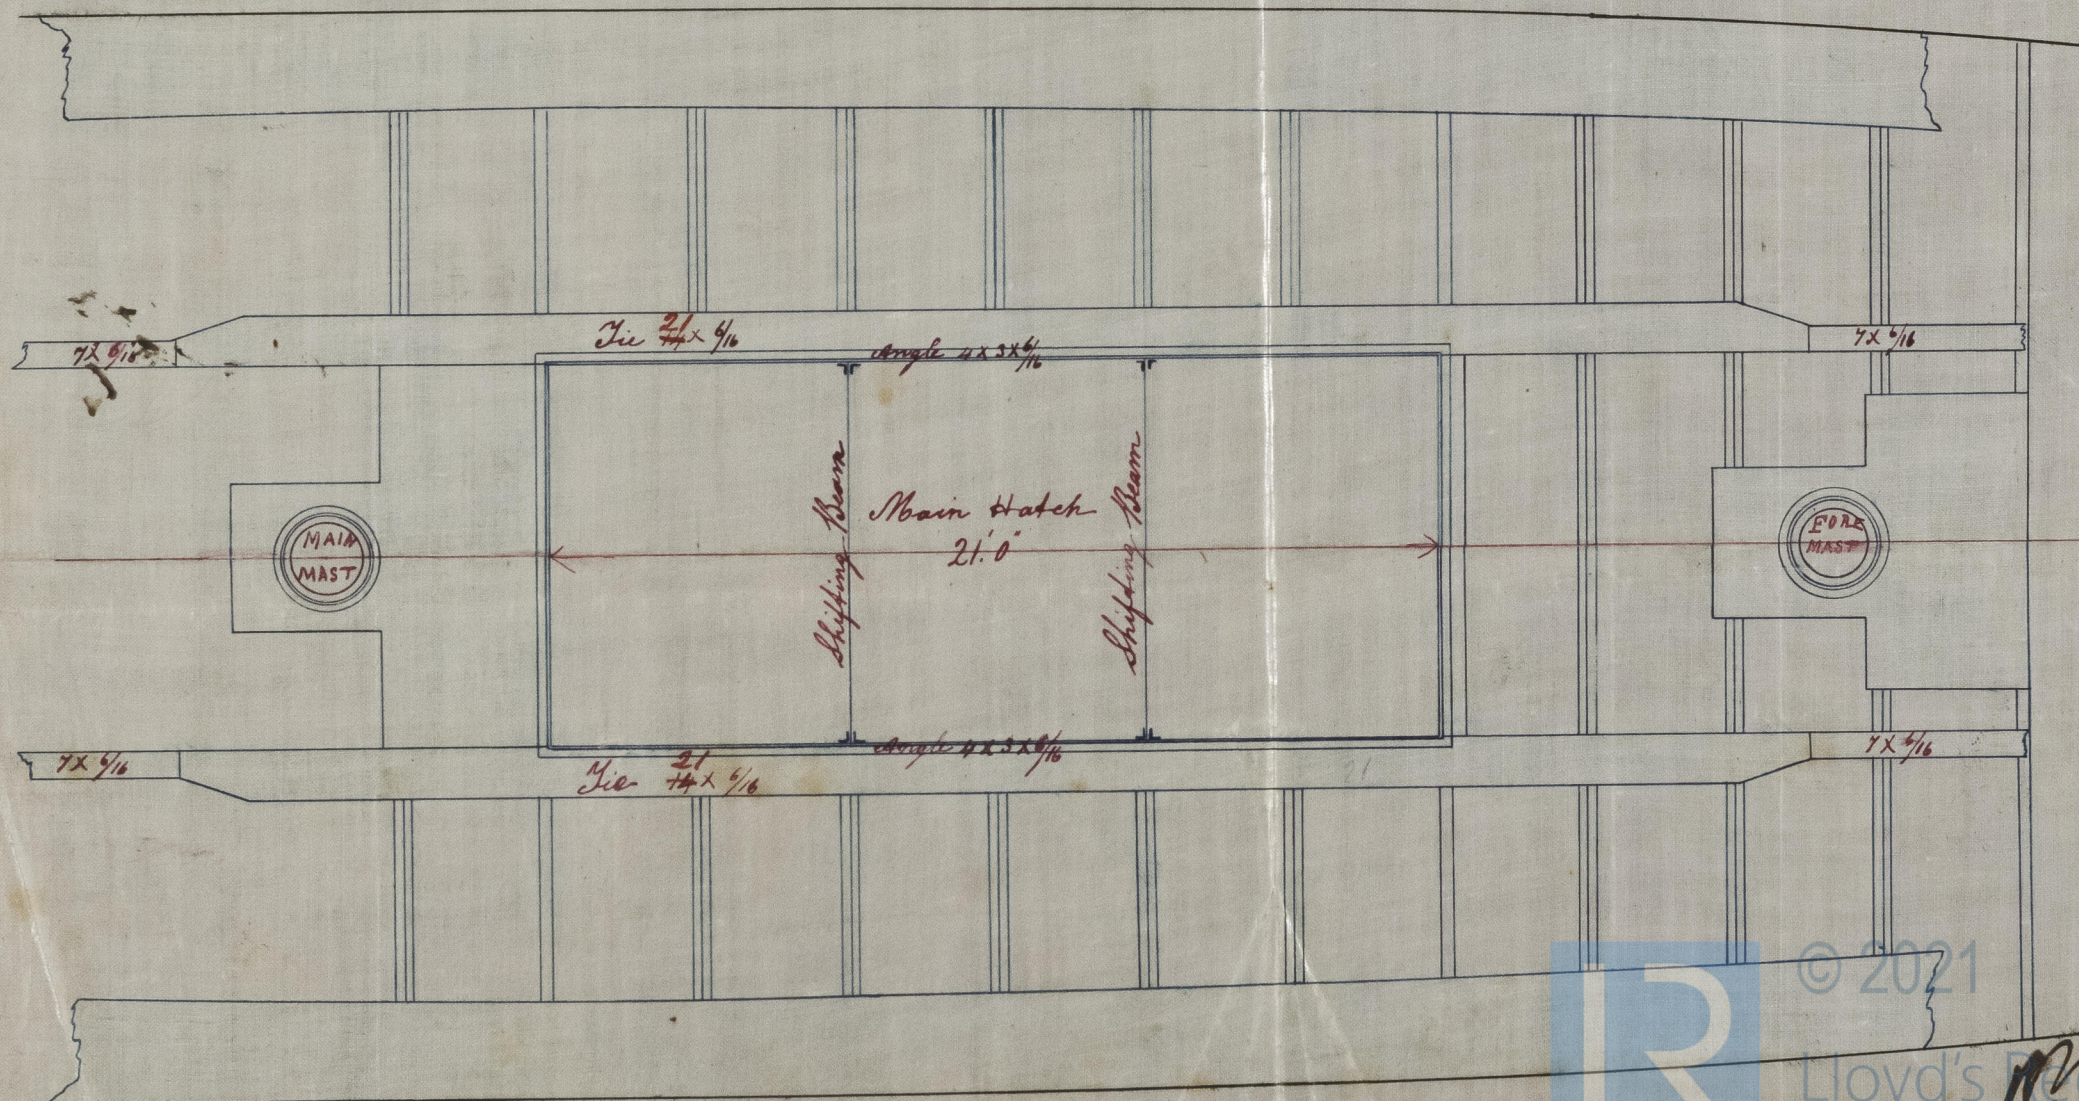

IRONSIZ - 0242

20/4/78

20/4/70