

# MIDSHIP

# SECTION

N<sup>o</sup> 19.

and 19.

15150

18 Ship Britannia Report 11.22.5  
19 "First Lancashire" 11.29.6


LENGTH for Lloyd's  
LENGTH P.P. 2  
BREADTH EXTREME 2  
DEPTH top of keel 9  
to top of upper deck beam 5 1/2  
to top of floor 5 1/2

NUMERALS 50  
Depth moulded to top of keel 51  
Half breadth 25 1/2  
Breadth 51

Class 1


A per rules July 1894  
Under 6 feet the depth as length.

Per 15/2/15  
11

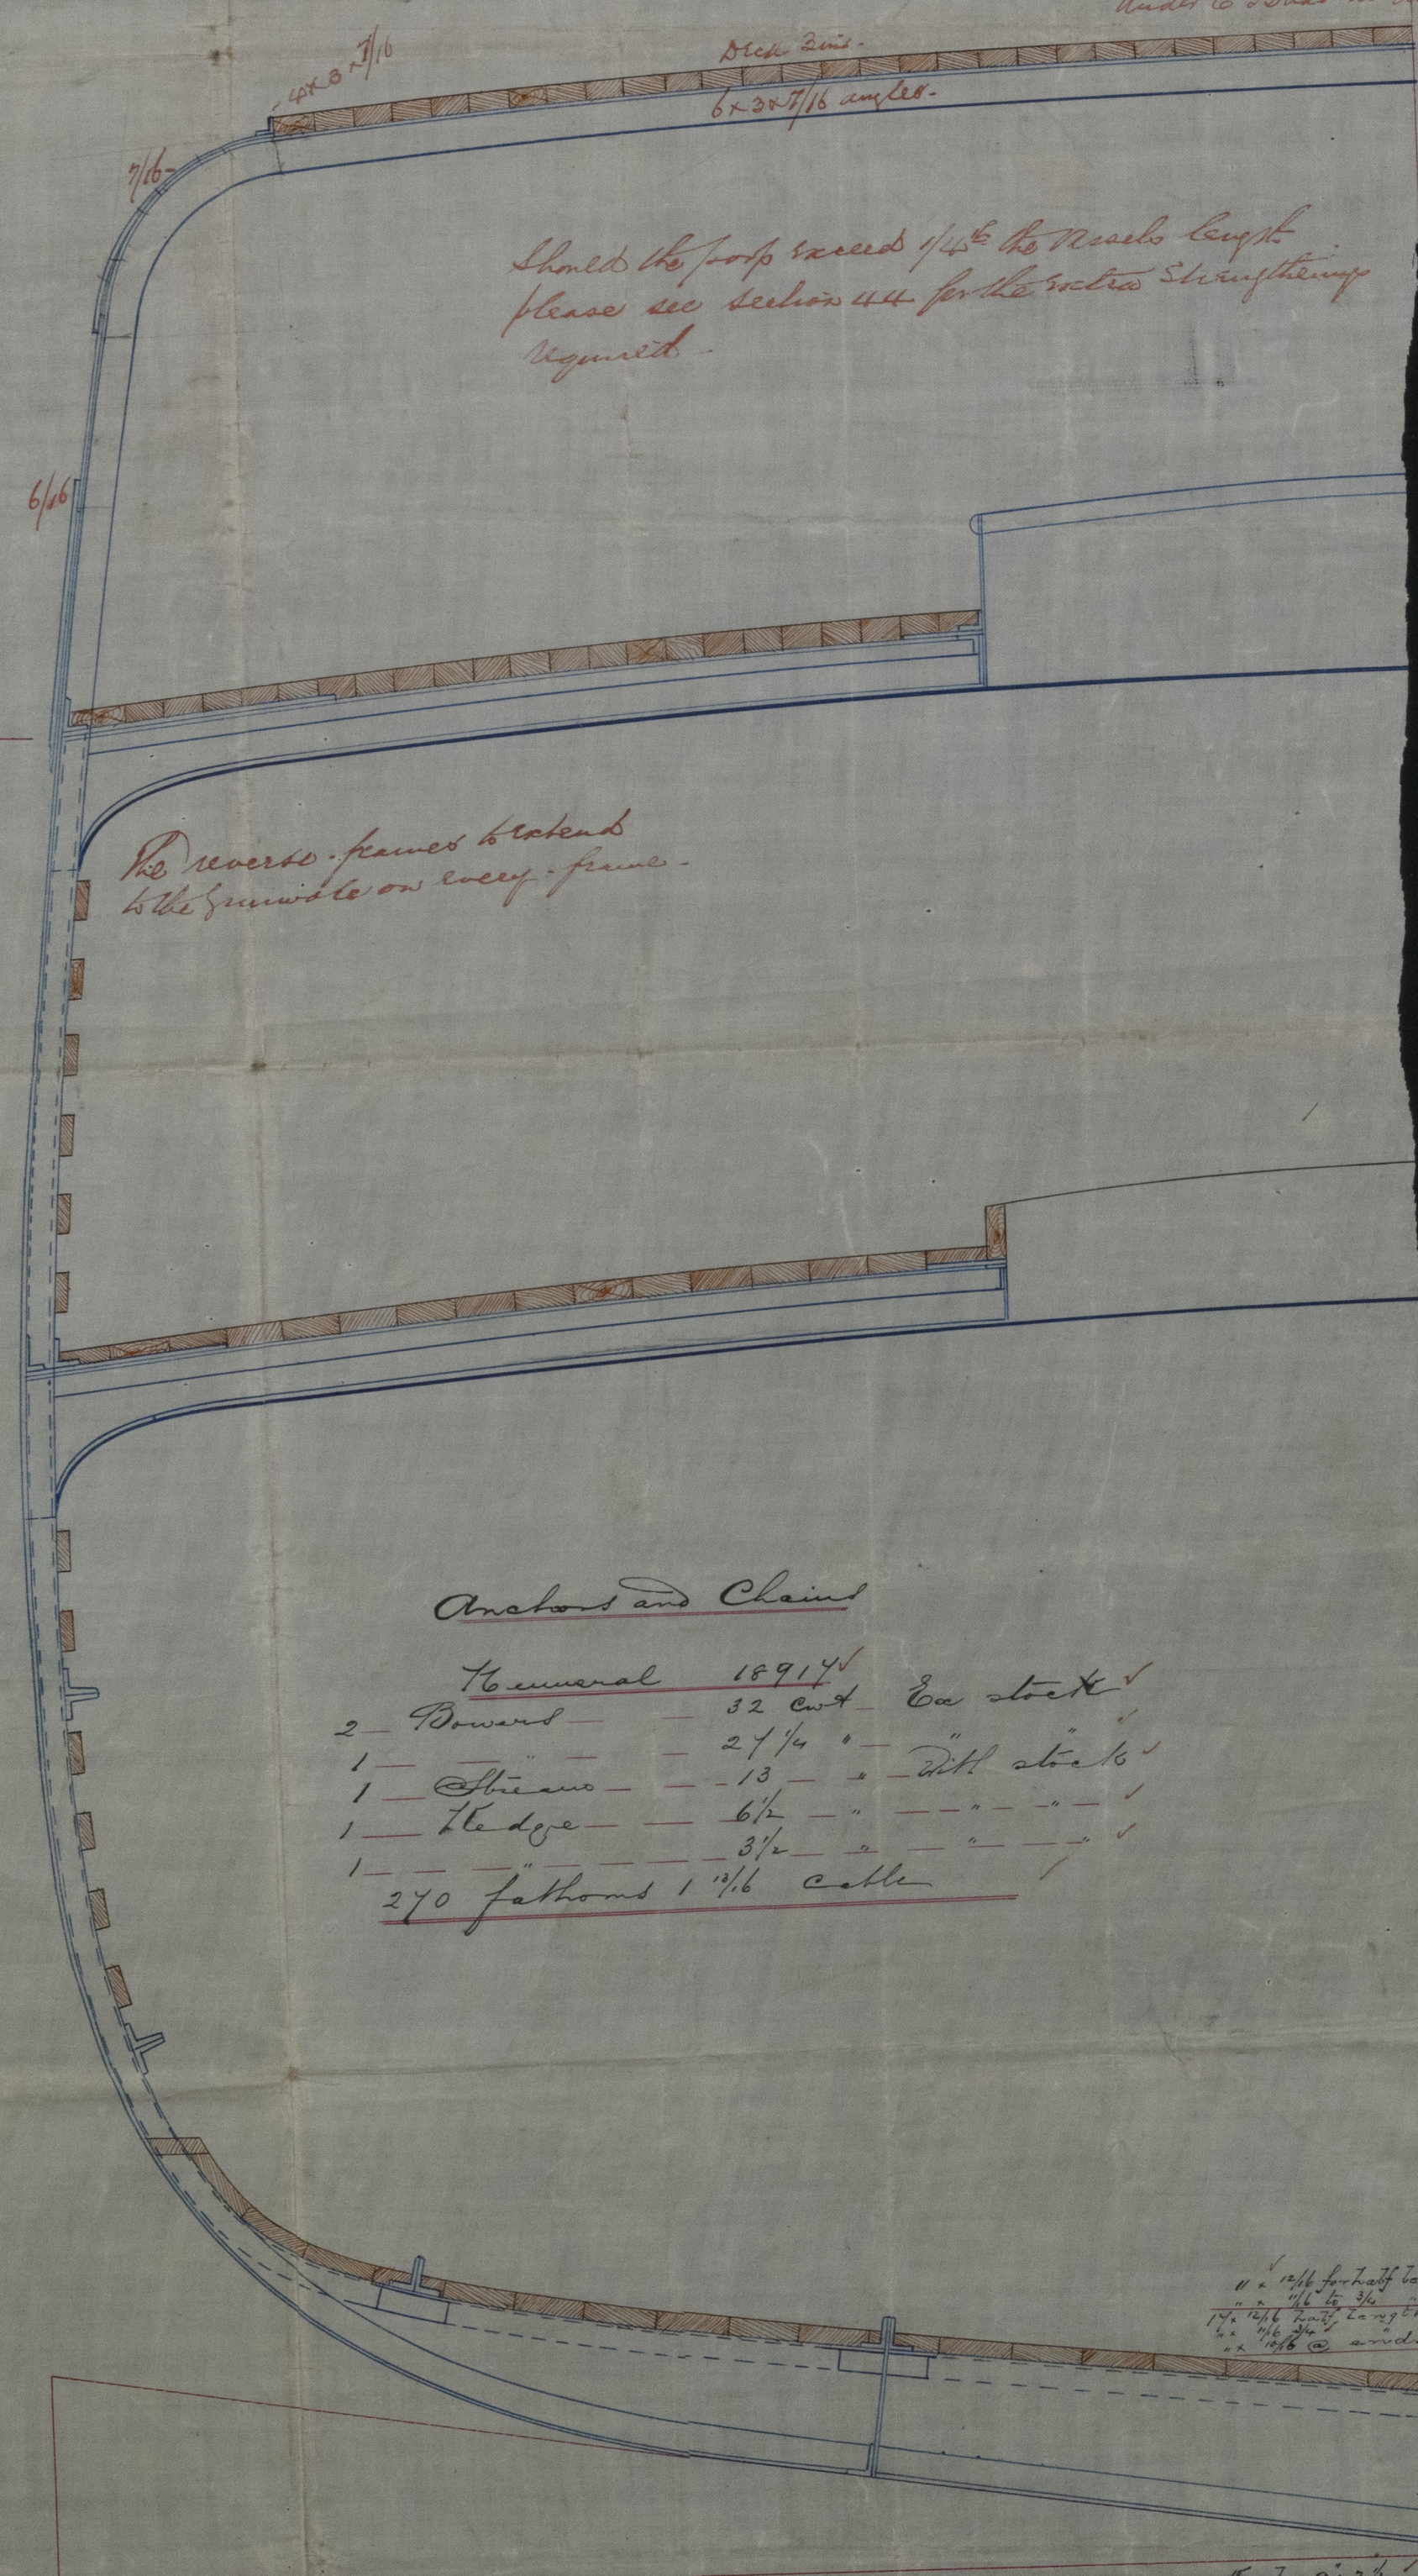

## Anchors and Chains

Humeral	1891 1/4	
2 Forward	52	End stock ✓
1 Aft	27 1/4	✓
1 Stowage	13	✓
1 Bidge	6 1/4	✓
1	3 1/2	✓
270 fathoms	1 1/4	cells

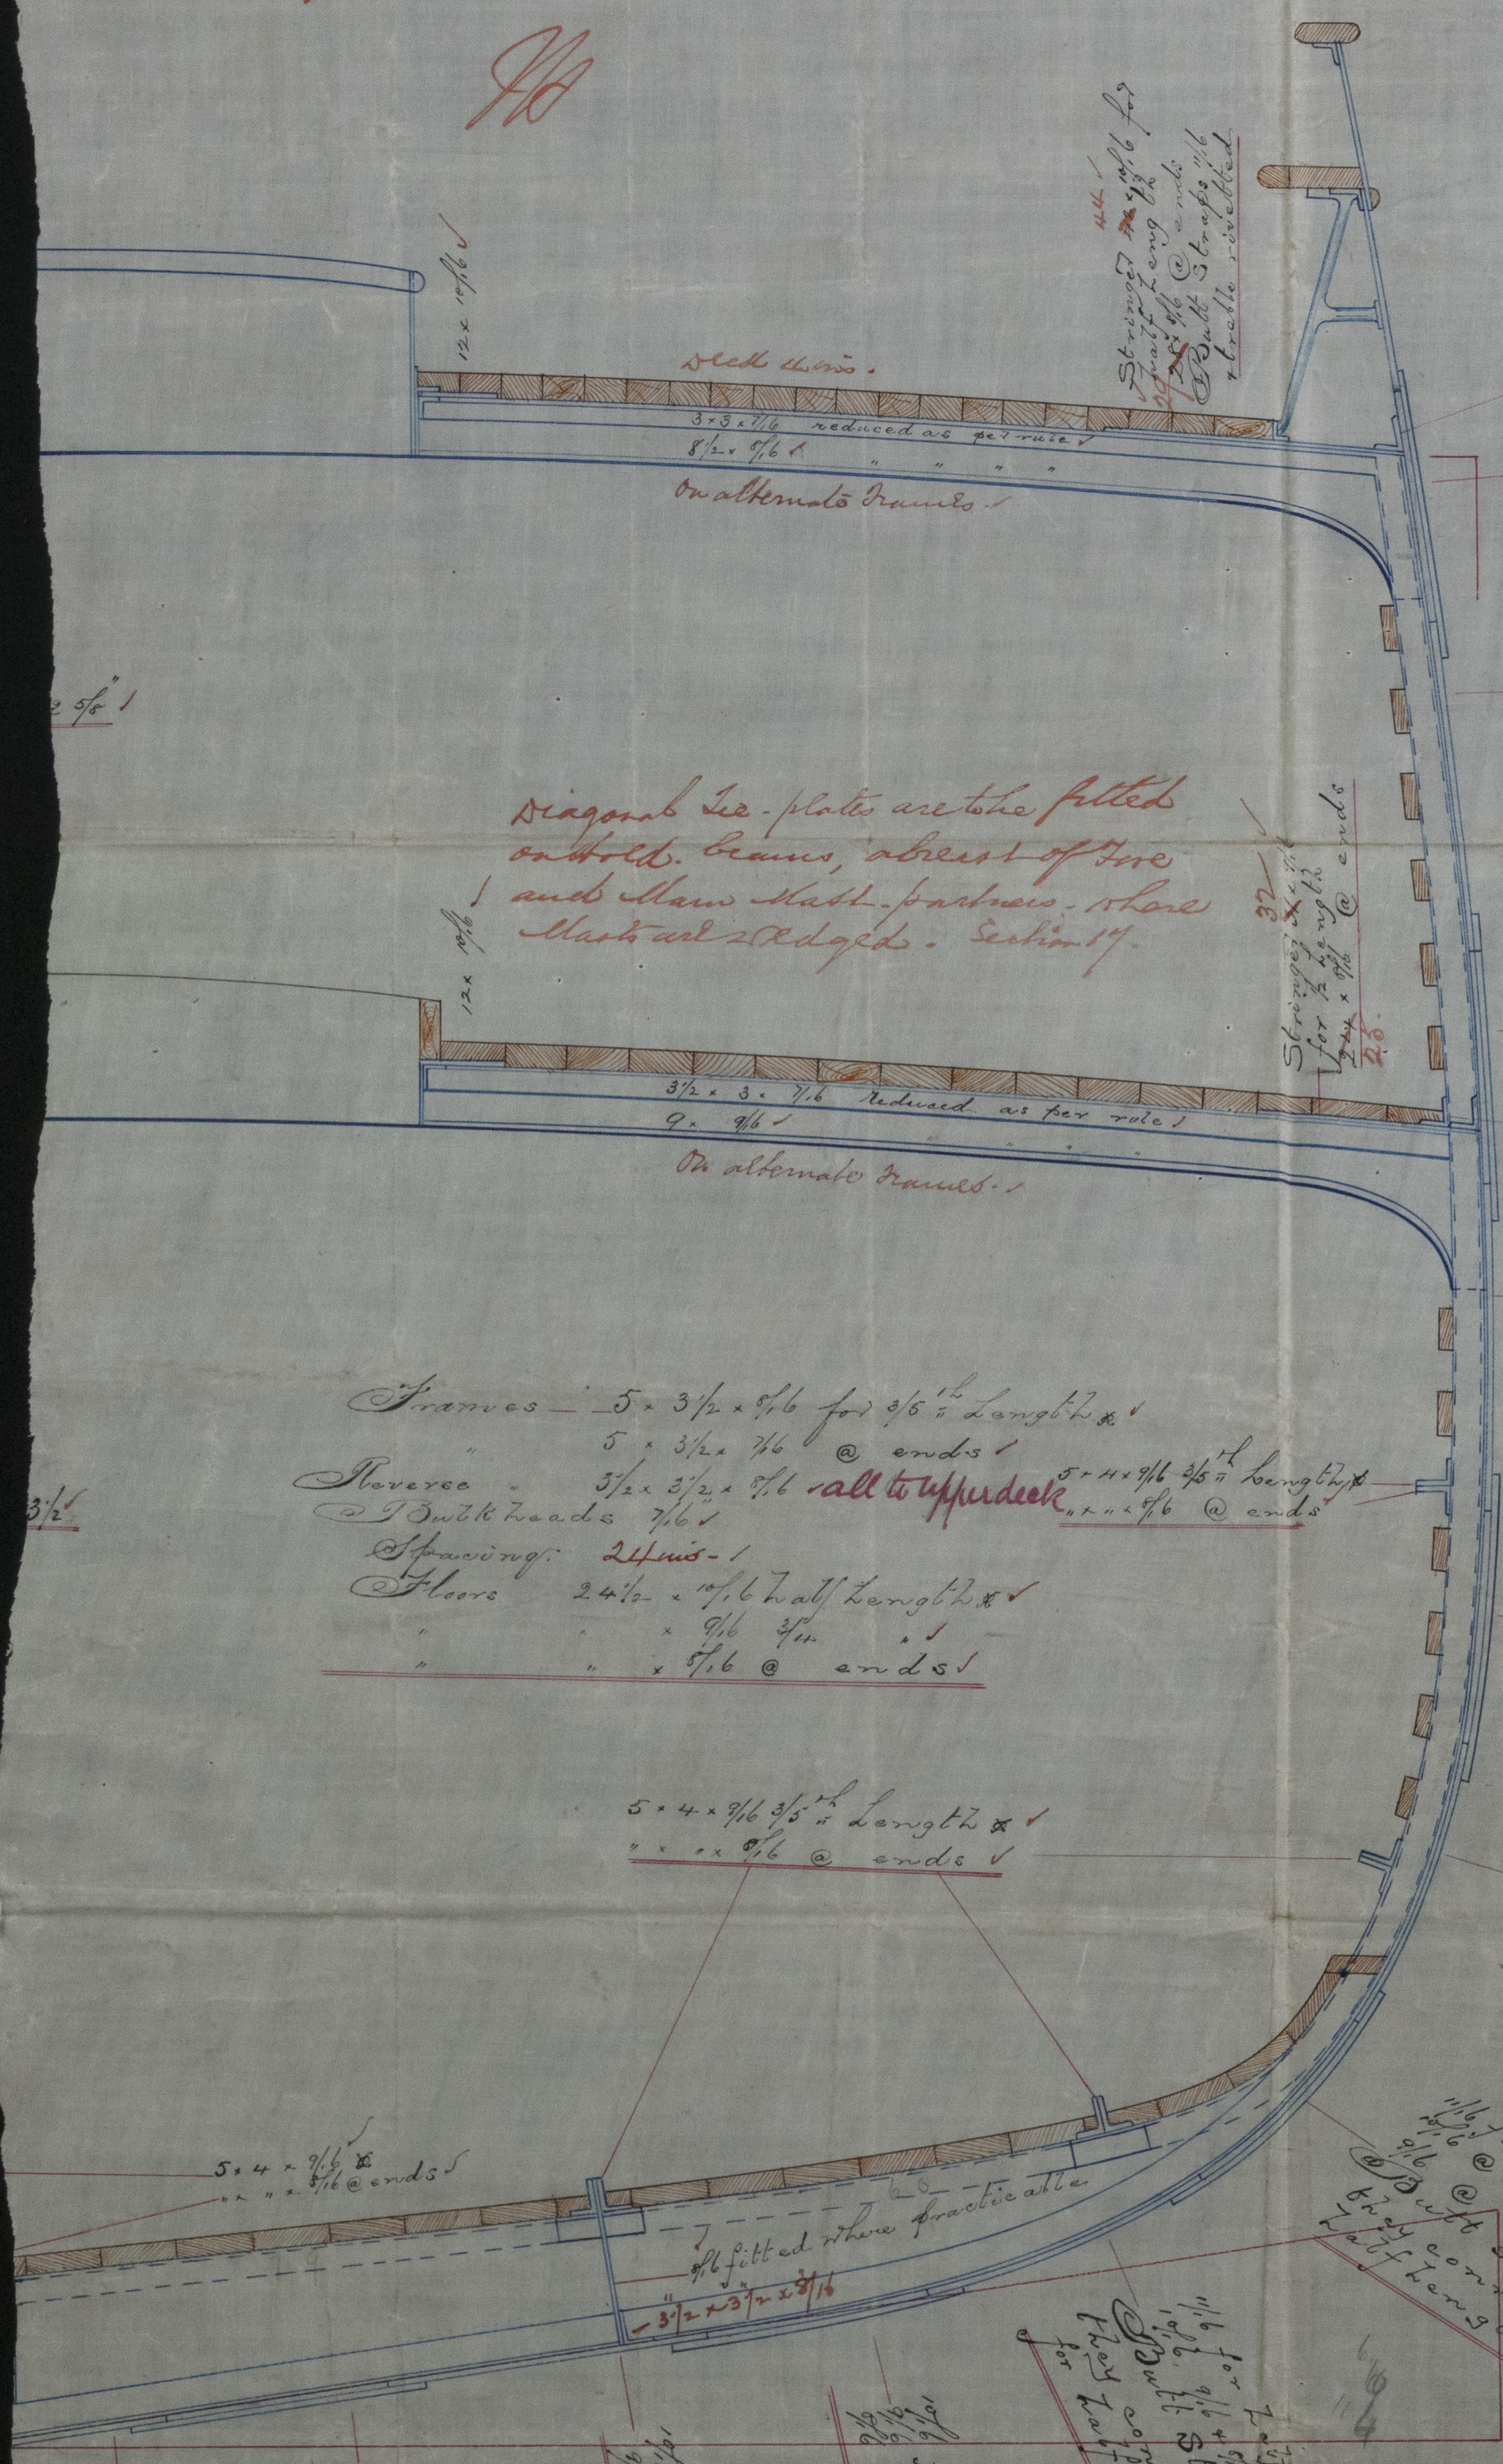

Frames - 5 x 3/4 x 1/4 for 1/2 length & 5 x 3/4 x 1/4 @ ends  
Stowage - 5 x 3/4 x 1/4 all to up deck  
Plating - 2 1/2 x 1/4 for 1/2 length & 2 1/2 x 1/4 @ ends  











15150