


11/9/75

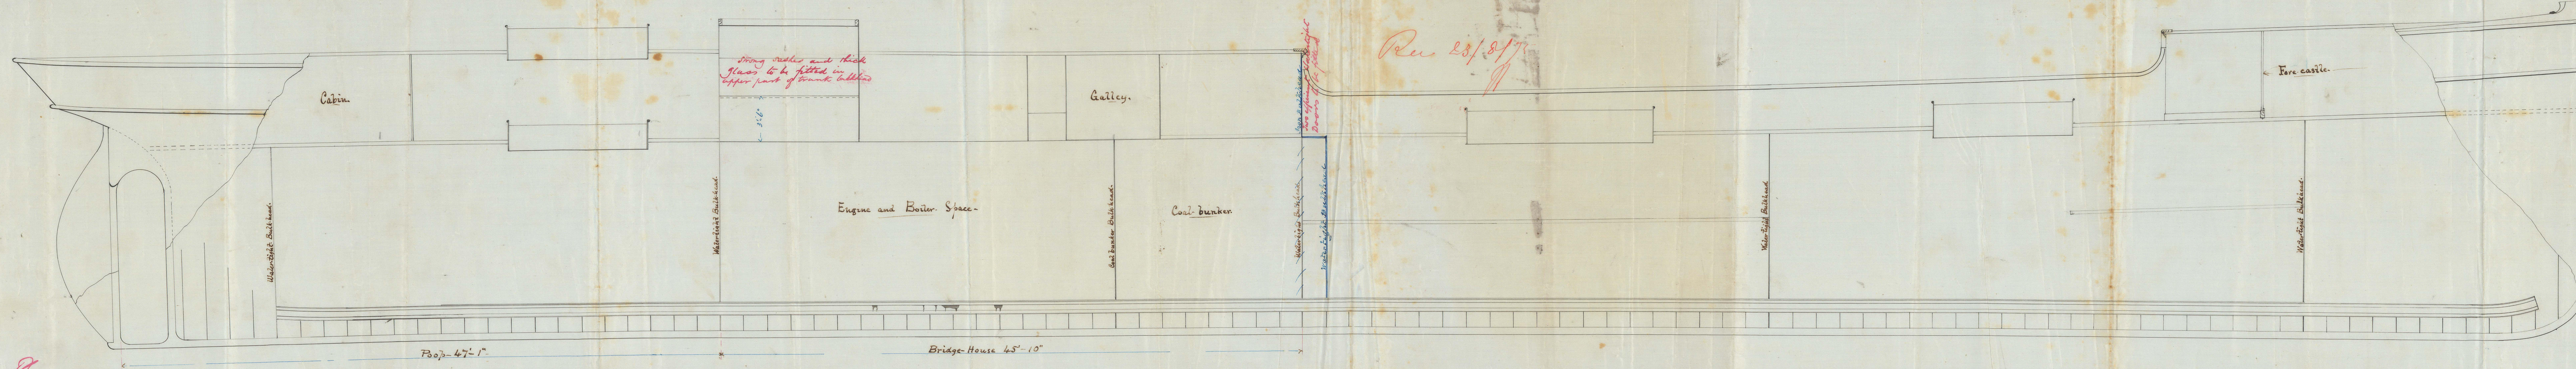

S.S. N° 77.

H. MURRAY & CO.
SHIPBUILDERS
PORT CLASCOW