


11/9/75

Stringer 3'6" x 7' 7" Stringer to be put in thick glass on upper part of tank

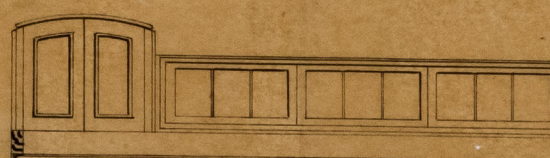

Pop

Stringer 3'6" x 7' 7" Stringer to be put in thick glass on upper part of tank

Engine Enclosure

Casing extending from Main to Bridge Deck

Boiler Casing

Stores

Galley

2 Waterways down the side of the ship

Plan 28/1/75


Engine and Boiler Space

N.T. Bulkhead

N.T. Bulkhead

S.S. No 77
Scale 1/2" = 1 Foot

2 Transverse Section through Engine Enclosure

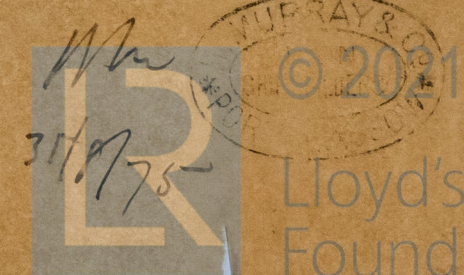

Lloyd's Register Foundation

100513-0021