


Proposed Lower Deck Beams

Dec 15/7/75 S. S. N^o 199

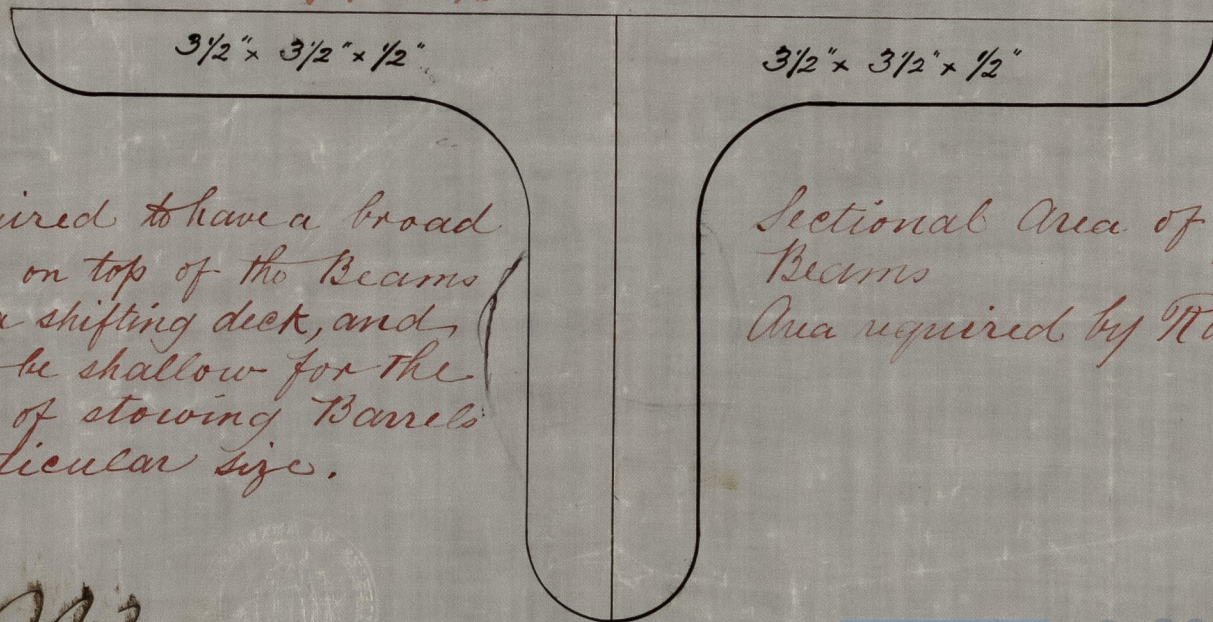

It is required to have a broad surface on top of the Beams to carry a shifting deck, and Beams to be shallow for the purpose of stowing Barrels of a particular size.

Sectional Area of proposed Beams 112
Area required by Rule 92

N. W.

15/7/75 → 16/7/75