



Cargo Ports. S, S, No 199. _____

Rev 7/8/78
RD

— Scale $\frac{1}{4}$ inch to one foot —

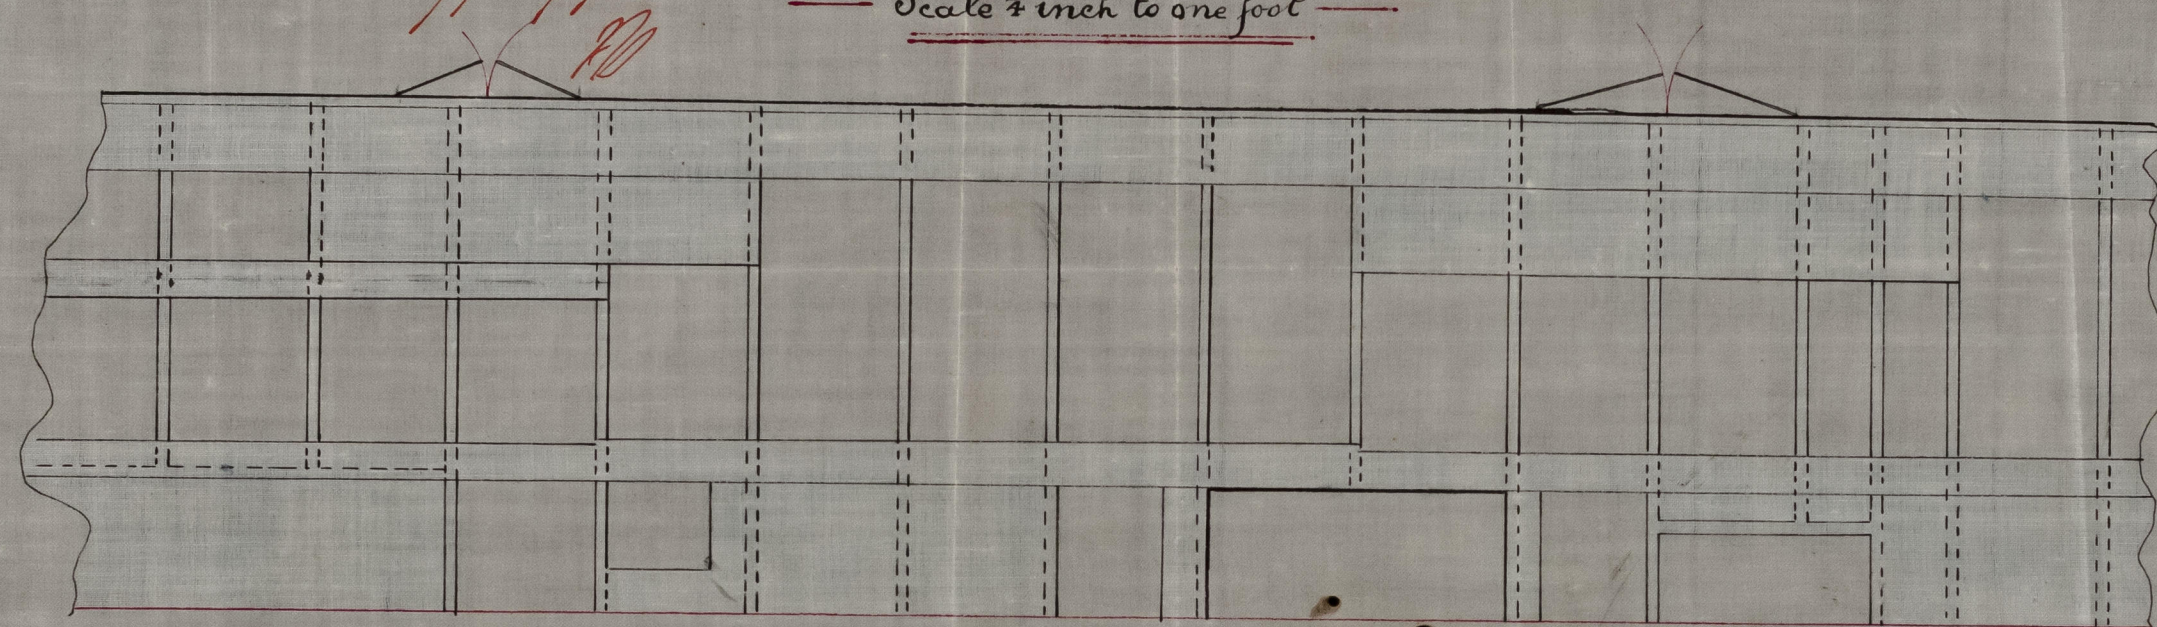

— PLAN *No 7* —

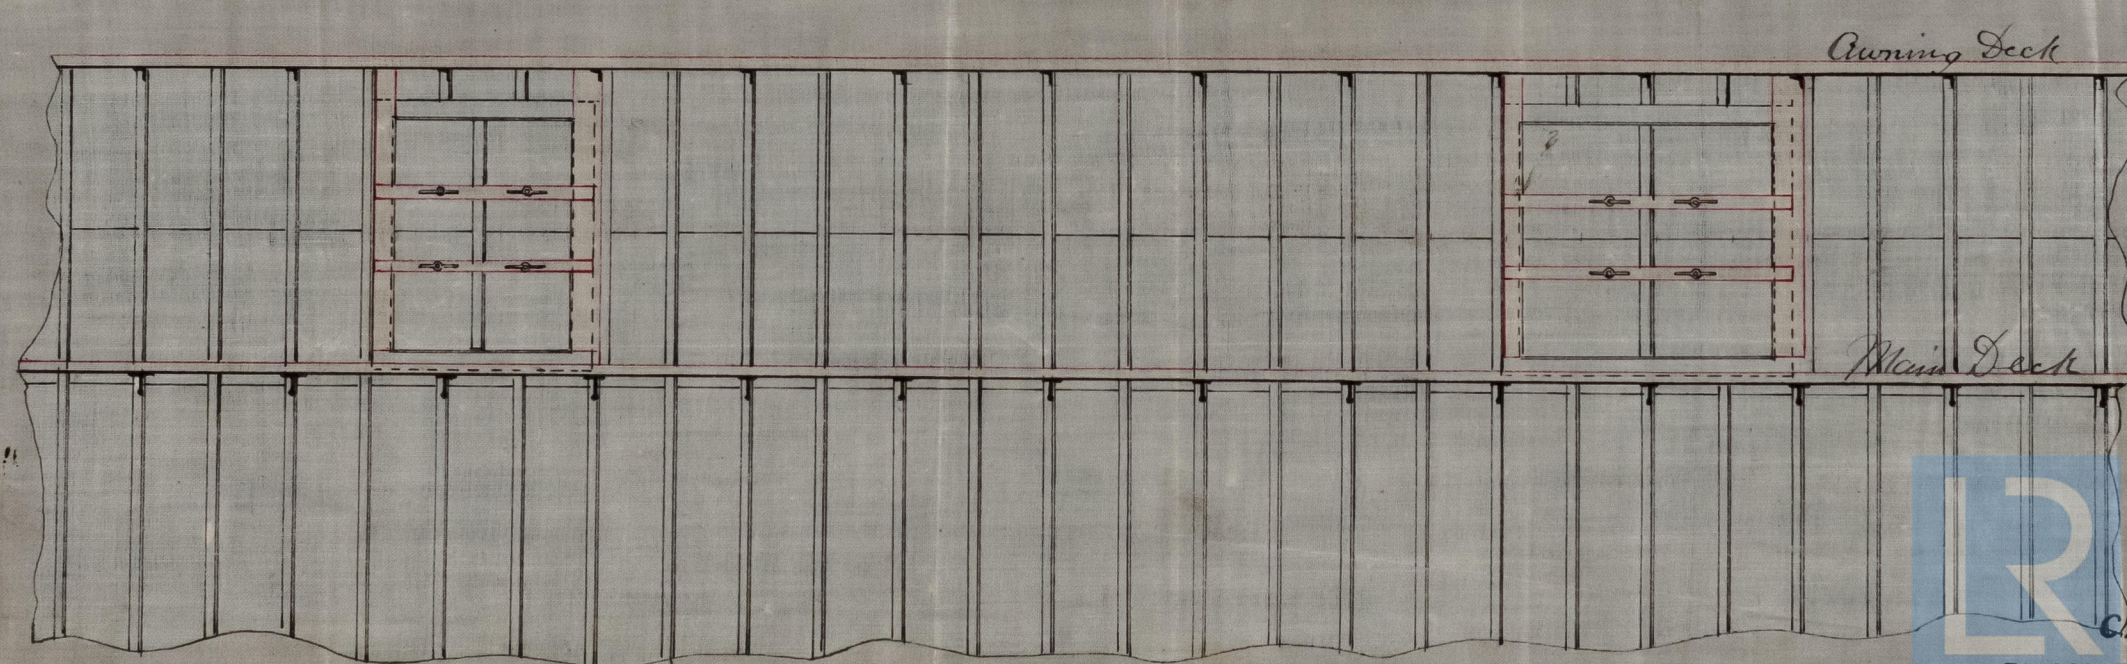

— ELEVATION —



© 2021 *Wm*
178125
Lloyd's Register
CHAIRD & CO
ENGINEERS & IRON SHIPBUILDERS
GREENOCK

1R0513-0048