


13/5/75

Awning Decked Iron Screw Steamer No 199
Sheer Plan Scale $\frac{1}{4}$ " = 1 ft. Rev 7/8/75

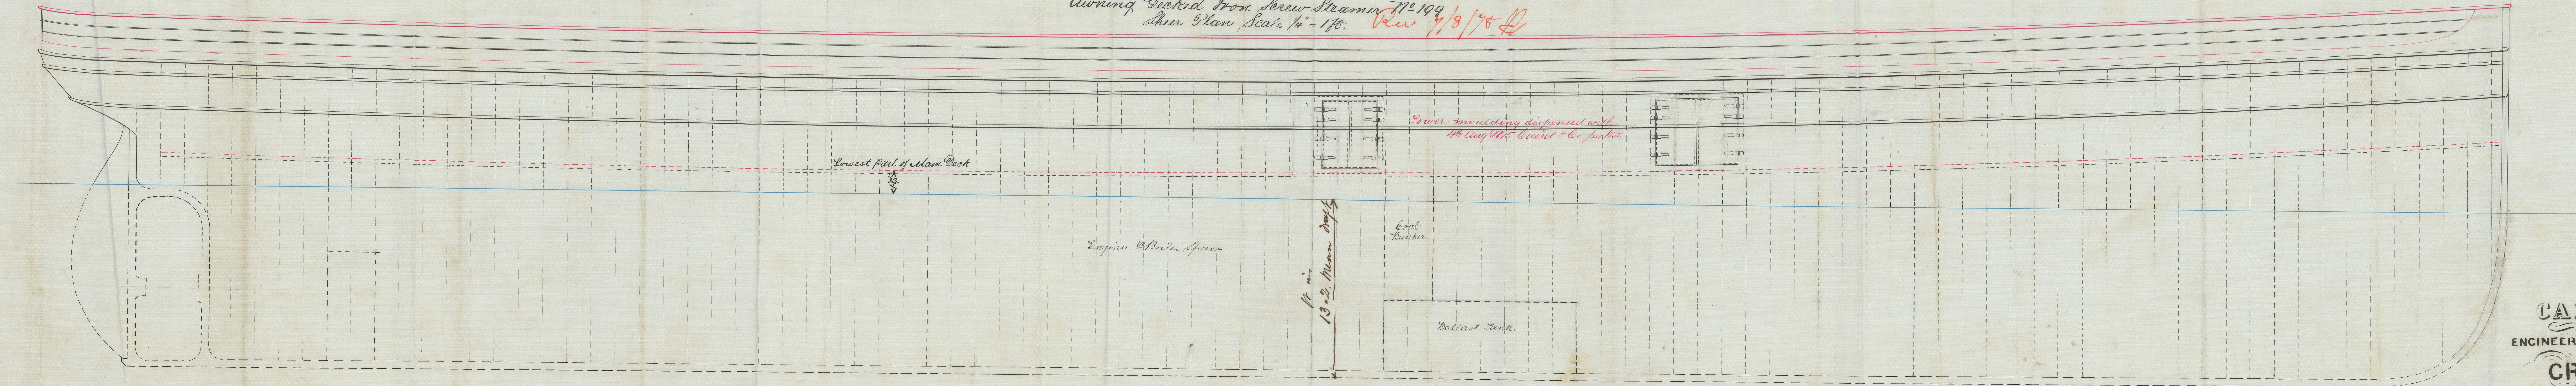

CAIRD & CO.
ENGINEERS & IRON SHIP BUILDERS.

GREENOCK.

D. W. 6th May 1875
W. H. Kelso

© 2021

Lloyd's Register
Foundation