

"TAIAROA"

Glasgow Report No 4102

— Elevation of No 123 S.S. —

— Scale $\frac{1}{8}$ = one foot. —

Length 183 x 23 x 13.66

Numerals $\frac{47}{8692}$


A & J. Inglis.

ENGINEERS & SHIPBUILDERS

GLASGOW.

25th February 1875.

Rev 26/2/75
H

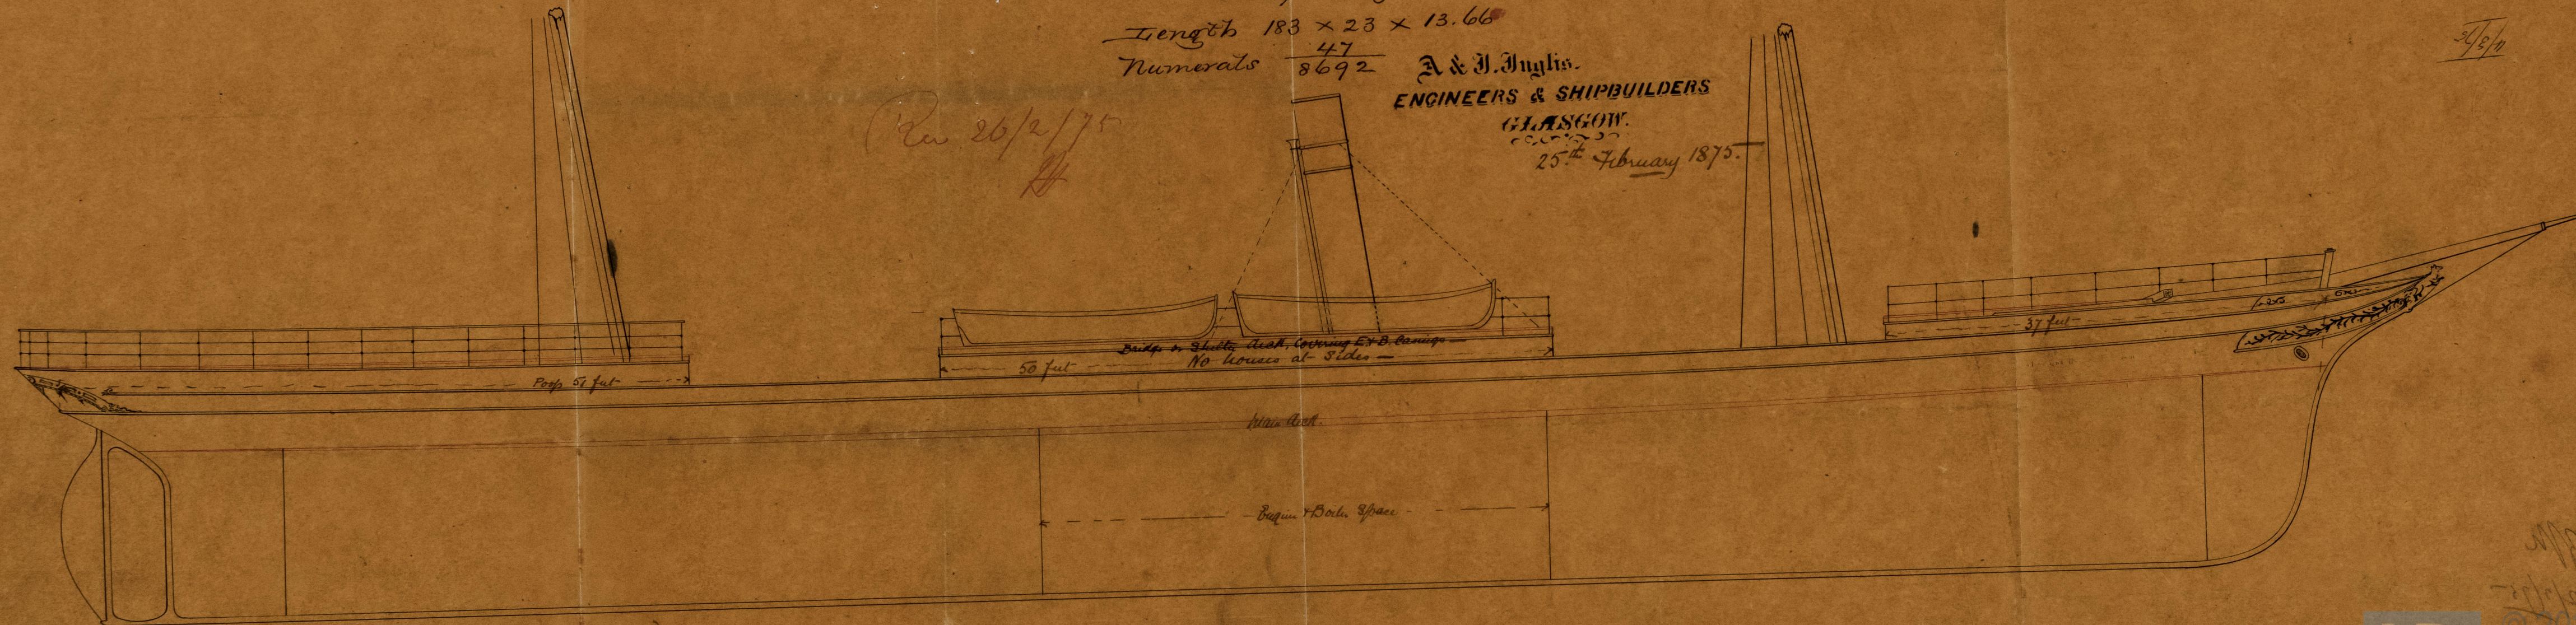

© 2021

Lloyd's Register
Foundation

186N513-0089
















© 2021
Lloyd's Register
Foundation