

St. Scotia (now Finiskire)

Iron Report No 15459

built Dundee 1875

# MID SECTION

S.S. No 7 Scale 1/2 inch = 1 foot


Dimensions  
Length of keel & fore rake 180 feet 0 inches  
Breadth moulded 24 0  
Depth on hold to floors 11 2 1/2  
Frames spaced 22 inches apart C to C

Rev 4/9/74 & 9/14/74 & 11/1/75  
Again 12/2/75

Section in way of Prop  
4 1/2 ft

Comp of bulk from  
ap side of after part  
is 16 feet 0 inches

Compensation Stinger in Main Hold  
Hold

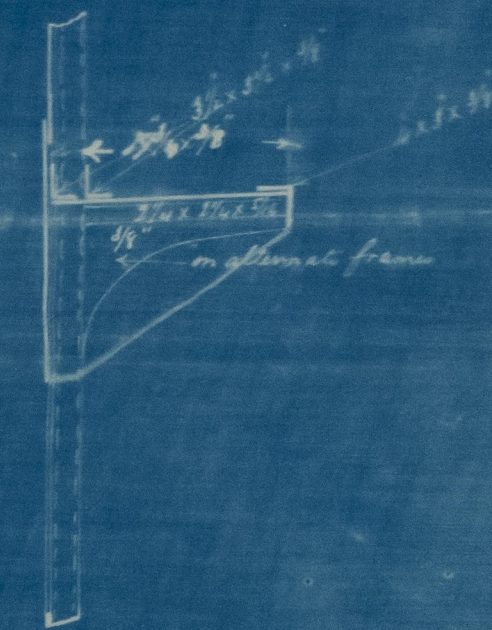

Please see the  
in way of engine space

4/9/74  
30/4/75

IRON 513-0116



Keel Cast 24 1/2  
Beam 12 0  
Mould depth 15 4 1/2  
5 1/2 x 1/2 1st number  
14 1/2  
13 1/2  
4 1/2  
4 1/2  
3 1/2  
5 1/2  
4 1/2  
10 1/2  
7 1/2  
11 6  
Class 100 A

Butt strap double  
Sewed throughout

Double riveted 1/2 inch landing

30 x 1/2  
for 1/2 length

Keel 7 x 2 1/2