


Rec^d & Amended
2/9/74

Midship Section shewing Plan
of Sheer Strake as approved - of A.C. W. & J.
Scale $\frac{3}{4}$ inch = 1 foot

Rec 19/1/75
RJ

8 January 1875
Galedon Ship Yard
Dundee

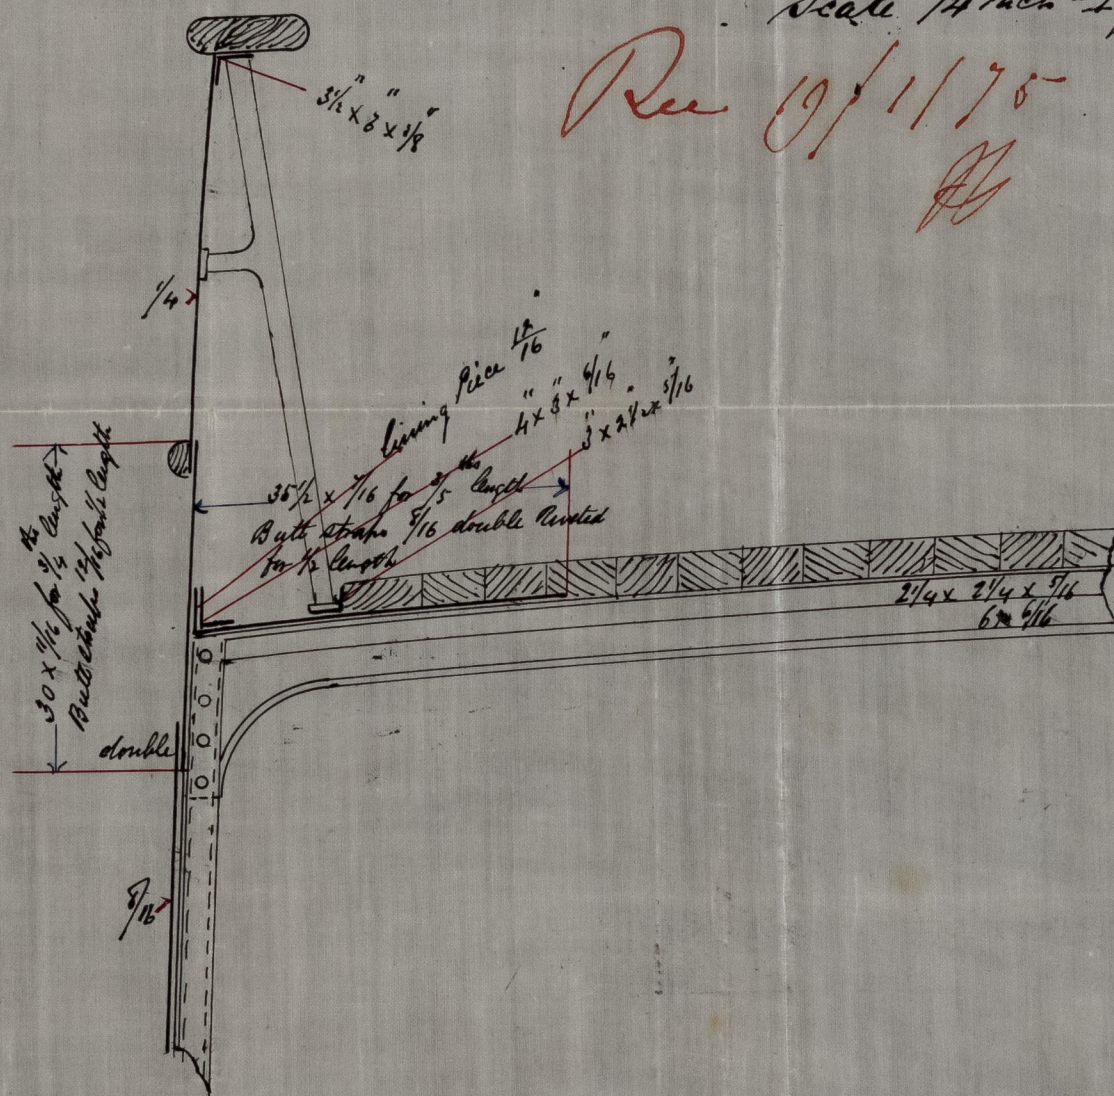

N.D.
19/1/75



© 2021

Lloyd's Register
Foundation

180513-0119