


Section in way of Proposed Bridge Deck

S.S. No. 4 Scale $\frac{3}{4}$ Inch = 7 foot

Rec 9/11/74

Length of Deck 35 feet

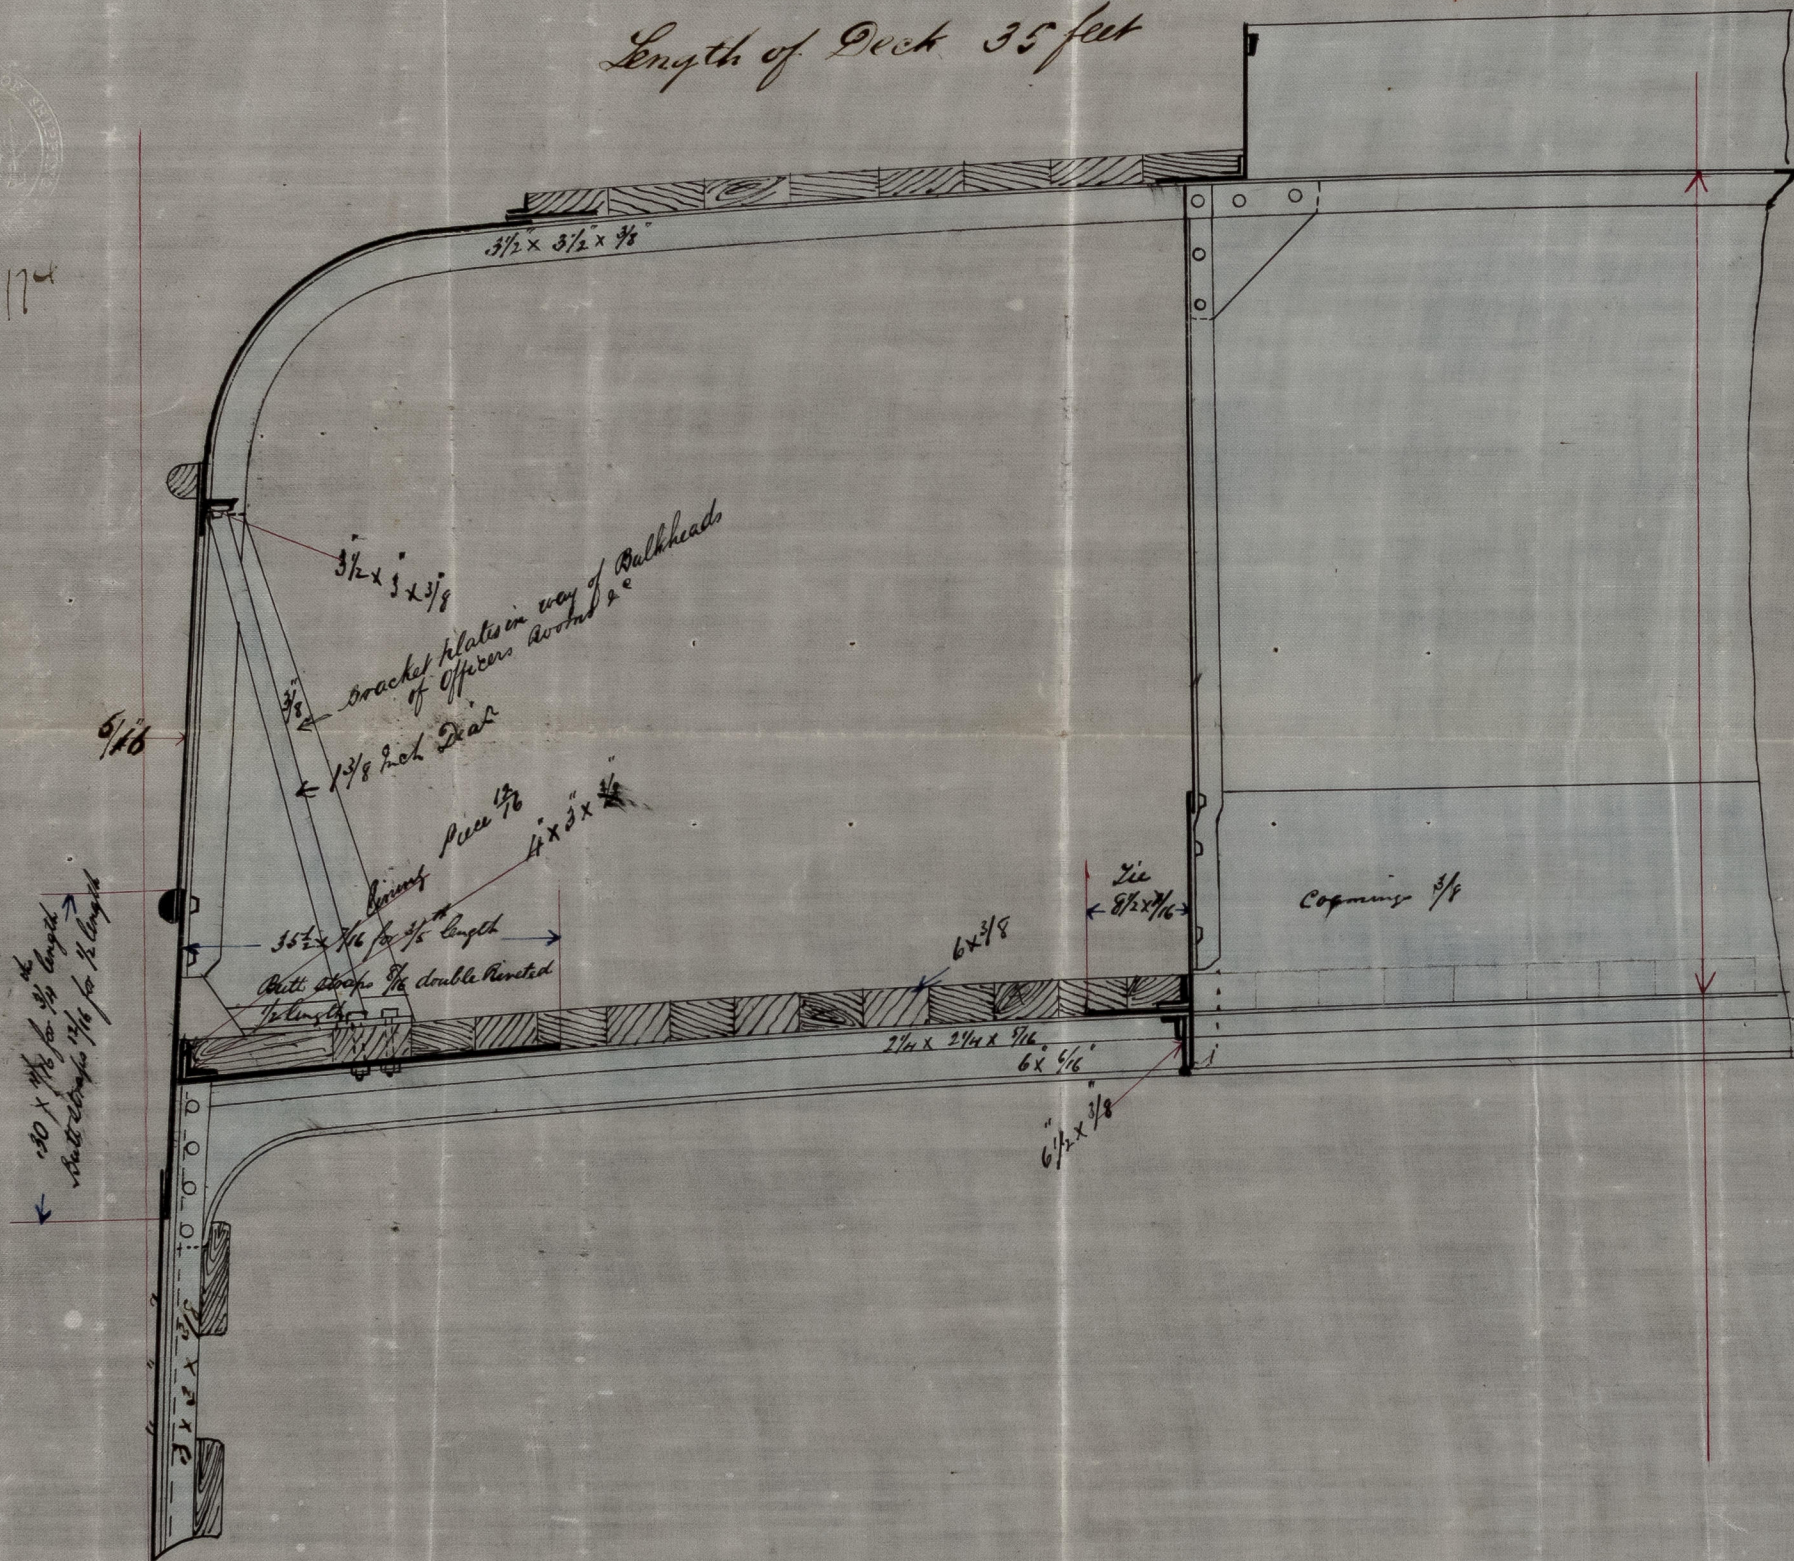

© 2021
H.C. Lloyd's Register
Foundation
9/11/74

IRON 513-012