
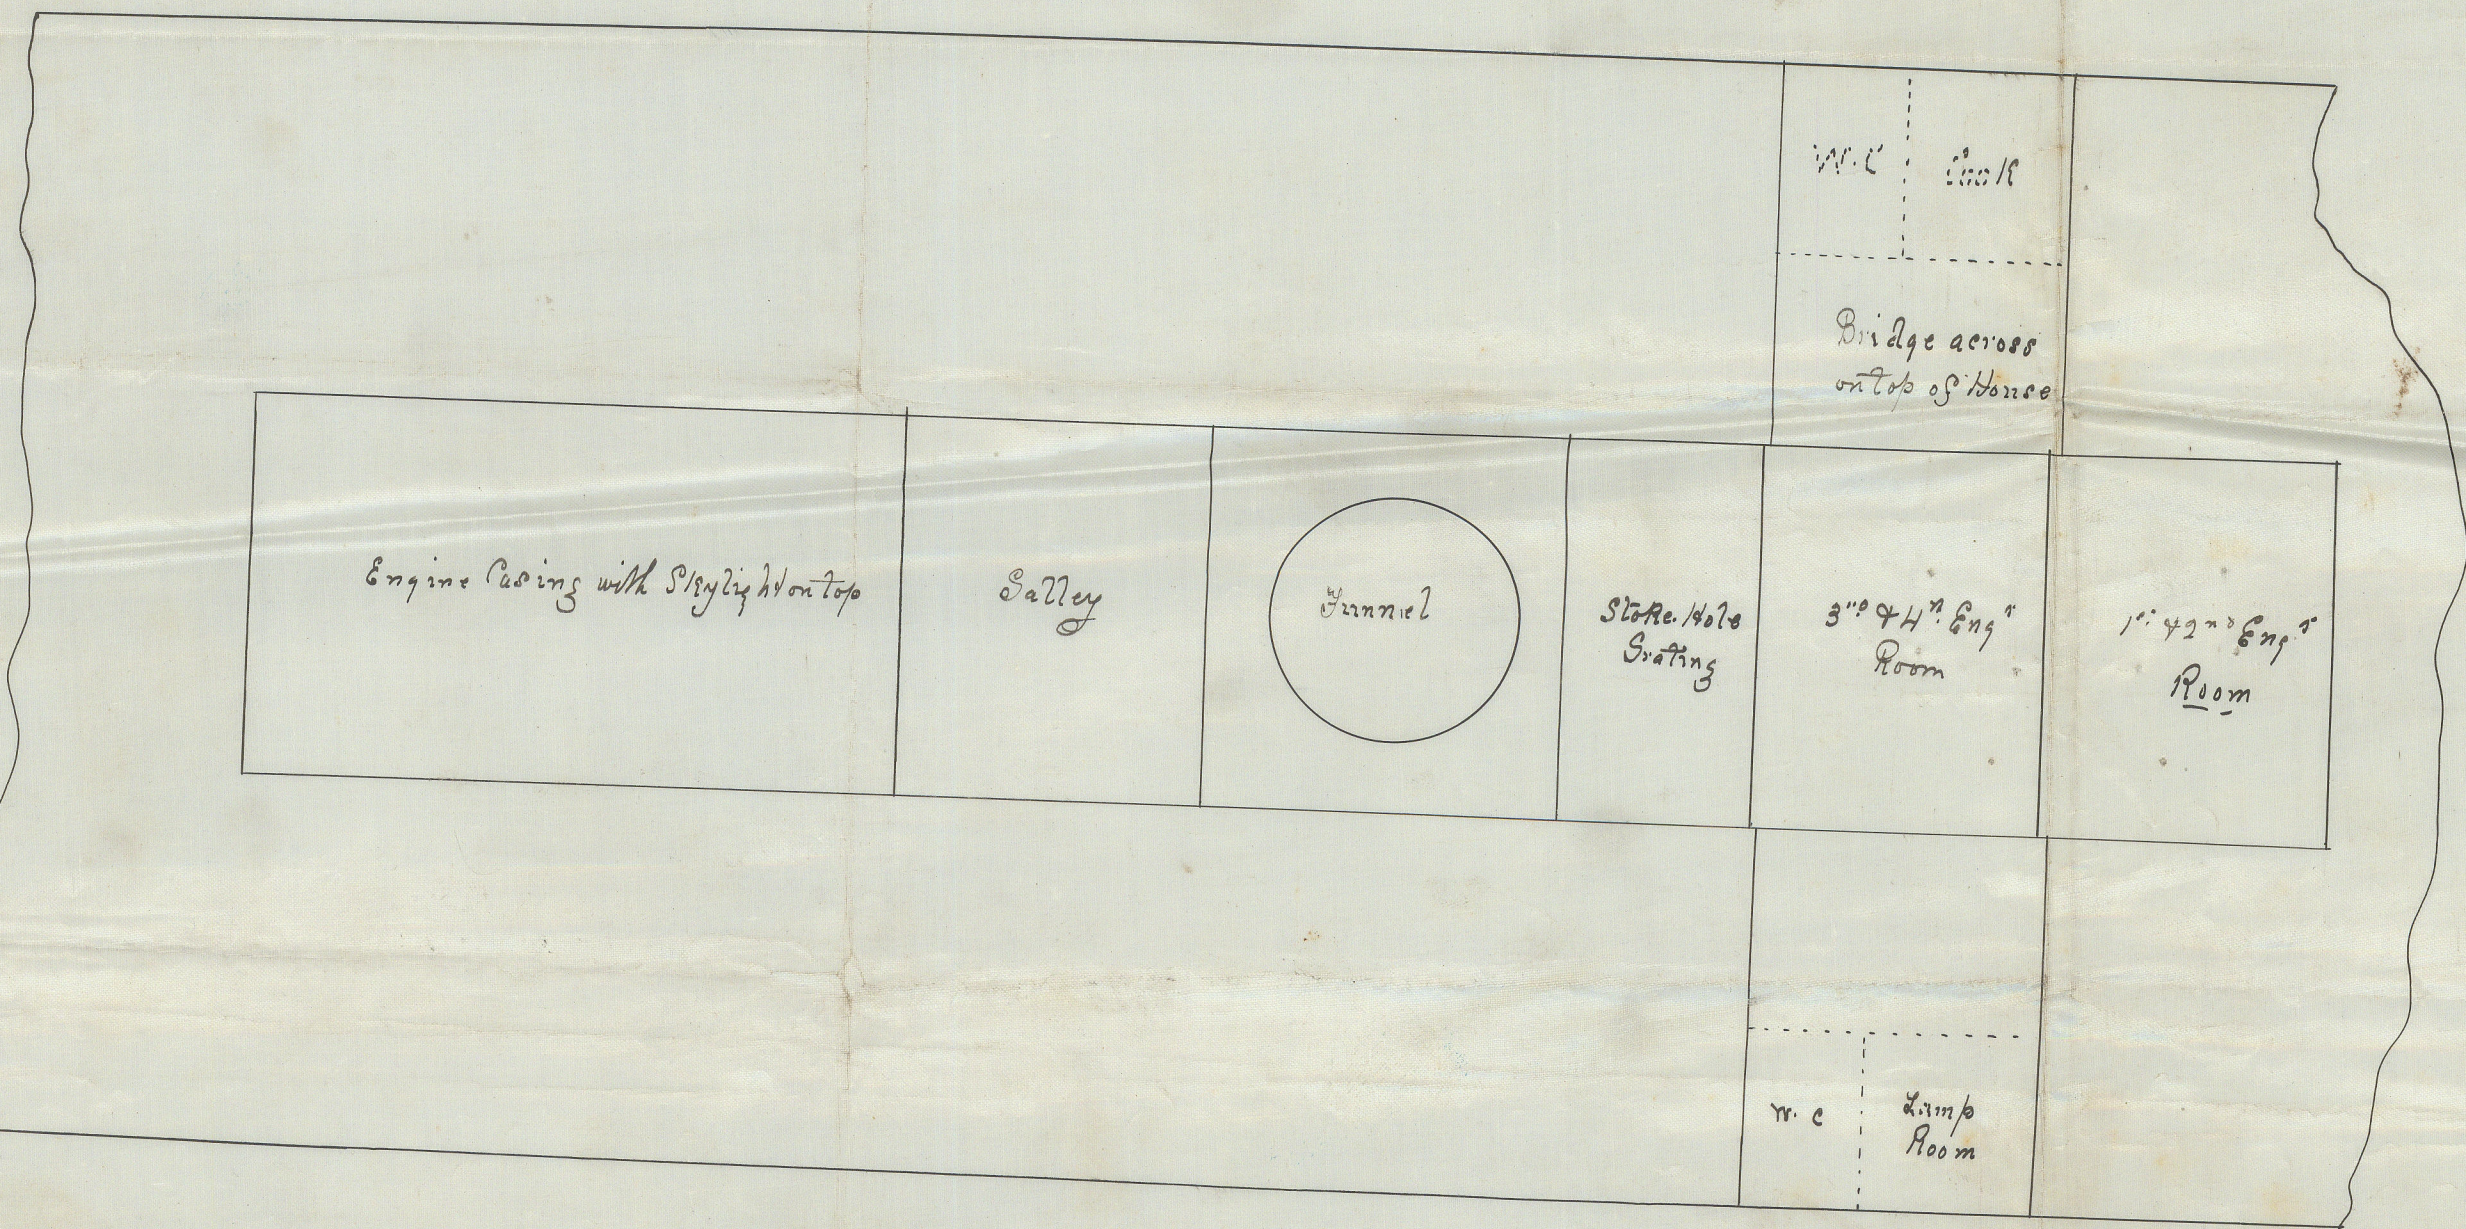
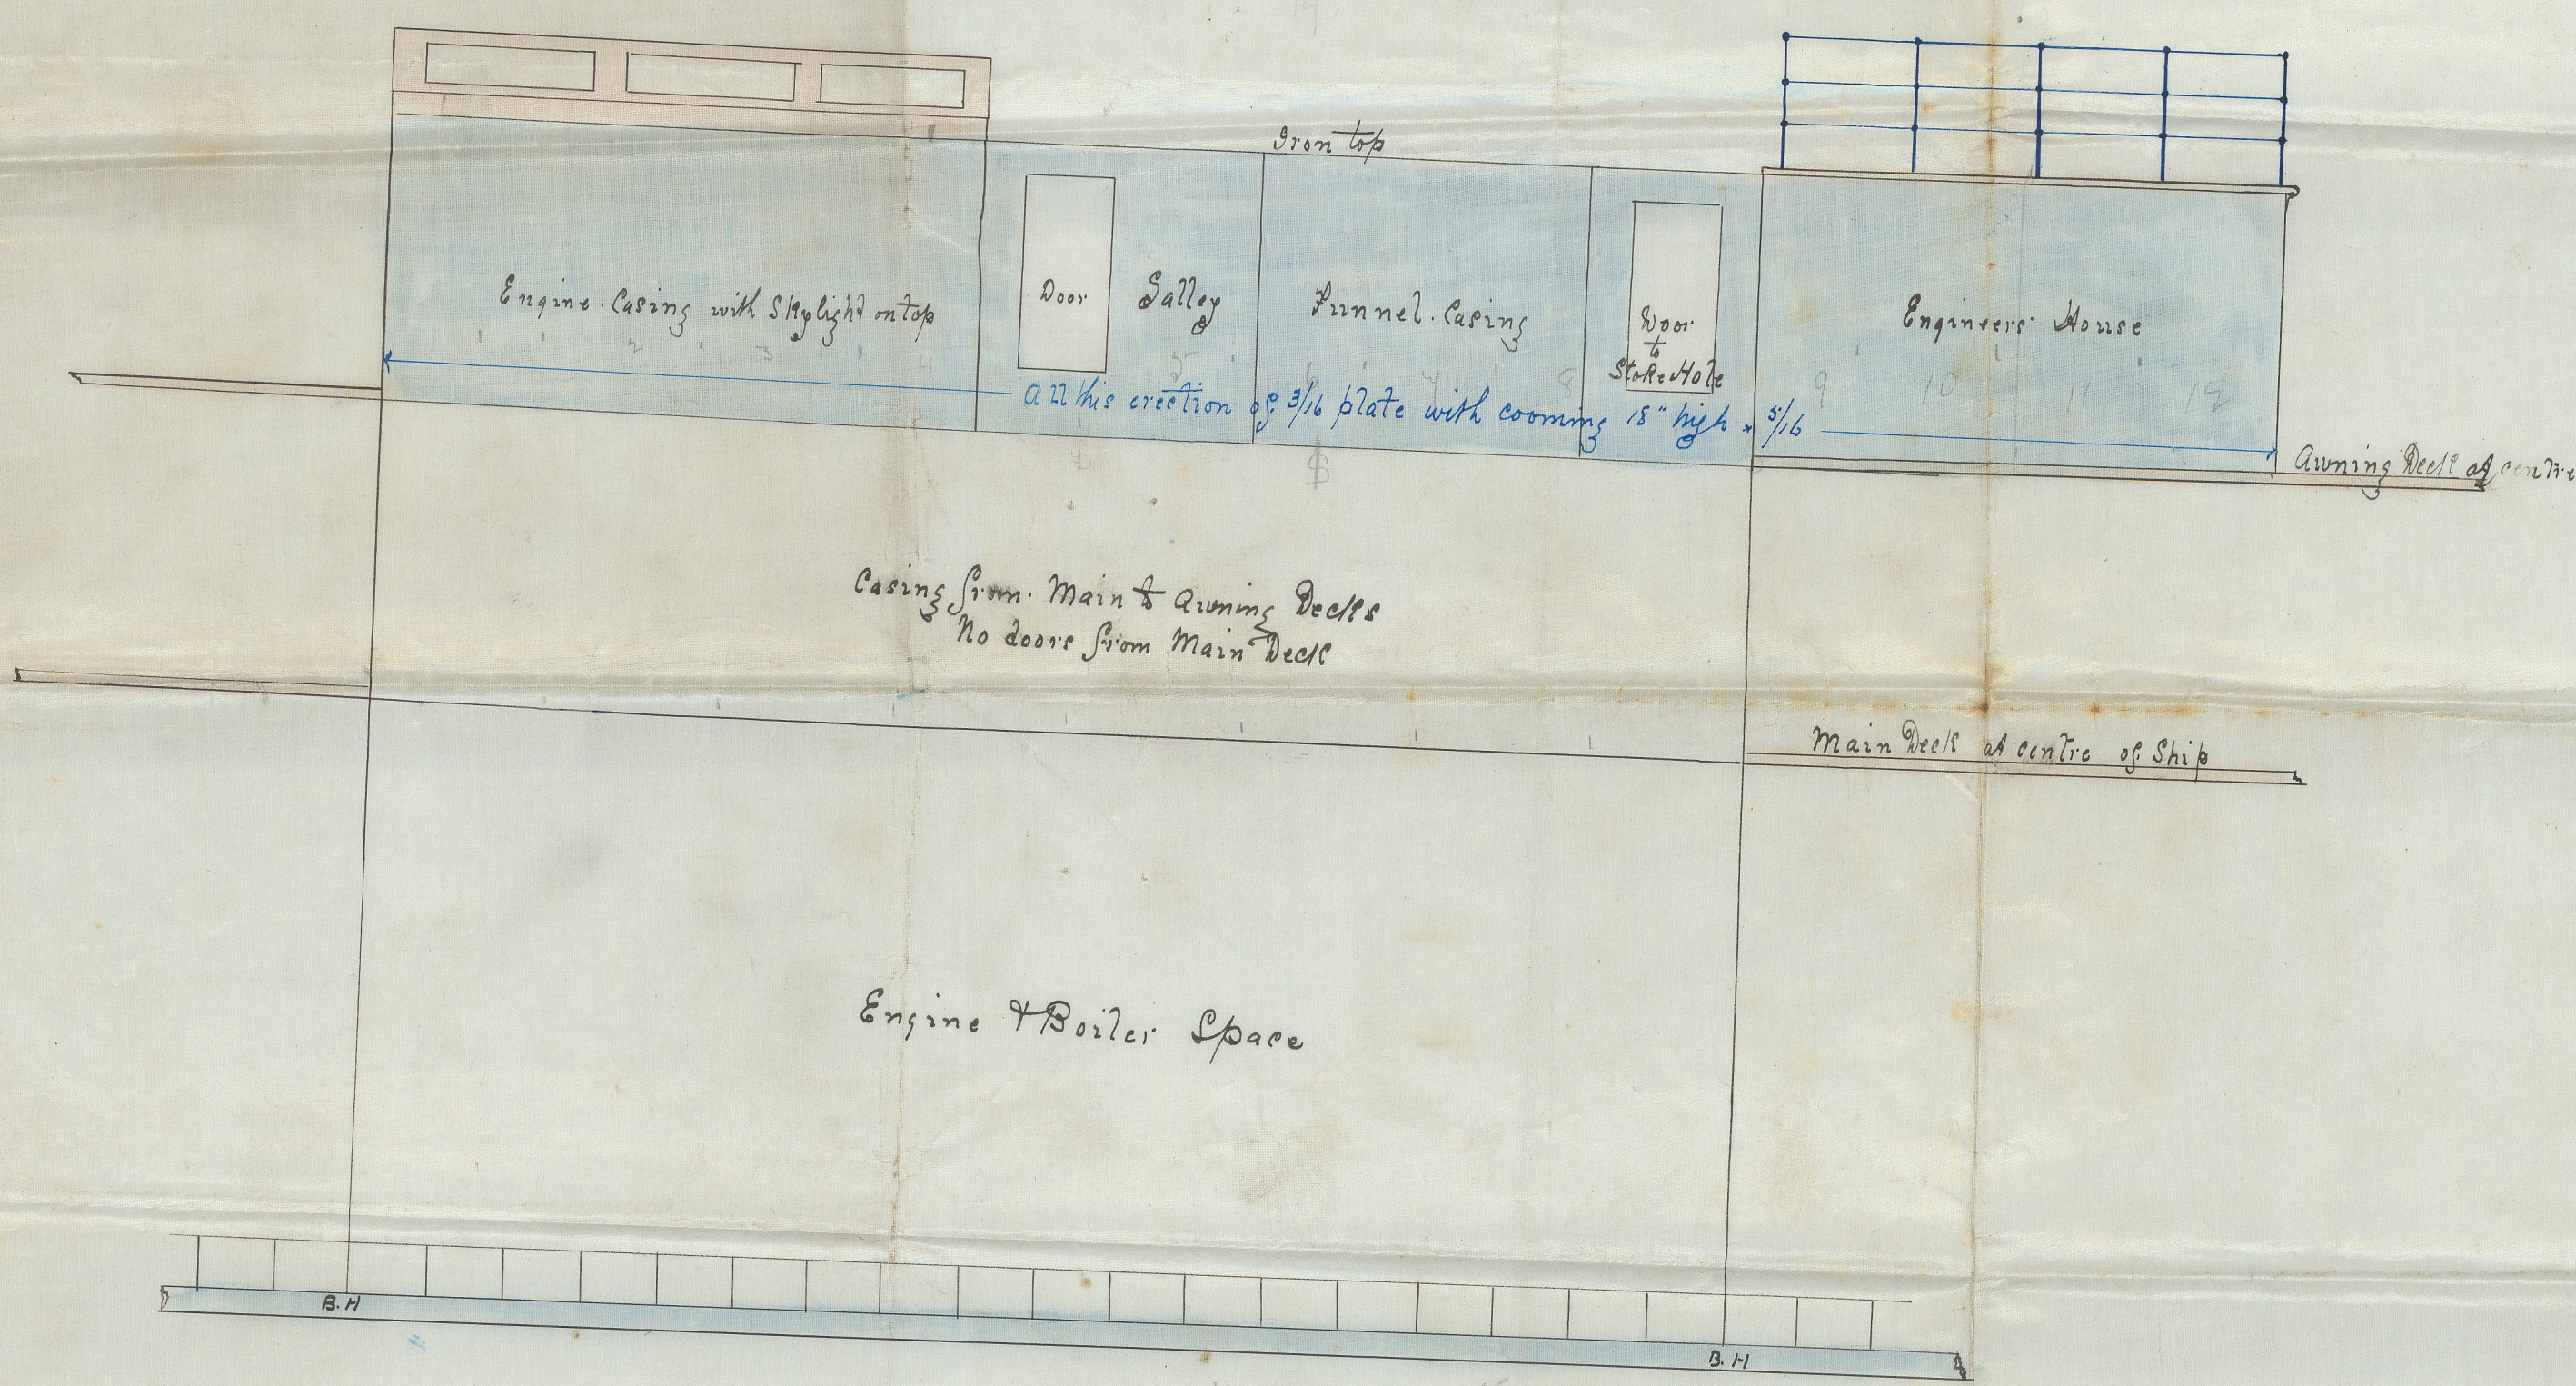


22/4/75

No 2

S.S. Corea
from 15356.

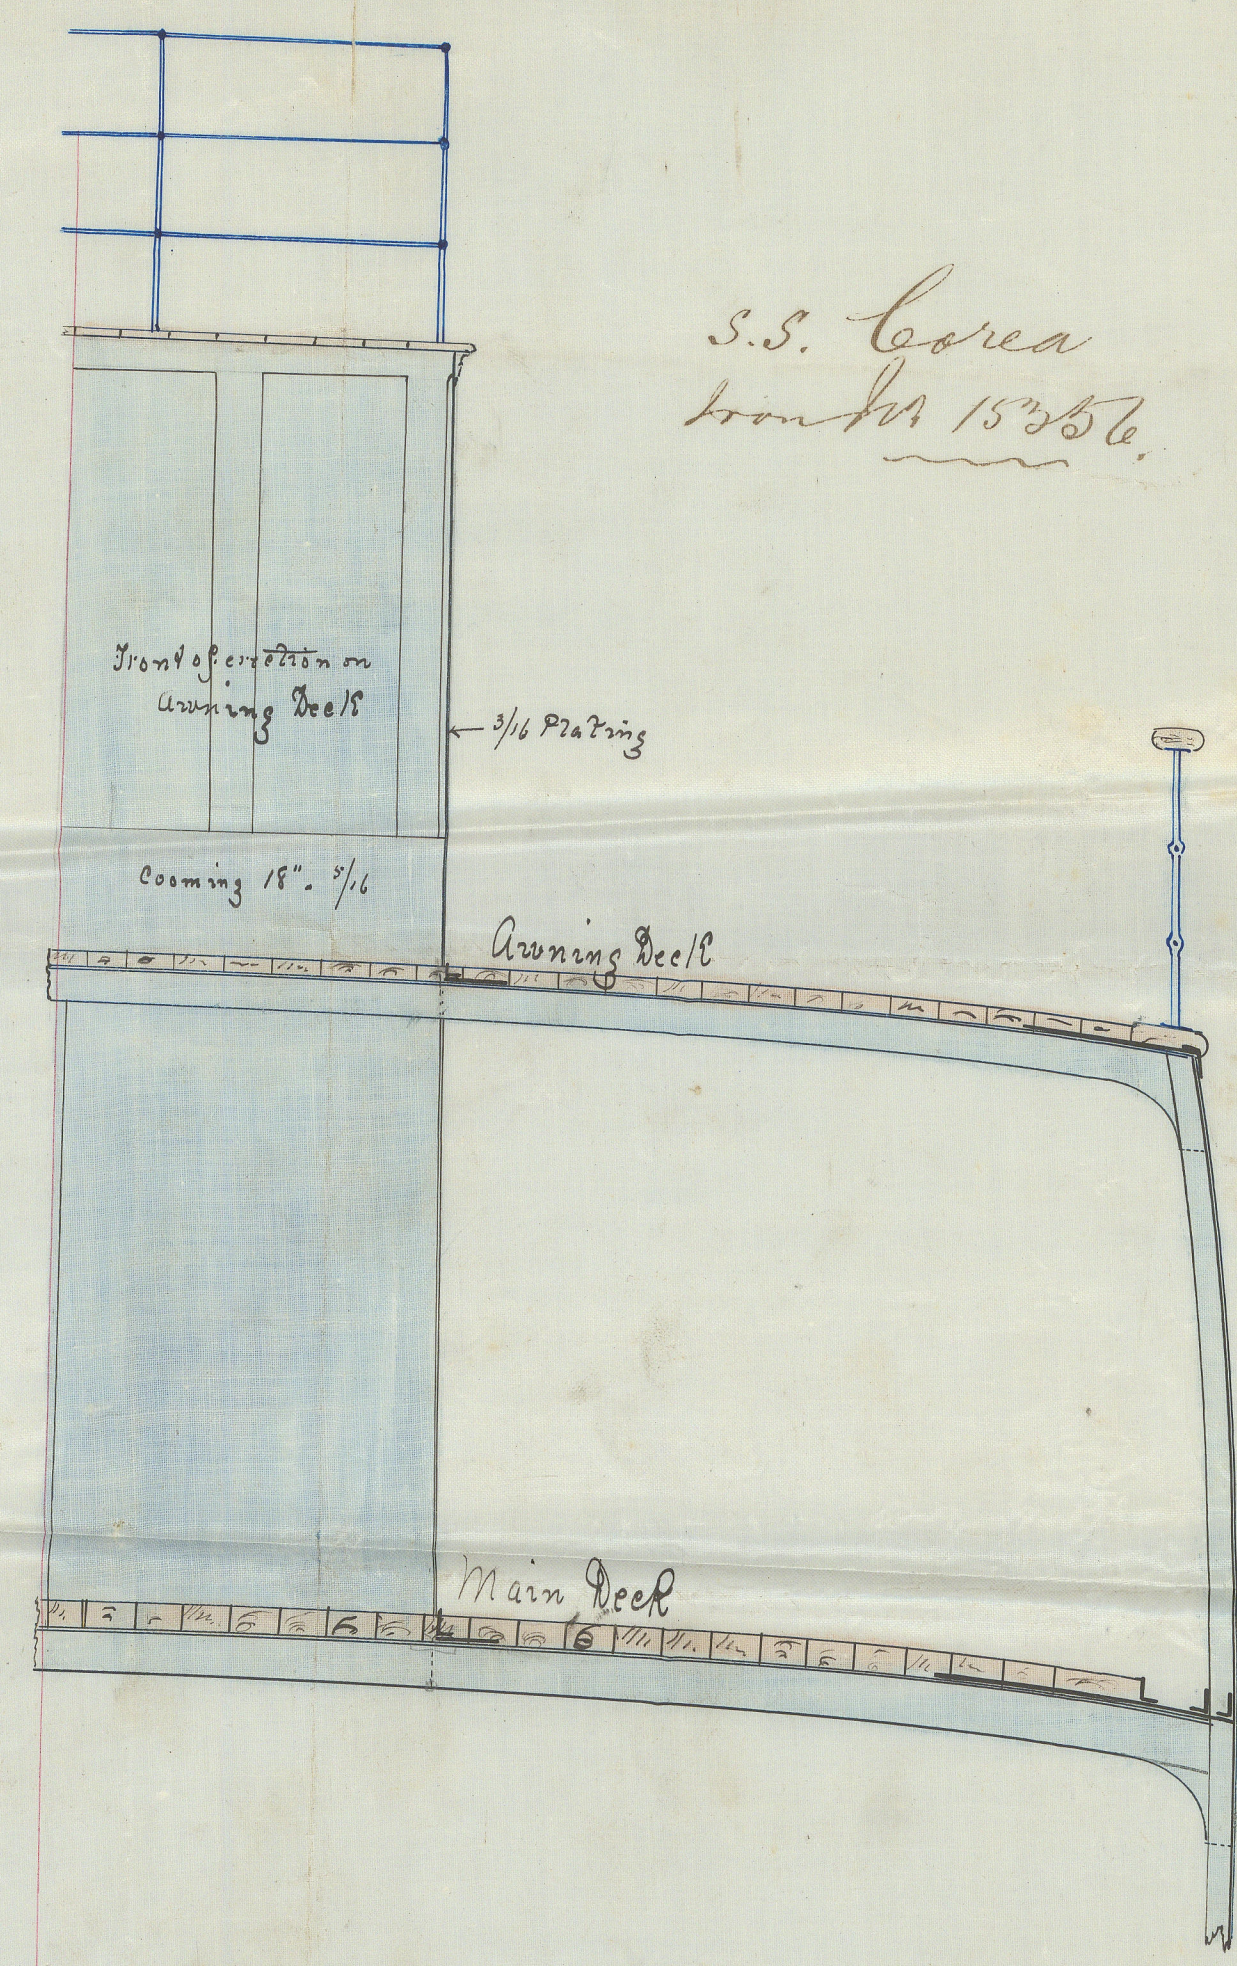

S.S. No 2 Running Decked
Sketch showing proposed erections
above Running Deck
Scale 1/4" = 1 foot
Russell & Co

R.A. Glasgow
7/4/75

MW
22/4/75