

R. M.
30/11/73

"Spar decked" Steam vessel


Proposed to class 100 A 1. Span decked

Half breadth	14.5
St. Girth	25.6
Moulded depth	16.33

Length for rules - 229
12923.47

	FEET	INCHES
LENGTH BETWEEN PERPENDICULARS	230	0
BREADTH MOULDED	29	0
DEPTH TO TOP OF FLOORS	15 ¹ / ₀	8 22 9 ¹ / ₂
TONNAGE B. M.	951 ¹ / ₄	TONS

Rec 2578/15

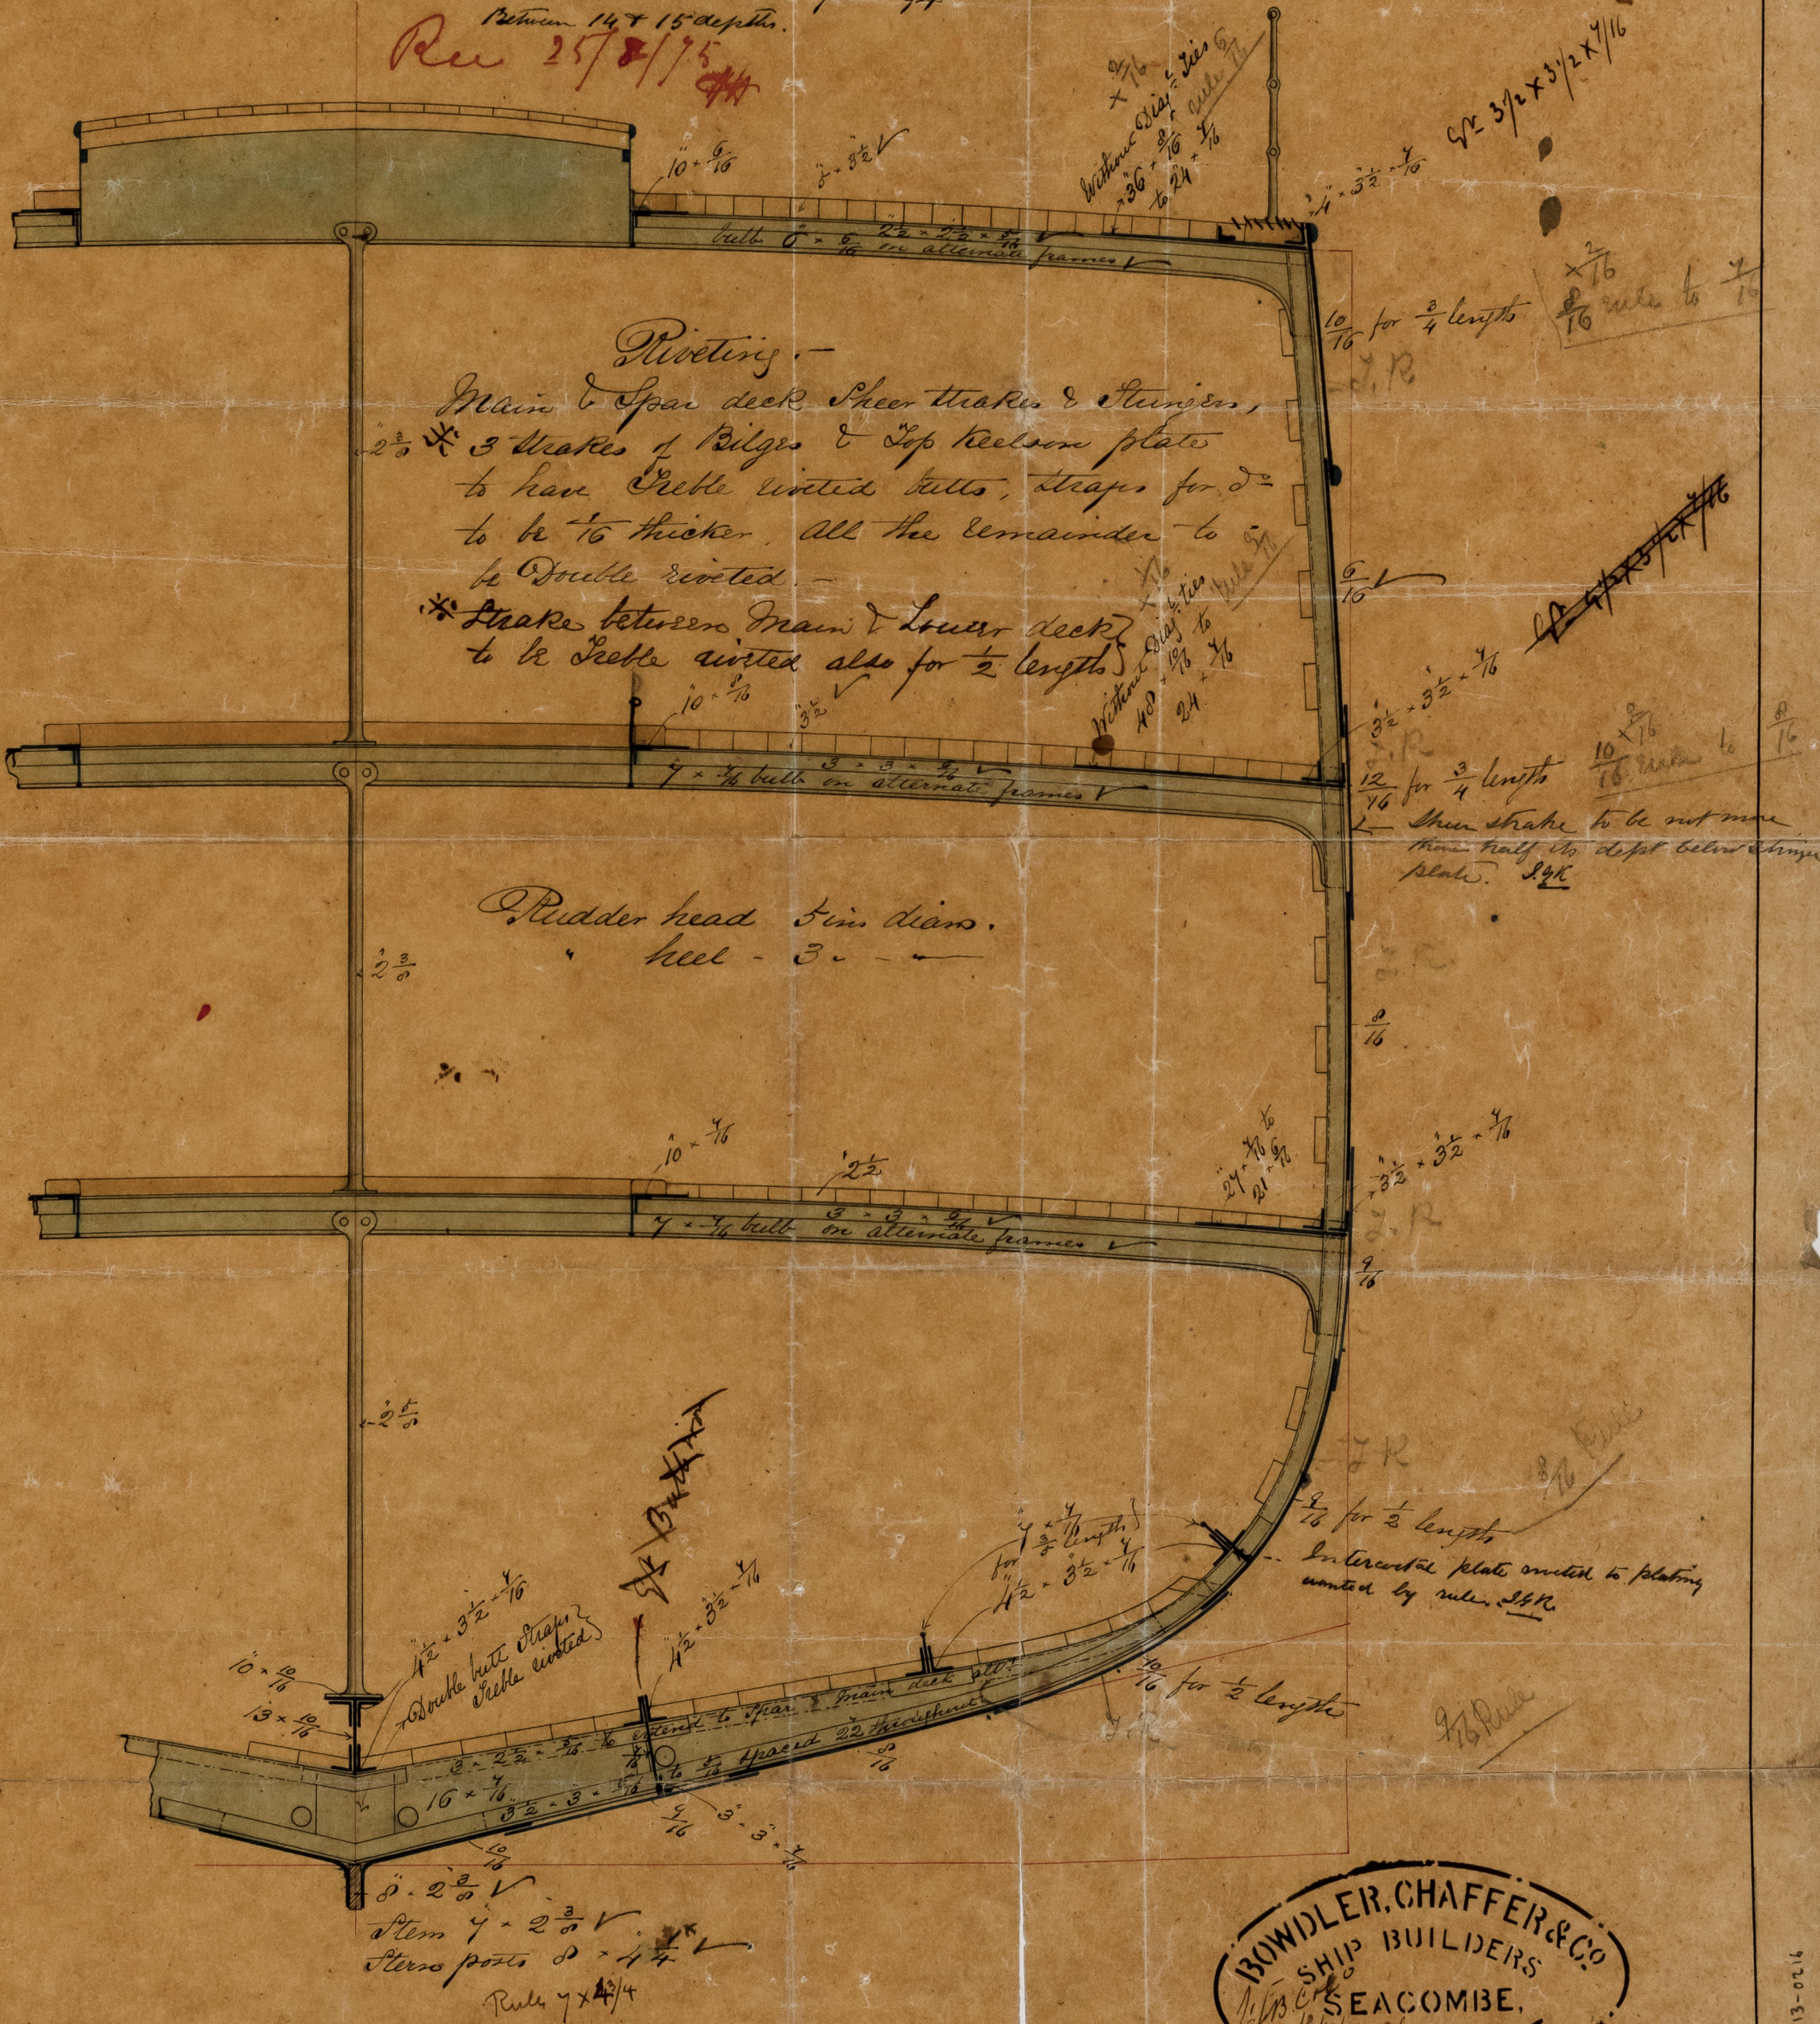

Stem $y \times 2 \frac{3}{4}$ ✓
Stem posts $D \times 4 \frac{1}{4}$ ✓
Ribs $y \times 4 \frac{3}{4}$

9. 7 1/2
12/4/75

BOWDLER, CHAFFER & CO
SHIP BUILDERS
SEACOMBE,
CHESHIRE.

1804513-0216

Lloyd's Register
Foundation