


s/s Dana  
 Iron No 15587

Midship Section of Screw Steamer

$$210 \times 30 \times \frac{22-0}{15-2}$$

Glass Spardecked Steamvessel 90A

Scale  $\frac{1}{2}$  <sup>inch</sup> = 1 Foot

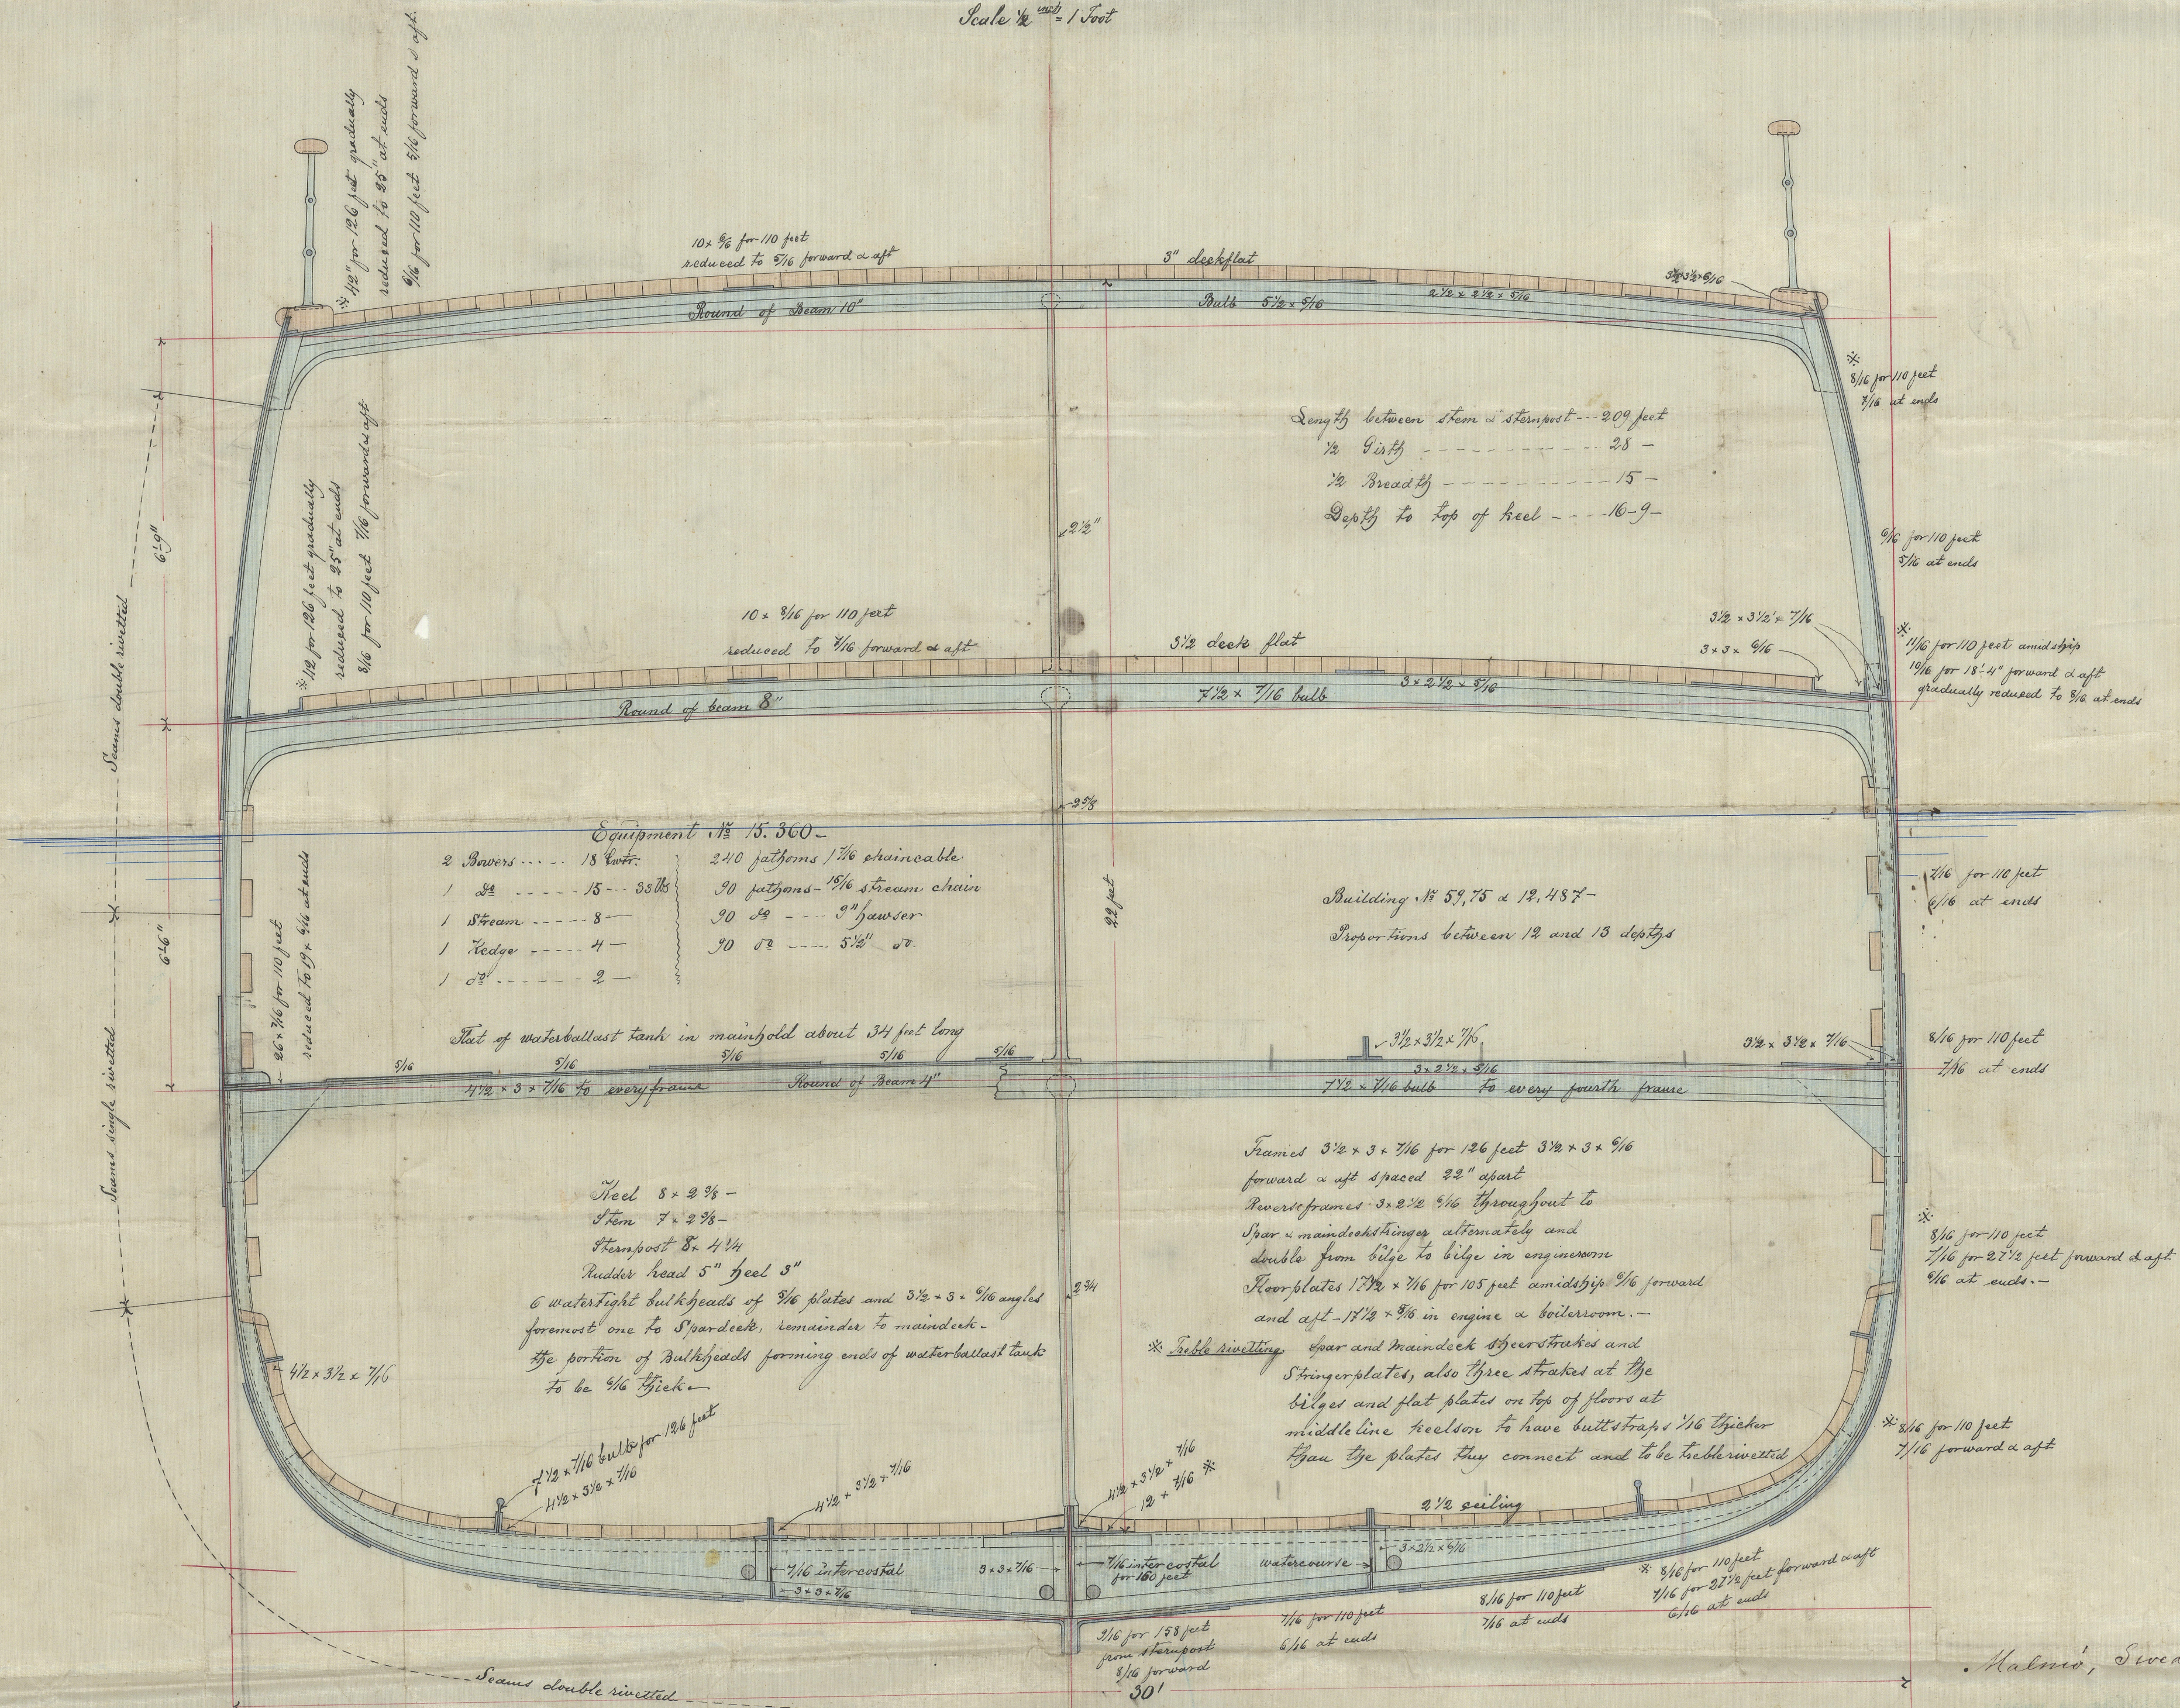


R.M.  
11/5775

11/6/74  
St. J. 11/6/74