


Deck Plan in way of Hatchways.
S.S. No. 22.

S

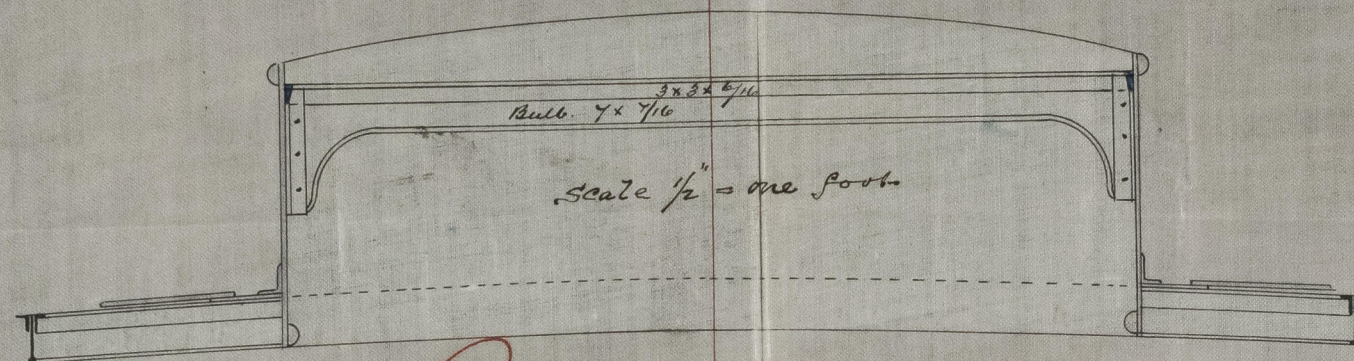

The Goble Engineering
& Ship Building Co. Ltd.
G.O.B.L.

W.B. 1.4.75

Rec 3/4/75
A

Rain Quarter Deck Hatchway.

Scale 1/4" = one foot.

Main Deck.

