

S.S. No 22

Dimensions

Length 270.0

Breadth 37.9

Depth from top Stern 12.6

Scale 1/2" = one foot

To Class 90A


1/2 Breadth 13.102

1/2 Depth 21.2

Depth 13.82

51.9 x 200 = 10350

Per 19/2/75 3/4/75

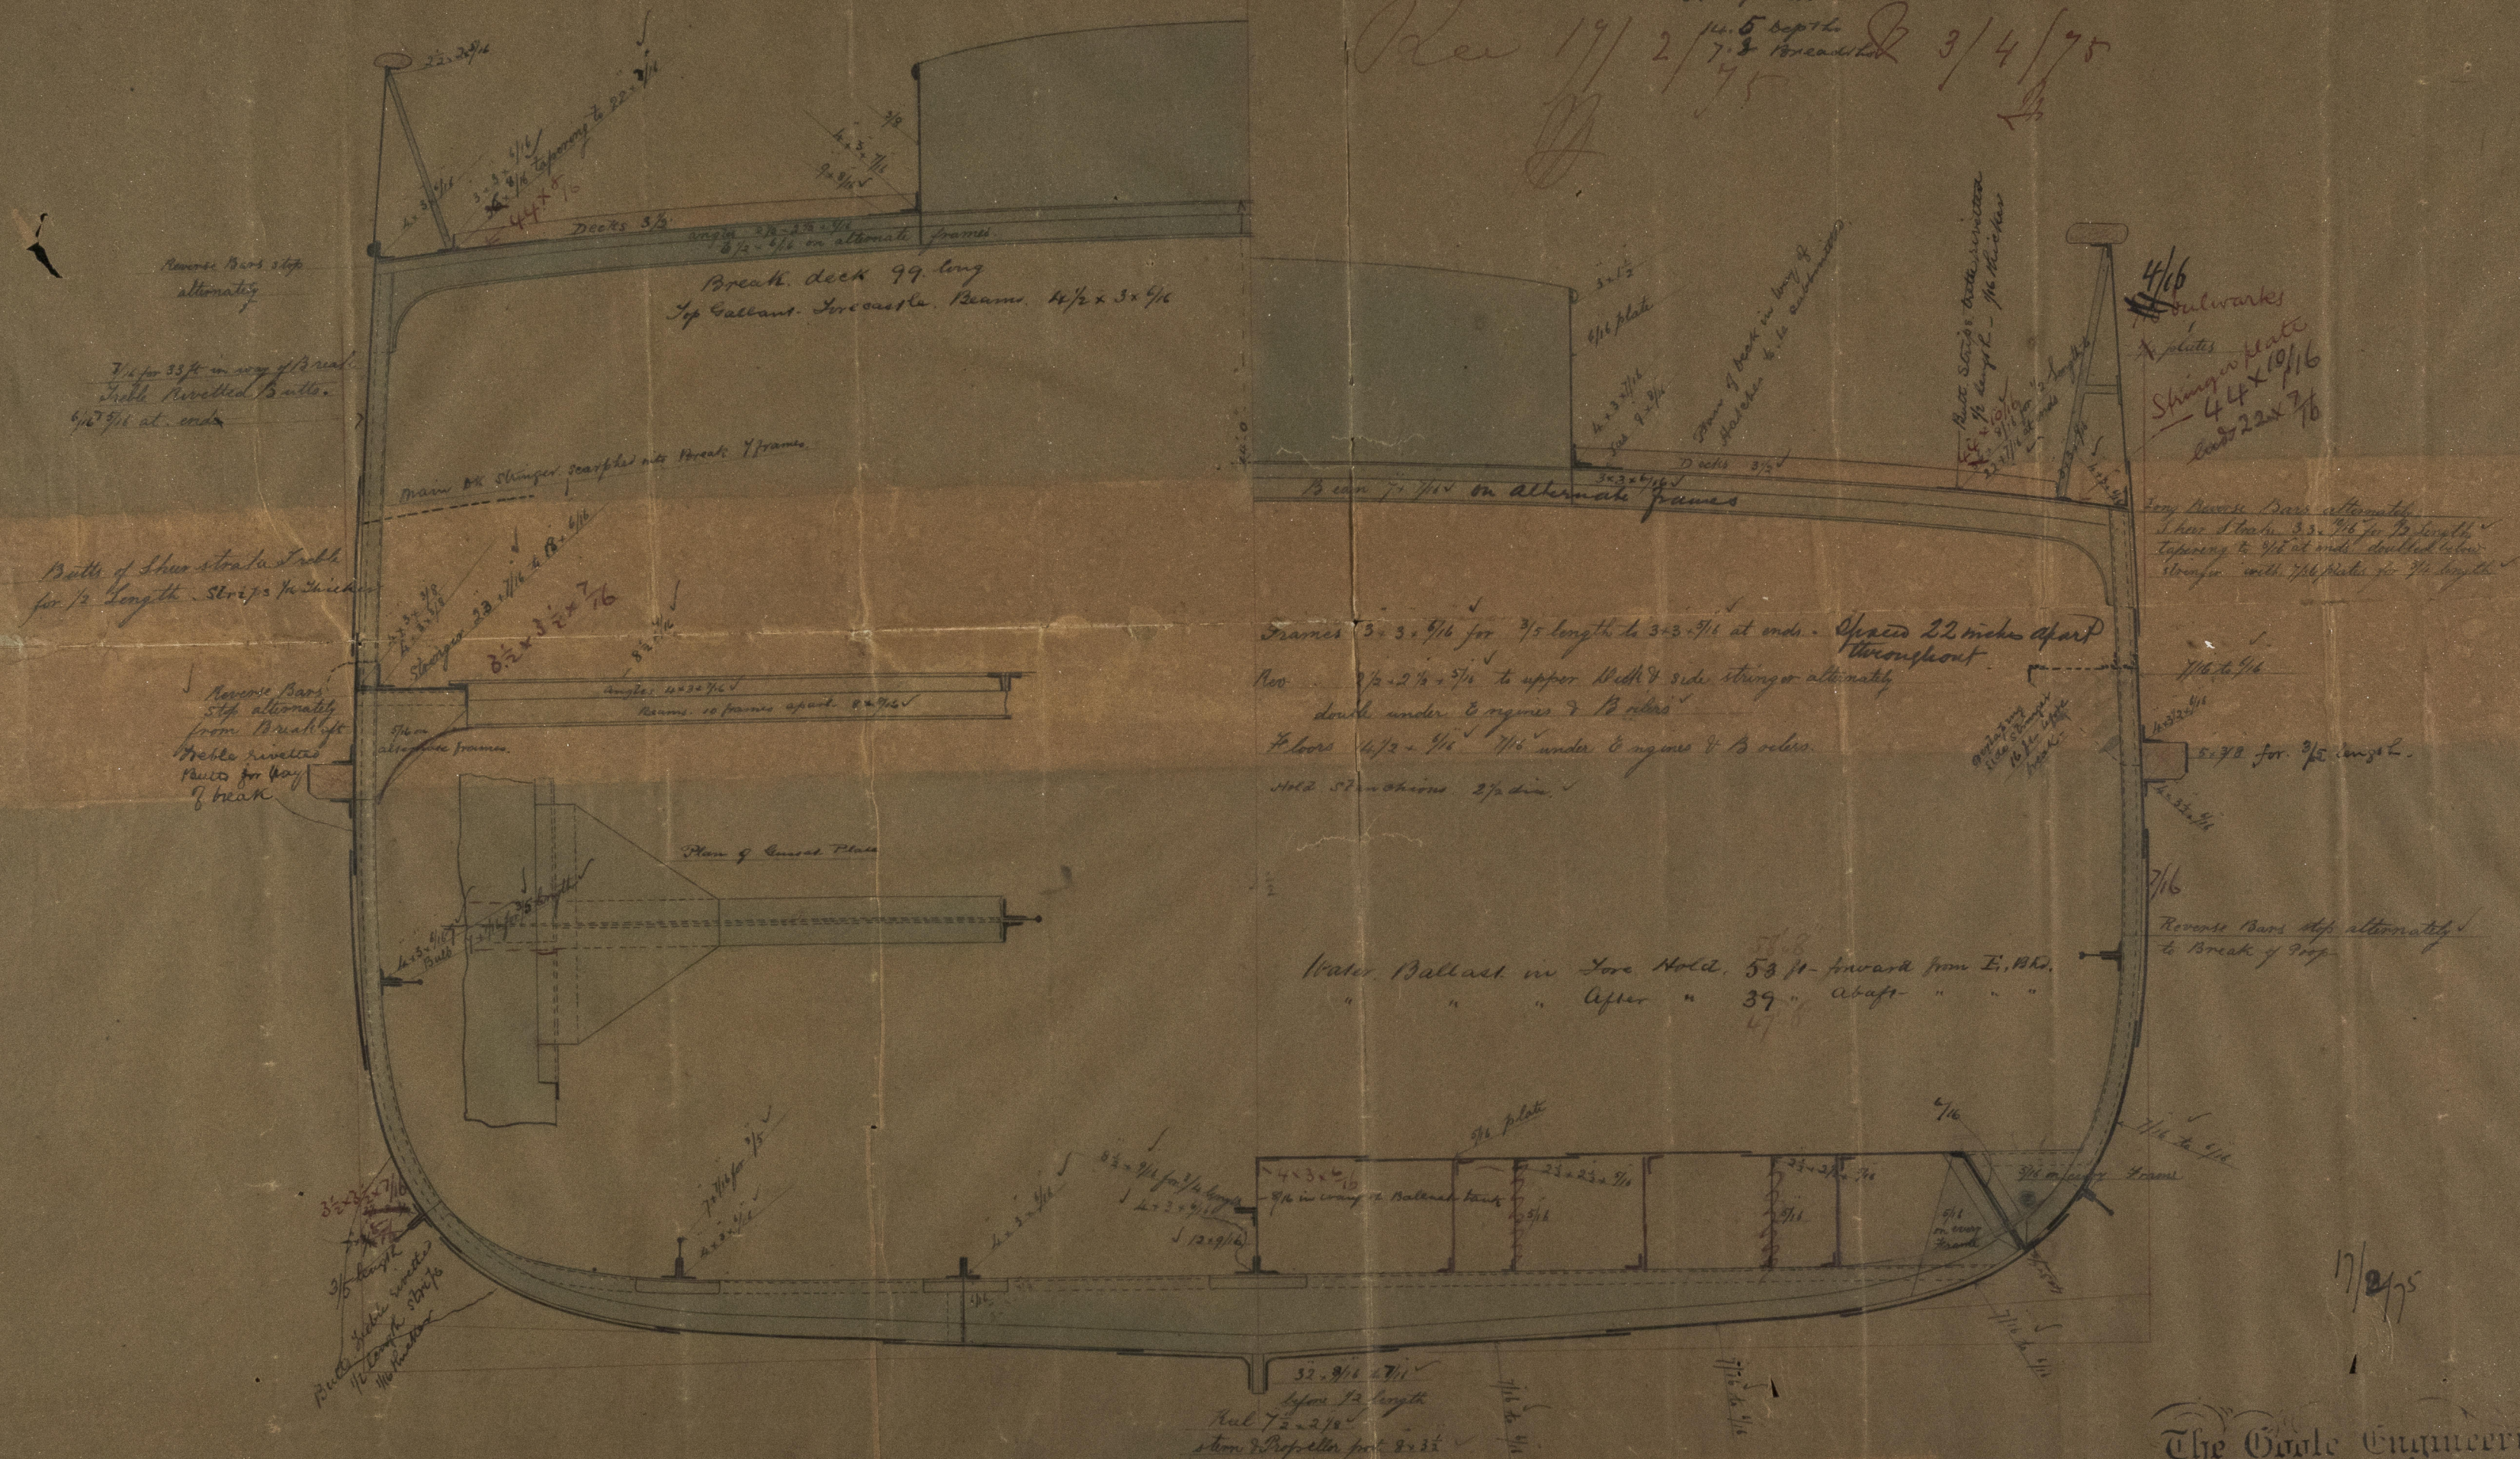

The Gole Engineering & Ship Building Co. Ltd. COOLIDGE