


MIDSHIP SECTION N^o 116

Class 100A

Rec 12/7/75

scale $\frac{1}{2}$ = 1 foot

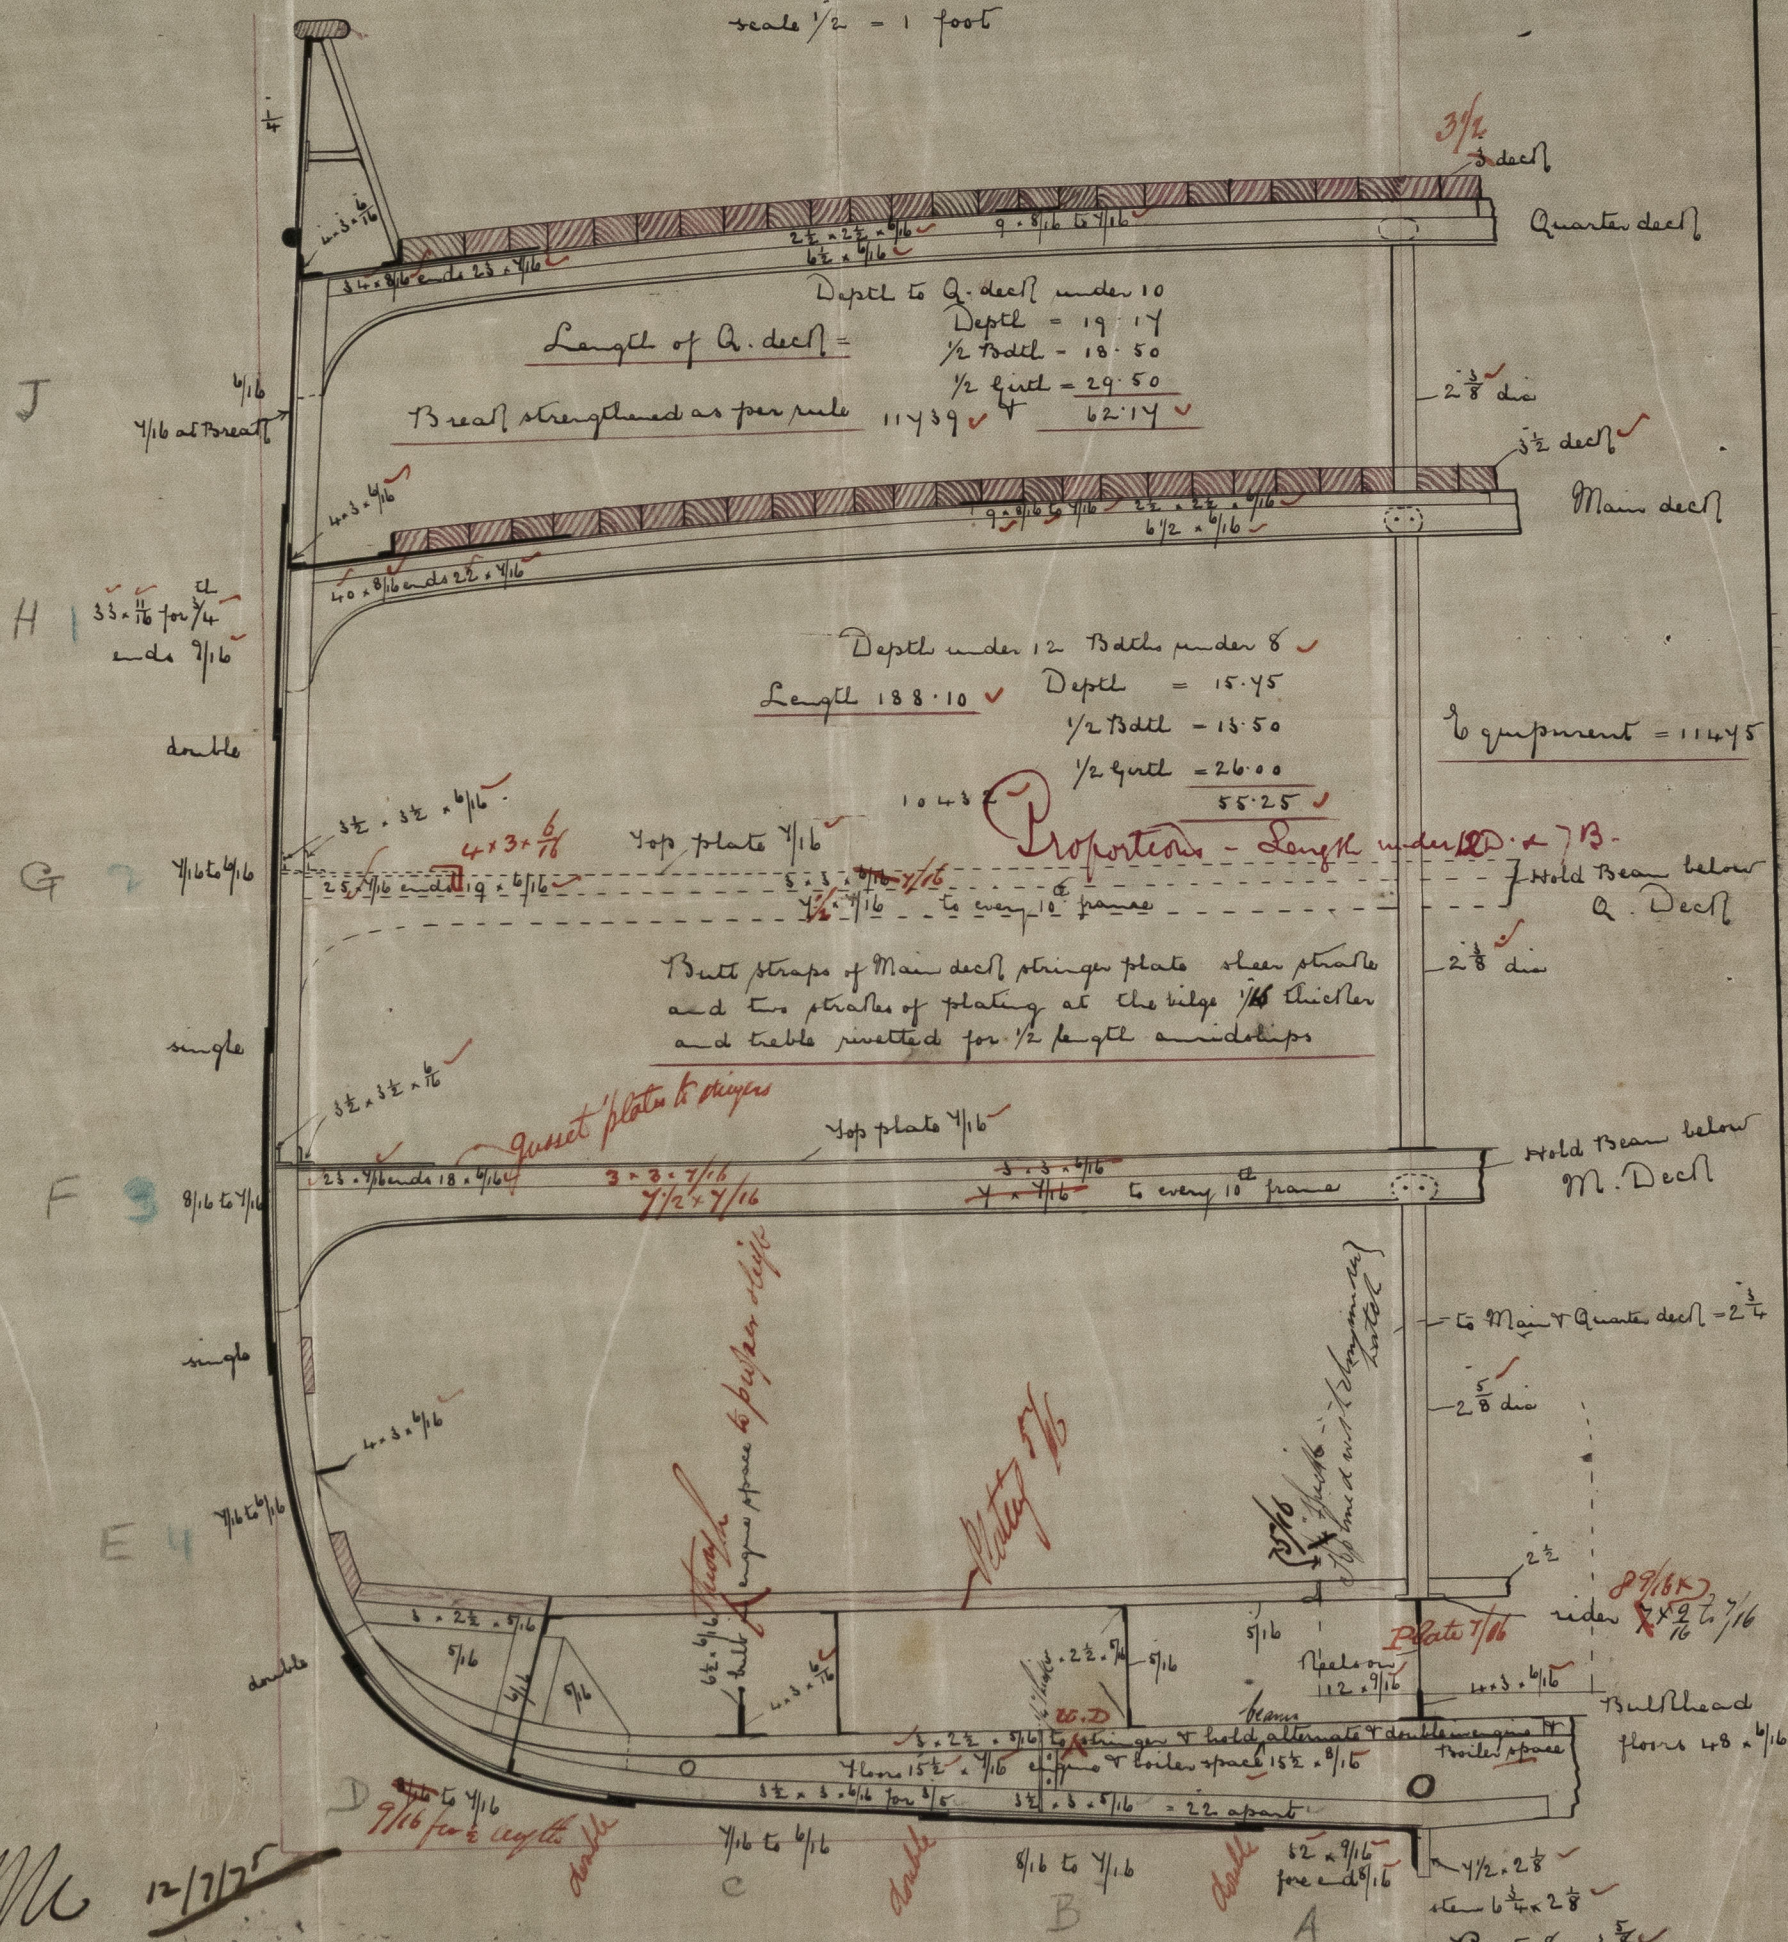

Reverse process to go to upper part of hold beam
Pulley heads $5/16$ thick Rudder head $4\frac{1}{2}$
do hub $2\frac{3}{4}$

Is Tronda (cc Monaco) 7.6 Rpt. Iron N. 15703.

MIDSHIP SECTION



IRONS14-0160



© 2021

Lloyd's Register
Foundation