

# Section of Masts and Yards

No 23

## Fore & Main Masts


Fore Mast overall 83'-0"

Main " " 84'-6"

### Bowsprit

Length overall 34'-0"

Longitudinal joints single rivetted

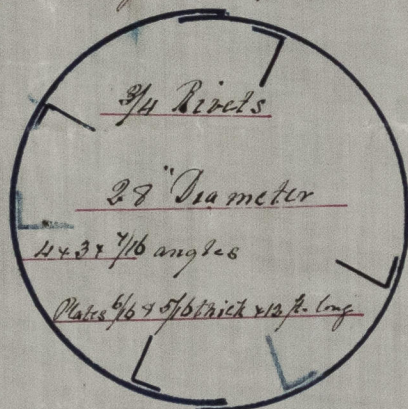


Buttstraps double rivetted

Doubling plate at knighthead 6 ft long

### Fore & Main Yards

Length overall 75'-0"


Longitudinal joints single rivetted

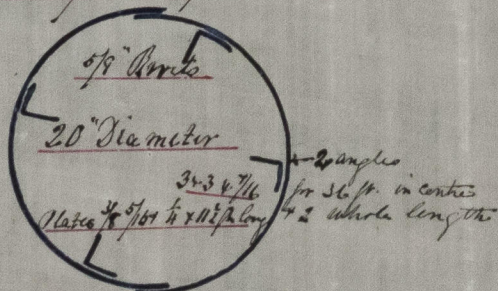

Doubling plate in center 6 ft long

Buttstraps double rivetted

Longitudinal Joints single rivetted

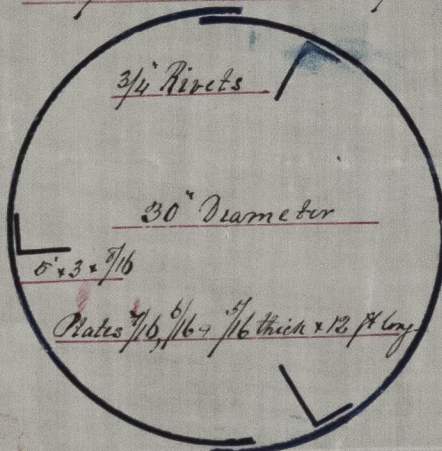


4 Buttstraps at Deck Table rivetted

Remainder double rivetted

### Mizen Mast

Length overall 75'-9"

Longitudinal joints single rivetted

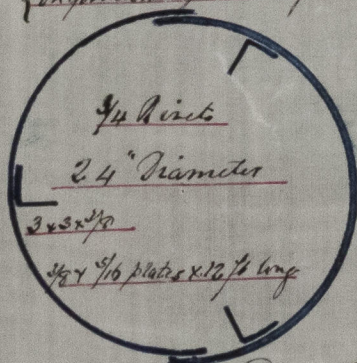


4 Buttstraps at Deck Table rivetted

Remainder double rivetted

## Fore & Main Lower Topsail Yards

Length Overall 71'-0"

Longitudinal joints single rivetted

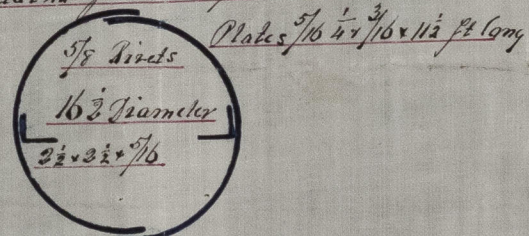


Doubling plate in center 6 ft long

Buttstraps double rivetted

### Cross Jack Yard

Length overall 62'-0"

Longitudinal joints single rivetted

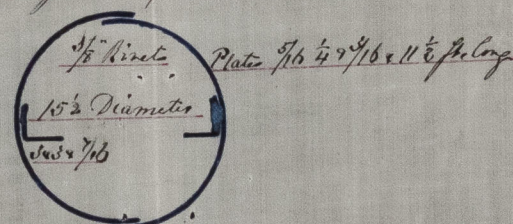


Doubling plate in center 6 ft long

Buttstraps double rivetted

## Mizen Lower Topsail Yard

Length overall 52'-0"

Longitudinal joints single rivetted

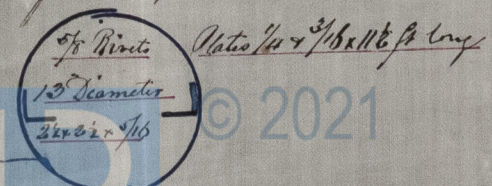

Doubling plate in center 6 ft long

Buttstraps double rivetted

Exd. J. W. M.

Plates from Consett Iron Coy.

Angles from Stockton Iron Coy.

© 2021

Foundation