

Parque Guetheryn Castle Report No 11.332

100 A


SCALE $\frac{1}{2}$ IN" = 1 FOOT

NUMERALS 6868 & 12362.40

 68.68
 180
 540 440
 68.68
 123 62.40

Under 6 breadths & 10 Depths in length ✓

Rec 20/7/75
H

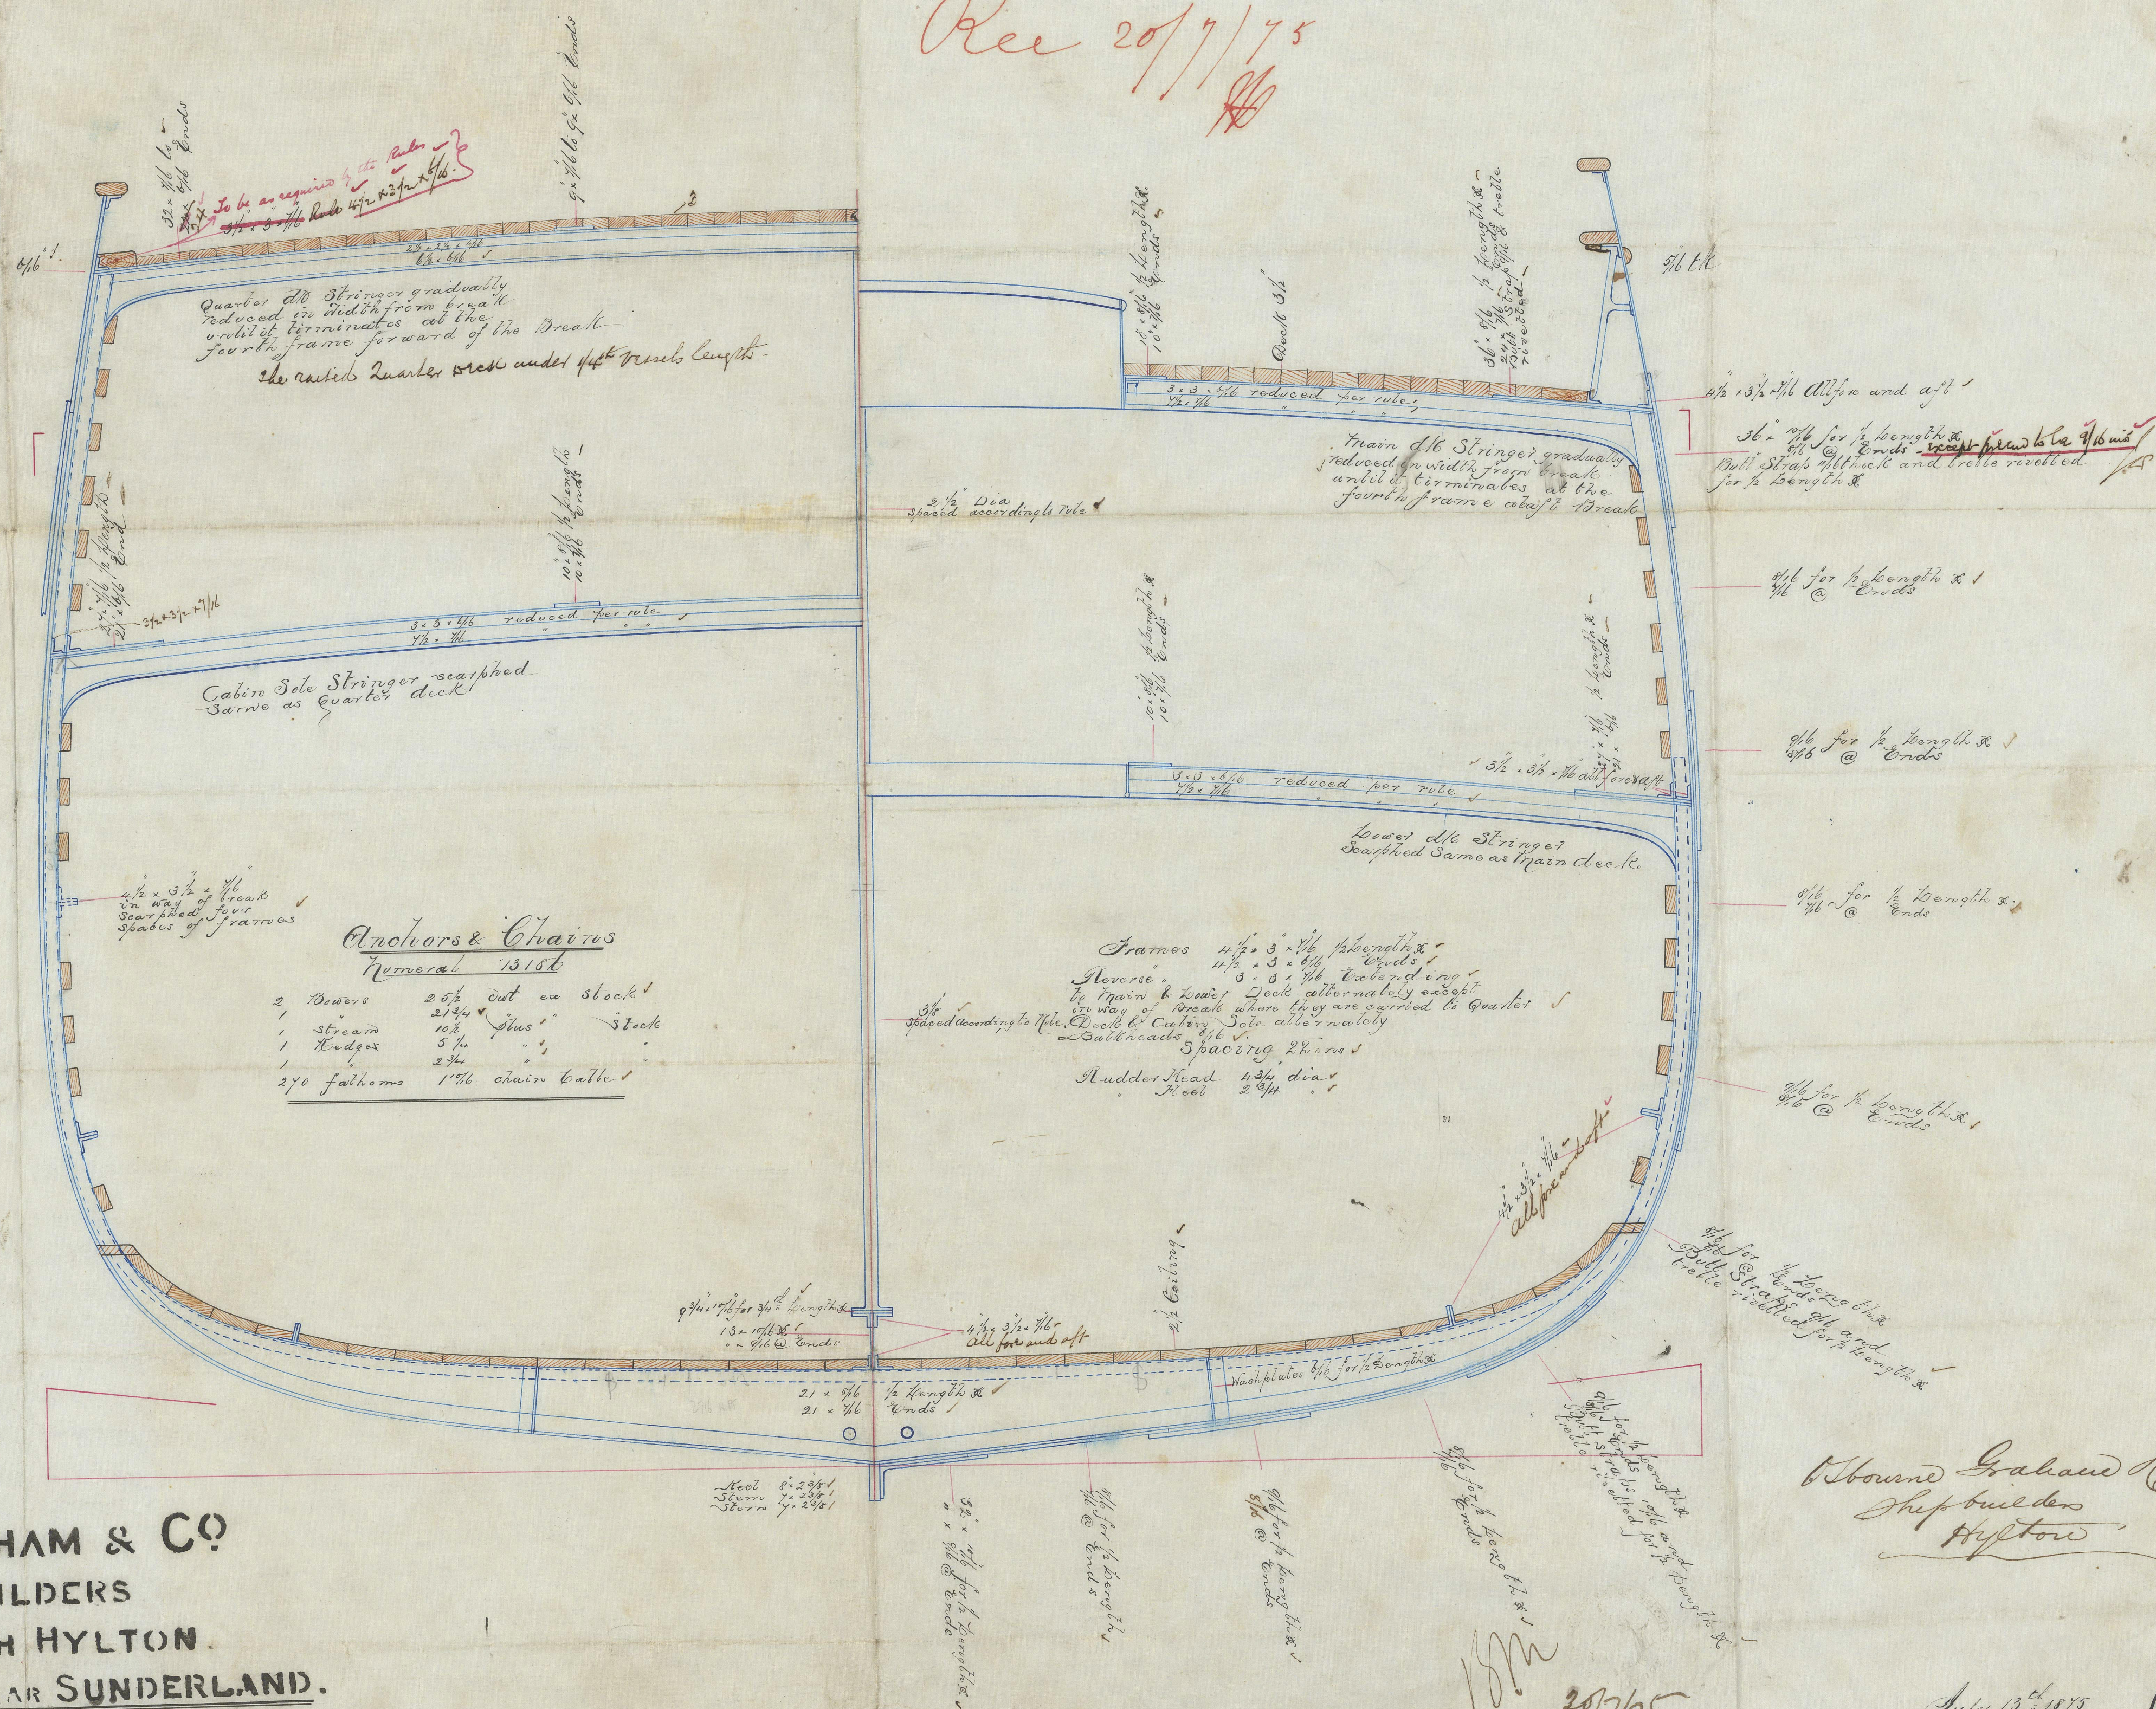

OSBOURNE, GRAHAM & CO
IRON SHIPBUILDERS
NORTH HYLTON.
NEAR SUNDERLAND.

Shipbuilders
Hylton

July 13th 1873