



"Morale Moro" Port No 13080.

27/4/75
C. S. SWAN & CO


Iron Shipbuilders
WALLSEND
NEWCASTLE-TYNE
April 22nd 1875

S. S. No 21

Scale $\frac{1}{2}$ INCH = 1 FOOT

8.04 Breadths
10.1 " depth to upper deck
13.91 " " main "

$14 \times 9/16$ to $8/16$
10 diagonals

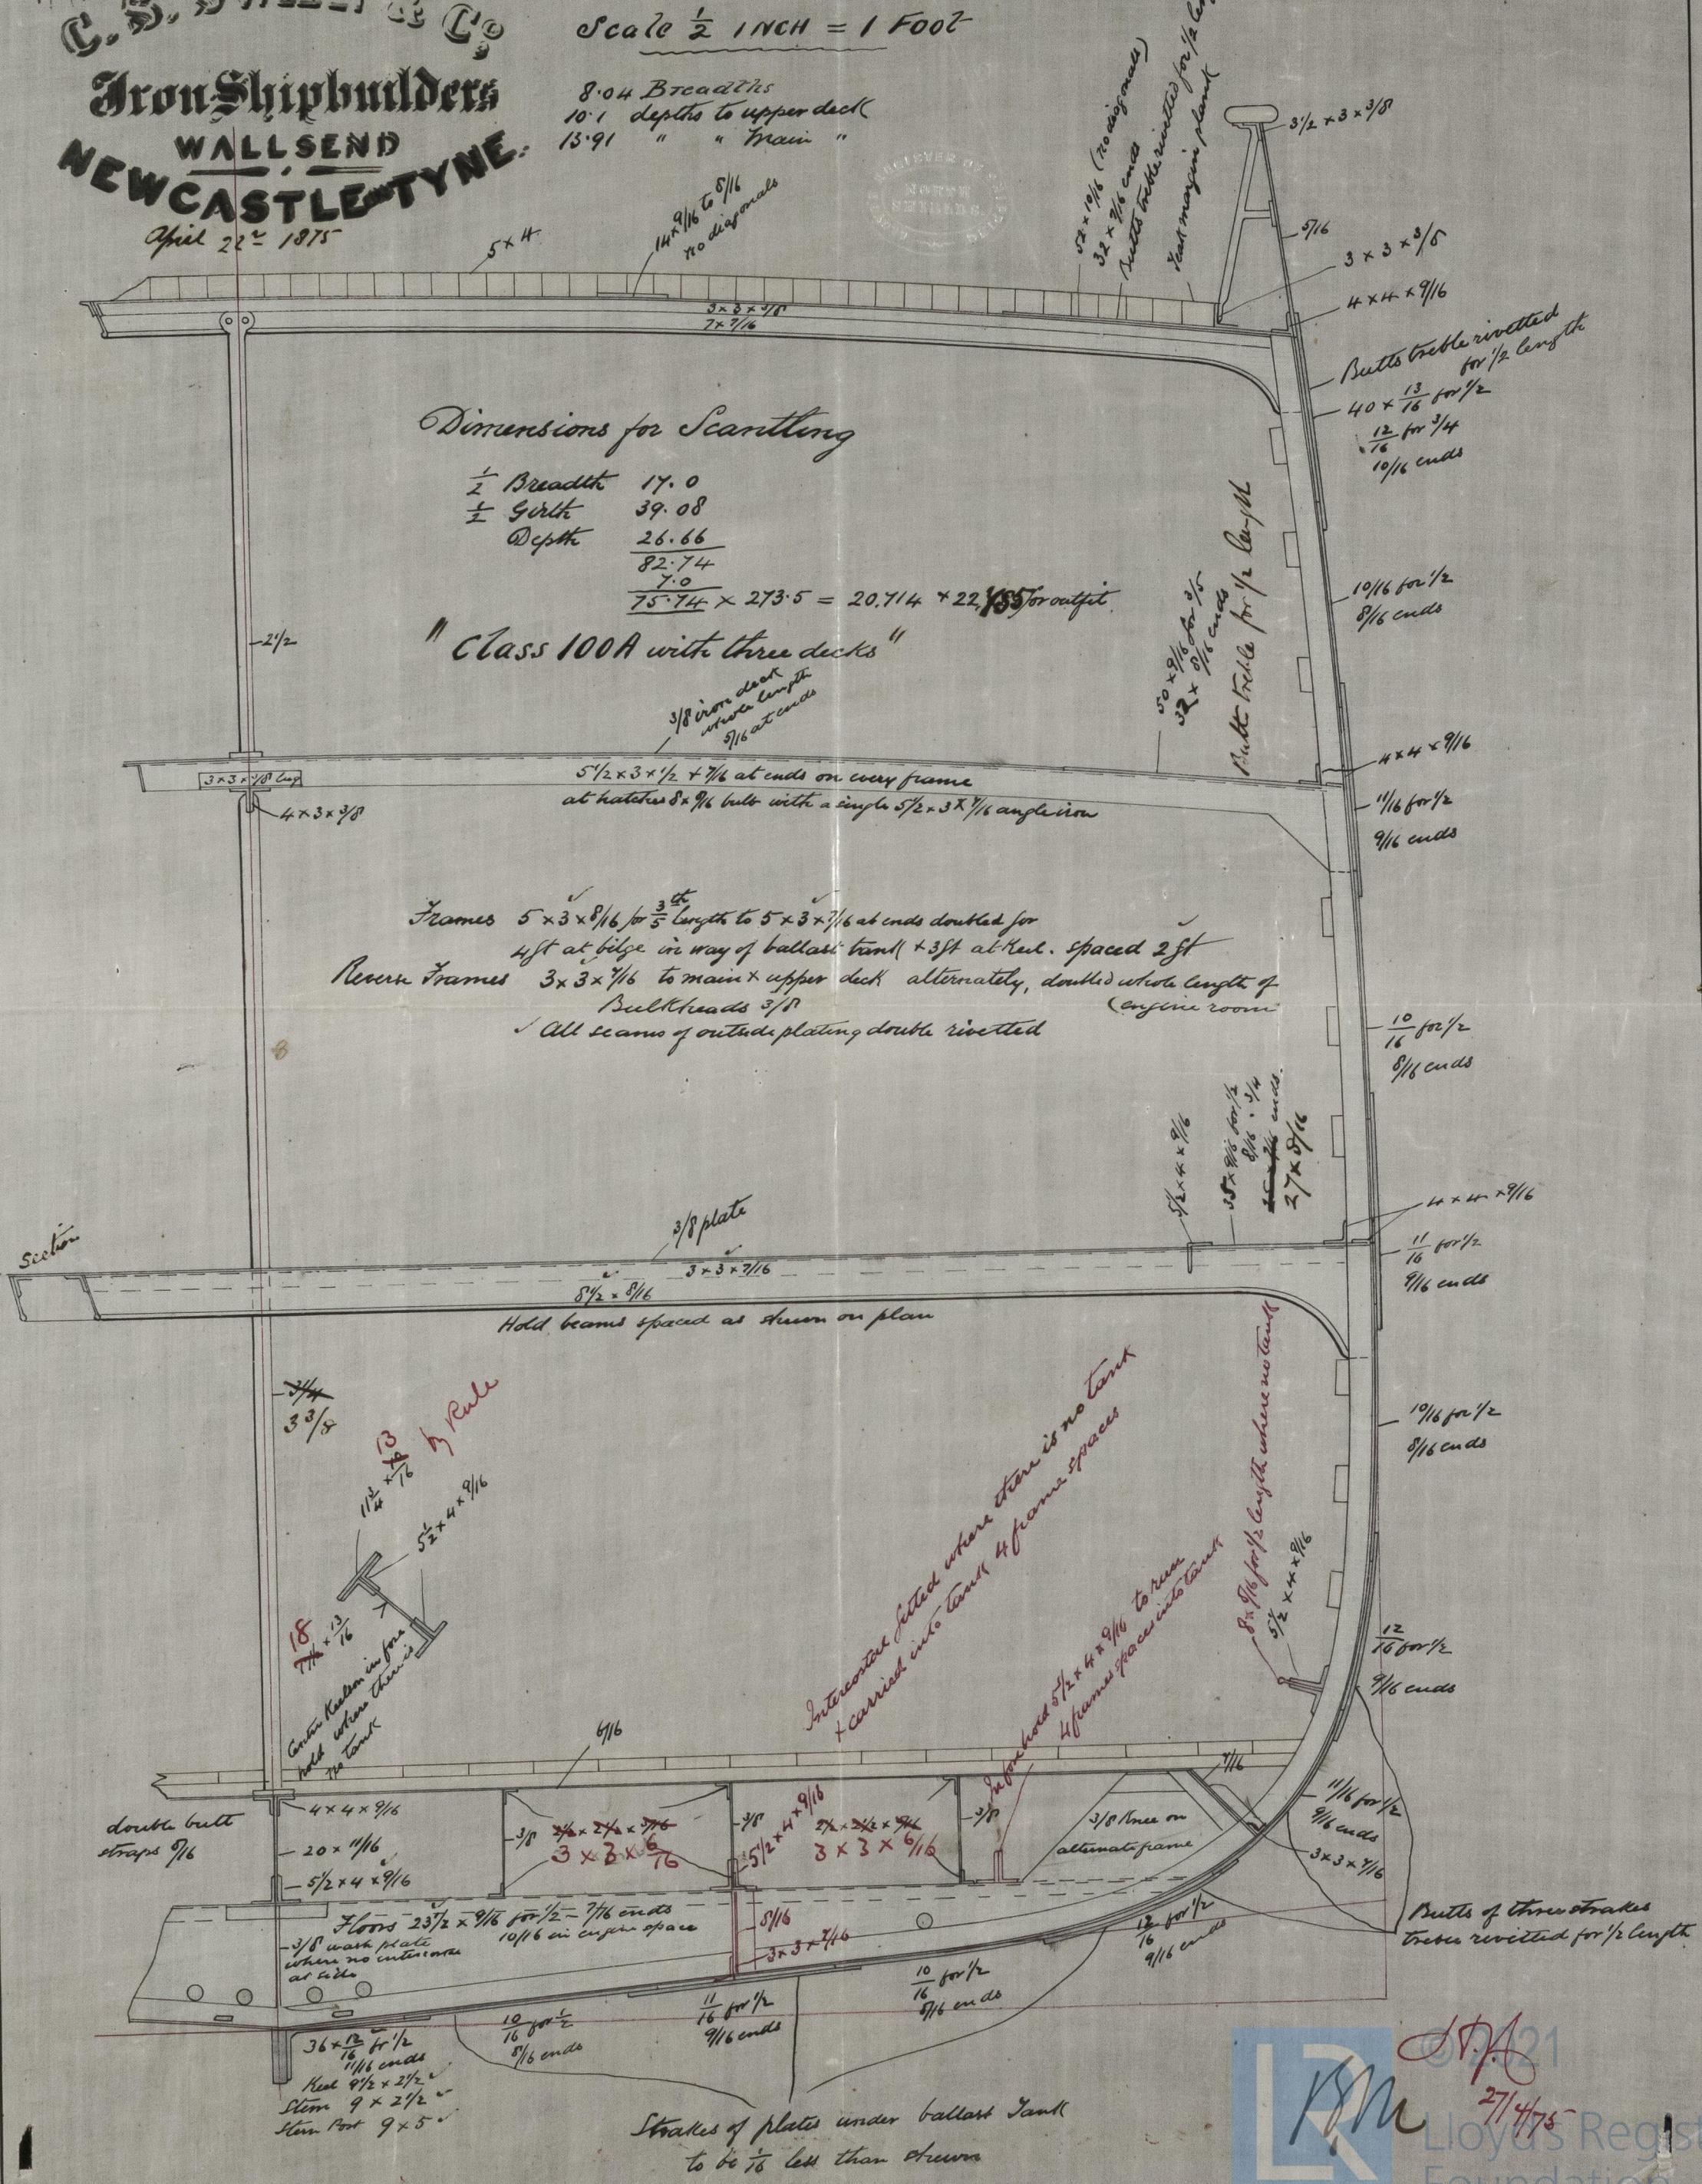

27/4/75
S.A.21

27/4/75-

Lloyd's Register
Foundation

IRONS14-0204