


Step for Mainmast.

of

Nº 145.S.S.

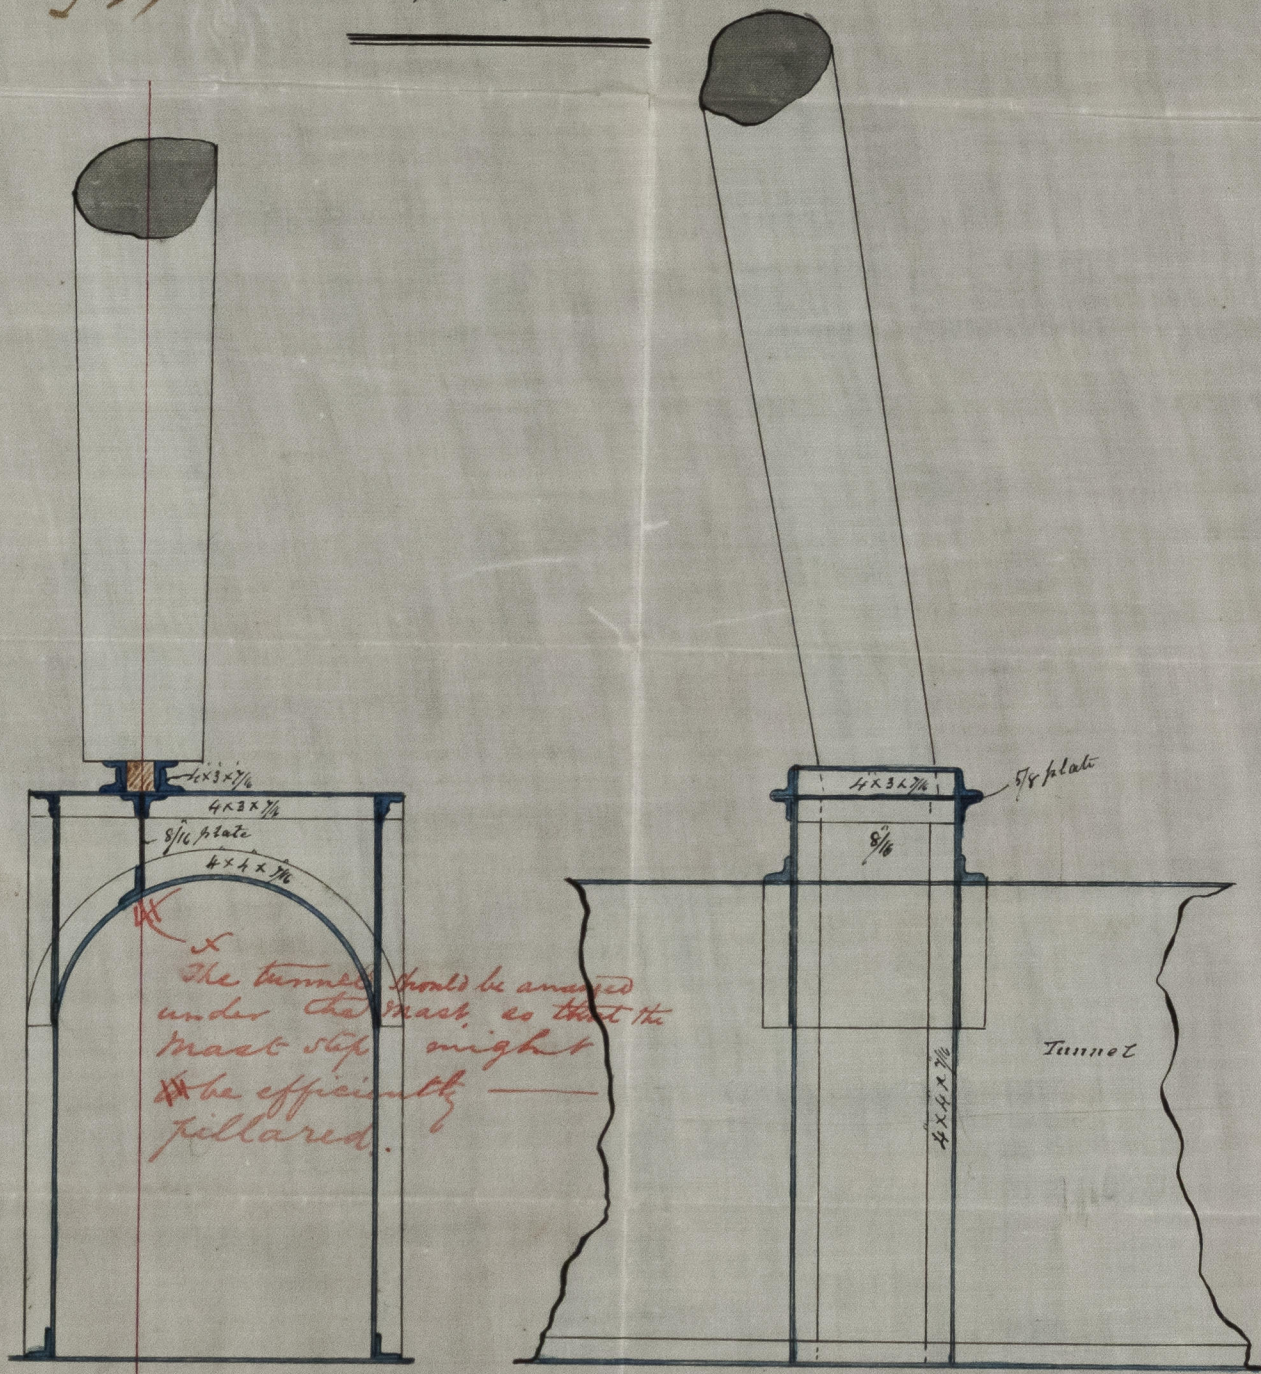

Scale 1/2 Inch = 1 Foot.



© 2021

Lloyd's Register
Foundation

IRON 514-0223