

Copy of Plans

3578


Plan of Hatchways &c

of
No. 145. S. S.


Scale $\frac{1}{4}$ = 1 Foot

Main Deck Beams.

Re 10/8/73
H

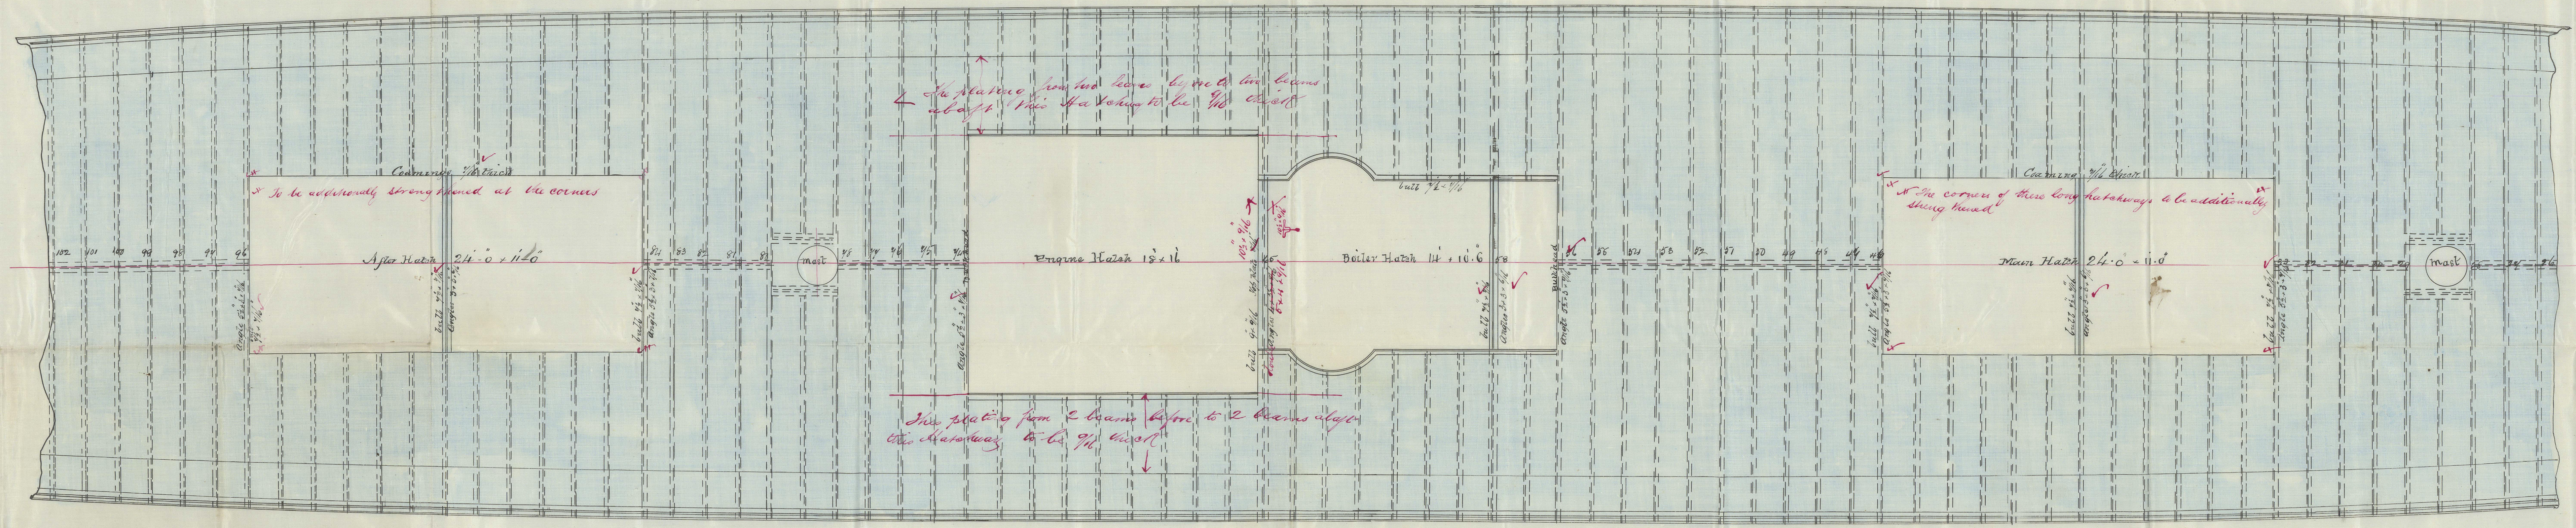

Hold Beams

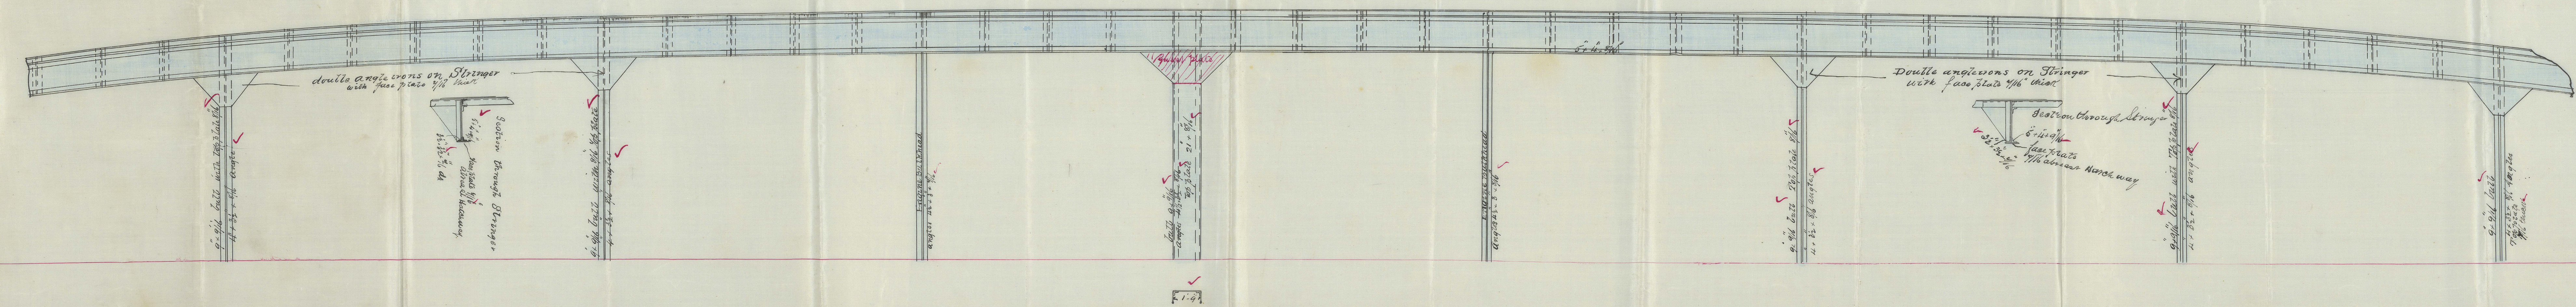

July 31st 1875
11/875
H