

REARSE & CO.
IRON CASTING
WORKS
LONDON
STATIONERS' HALL
LONDON
PRINTED ON THE


COMPENSATION FOR UPPER DECK HATCHWAYS

3548

FOR
No 145 SS

Rec 10/8/75
D

Scale 1/2 Inch to one Foot

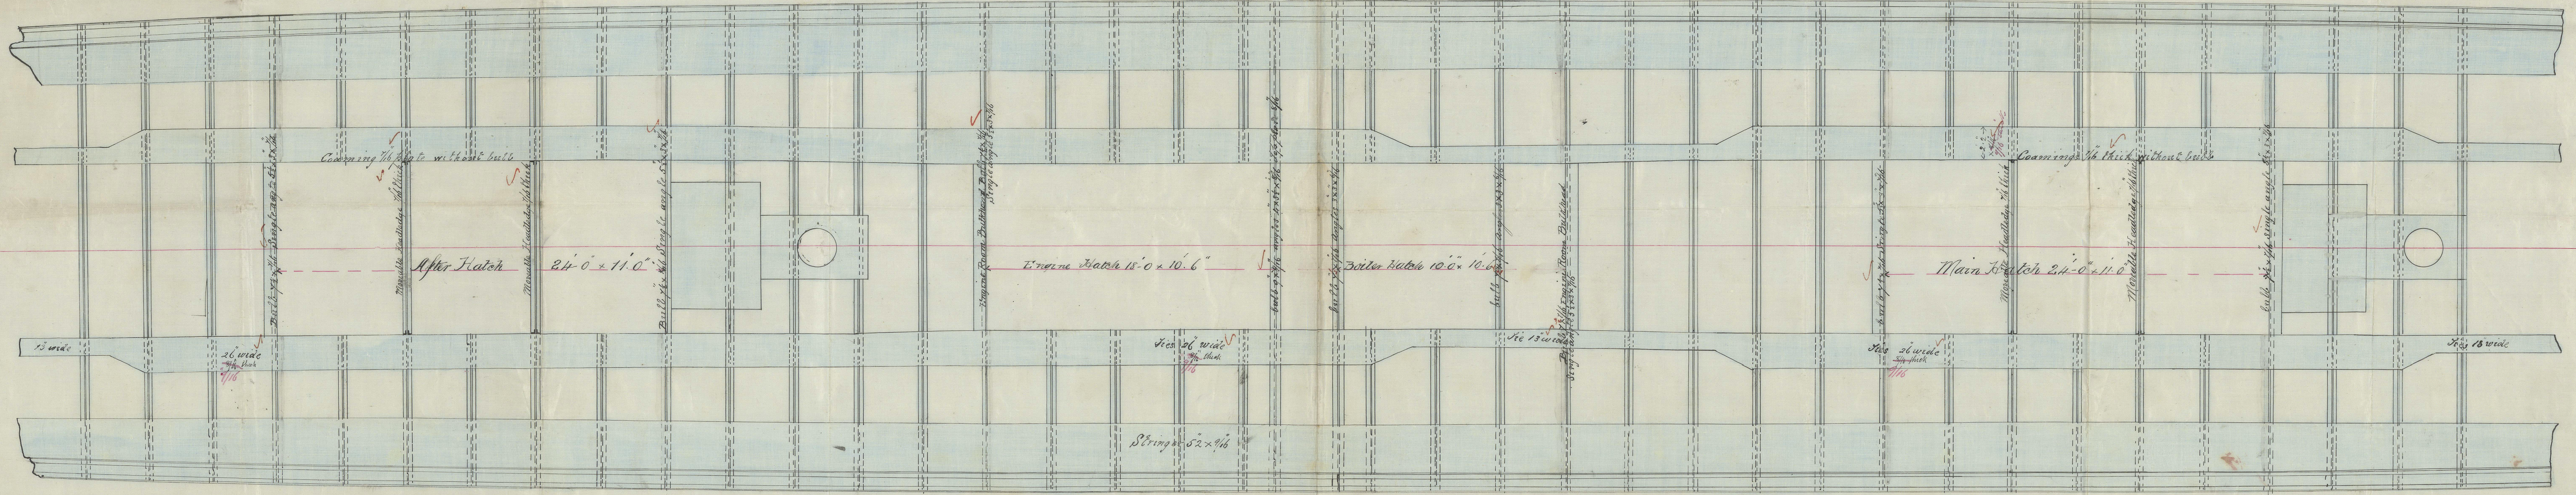

18M
11/8/75

July 20 2021
R
17M
2/10/76's Register
Foundation

IRON 514-0228